

— PROFILE No 188 —


LENGTH B.P. — 205' —

BREADTH MLD — 28' 9"



DEPTH MLD — 13' 2"

Class 100 A.1. Lloyd's & a Collier

Scale 1/8" = 1 foot.

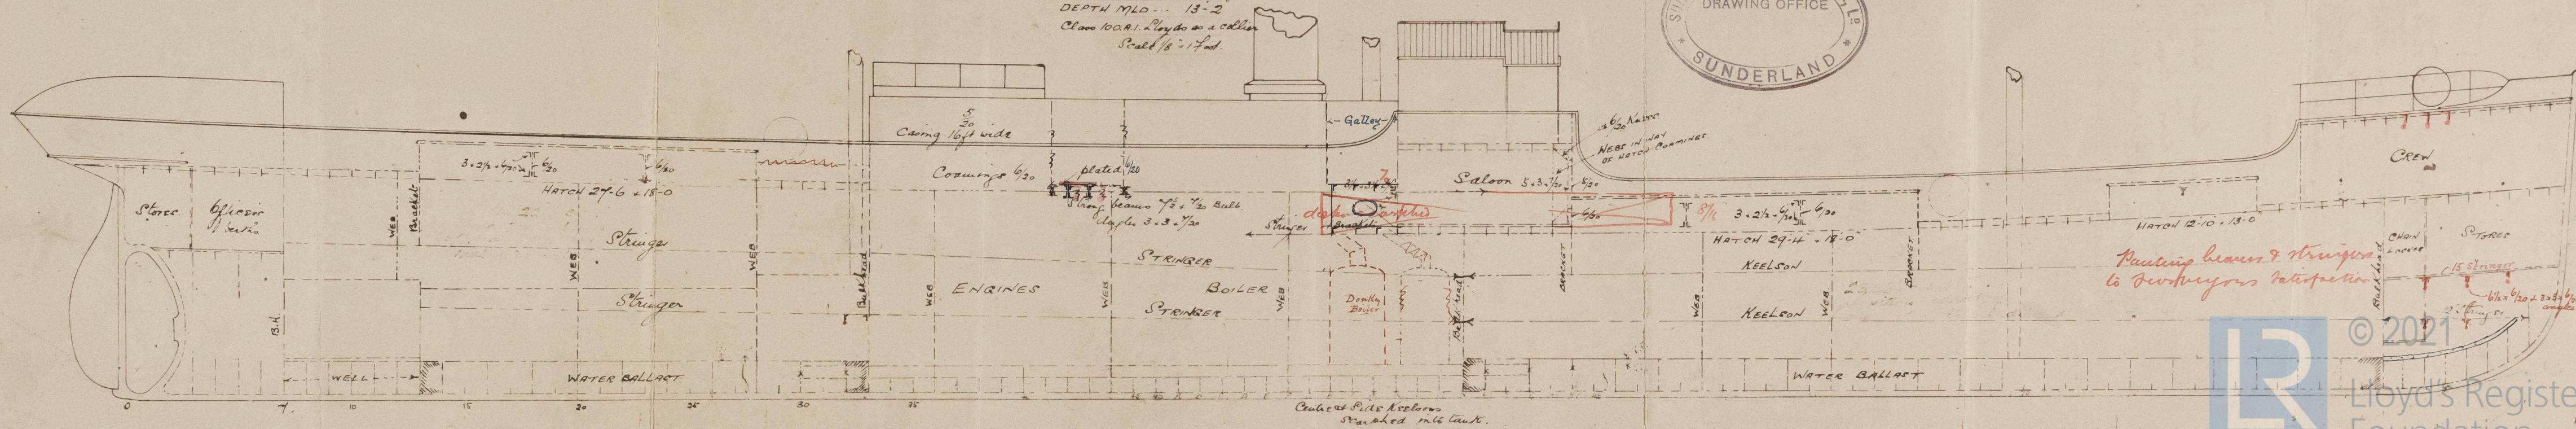

SLD1004-0152

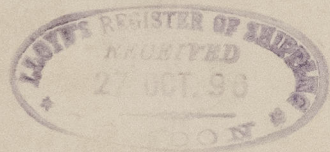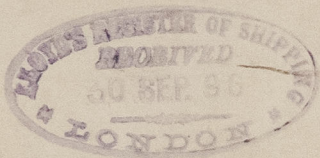

Sunderland S N Co

- No 188 -

Profile

- copy of original.

S.S. Norman

SUNDERLAND, No. 18527

SLD1004 - 0152



© 2021

Lloyd's Register
Foundation