


Nº 188 SS

scale $\frac{1}{4}'' = 1$ foot

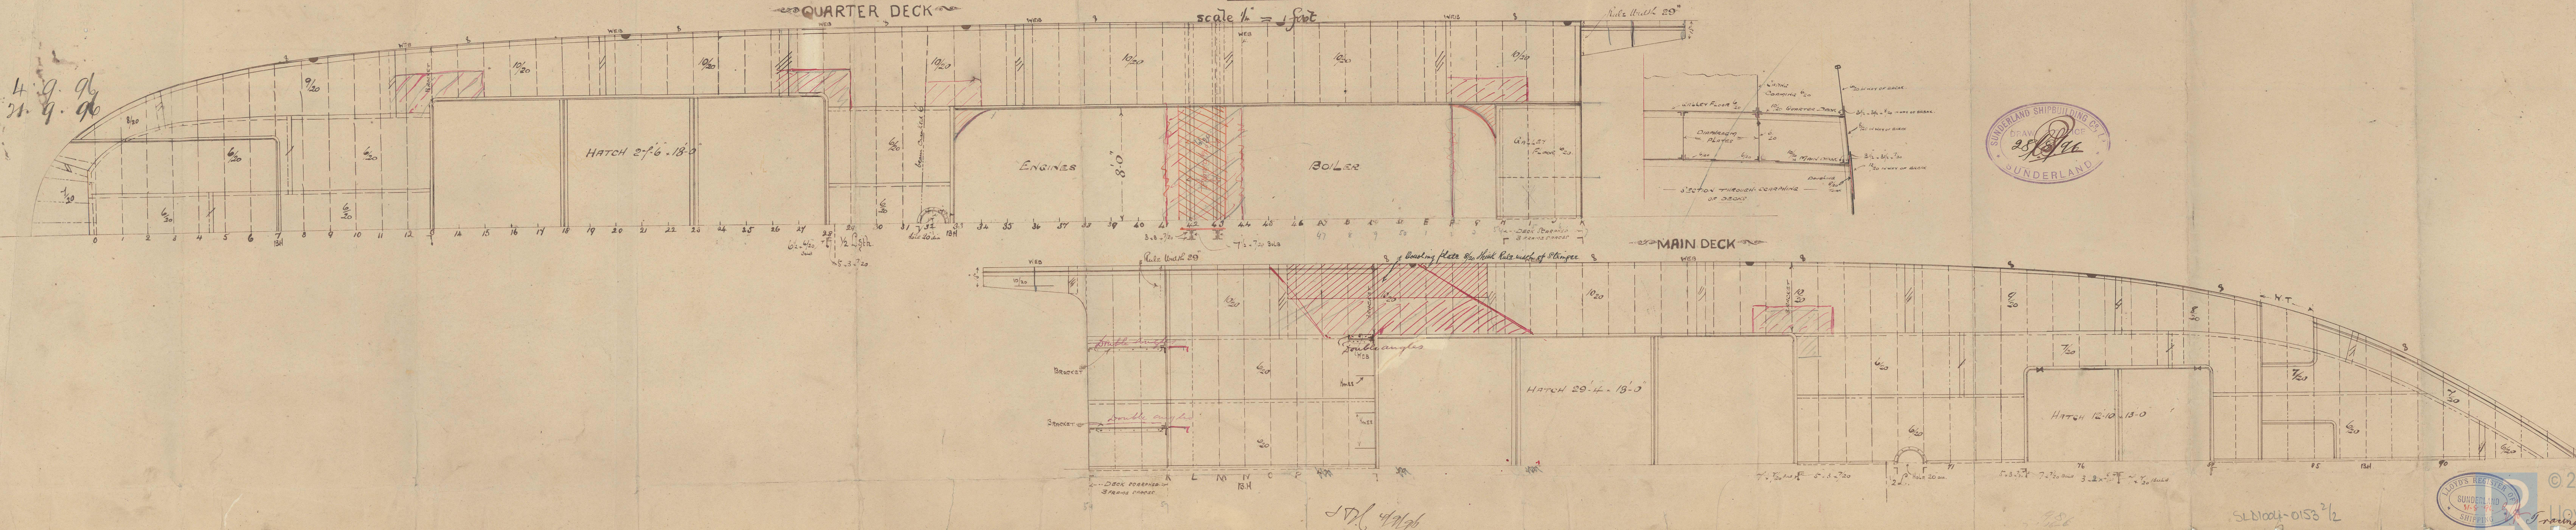

SLD1004-01531/2

No. 1887.

Enclose to Messrs

Lloyd's Surveyors
for approval

Date, 28/8/26

20280

205
1.20
203.80

58
198
158
990
1184

1475

16-71
15-61

1475
62
1537
13

4601
1537
19981



198

SUNDERLAND S.B. Co.

- S. S. 188 -

- DECK PLAN -

S. S. Norman
SUNDERLAND. No. 18527

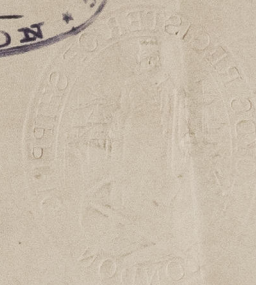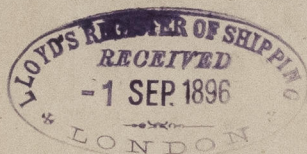

SLD1004-0153 1/2



© 2021

Lloyd's Register
Foundation