



SLD1004-DISS 1/2  
 No. 188 2/3  
 Enclose to  
 Messrs Lloyd's Surveyors  
 Date, 14/8/96.

20.8.96  
 4.9.96

— PROFILE No 188 2/3 —  
 LENGTH B.P. — 205' —  
 BREADTH MLD — 28' 9"  
 DEPTH MLD — 13' 2"  
 Class 100.A.1. Lloyd's as a collier  
 Scale 1/8" = 1 foot.

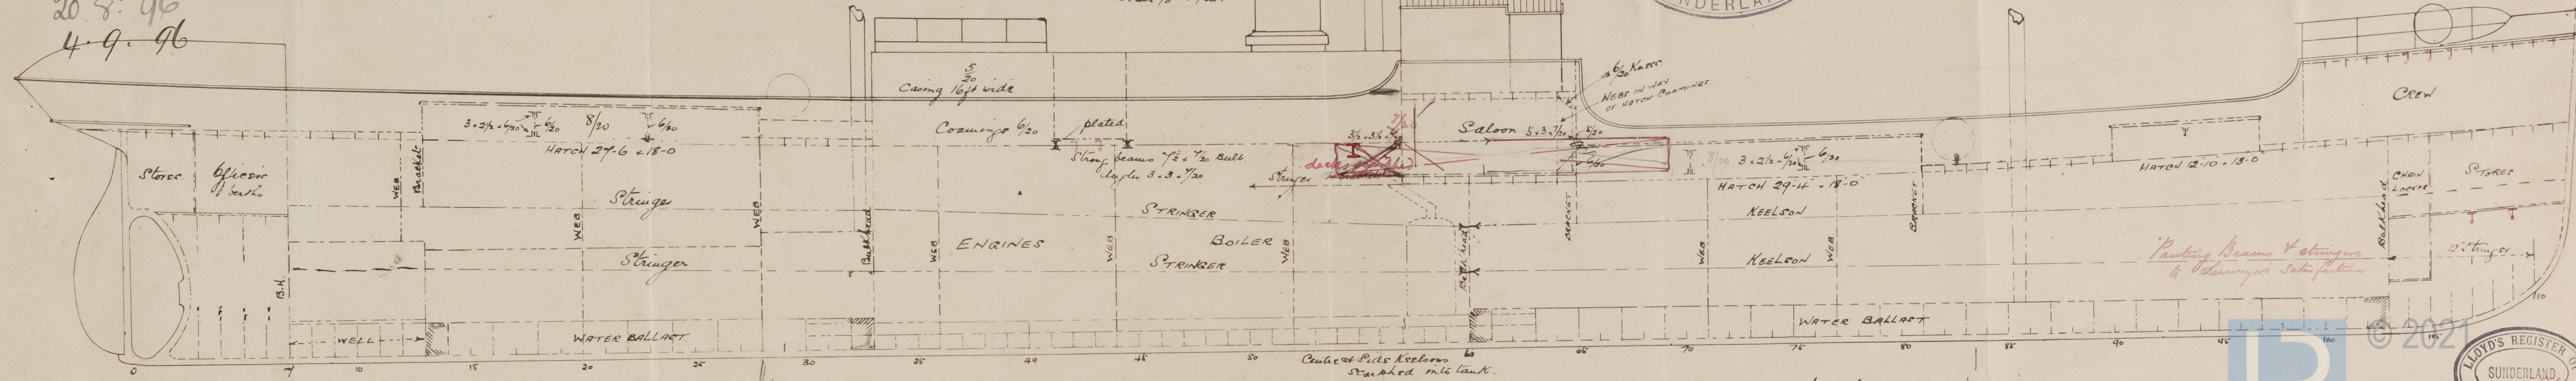

J.V.L.  
 4/9/96

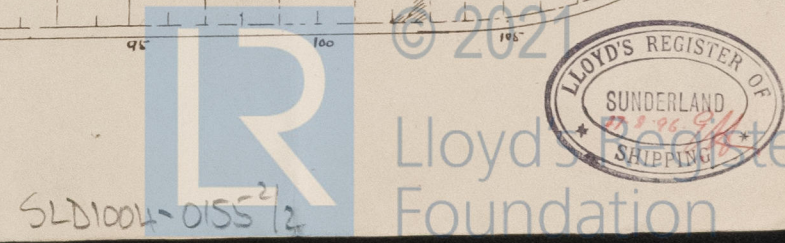

SLD1004-DISS 1/2



Sunderland S.B. 7

Nº 188 s. s.

Profile



© 2021

Lloyd's Register  
Foundation

SLD1004-0155 1/2

SLD1004-0155 1/2