


SCALE $\frac{1}{4}'' = 1 \text{ FOOT.}$

UNDER DECK TONS about 487

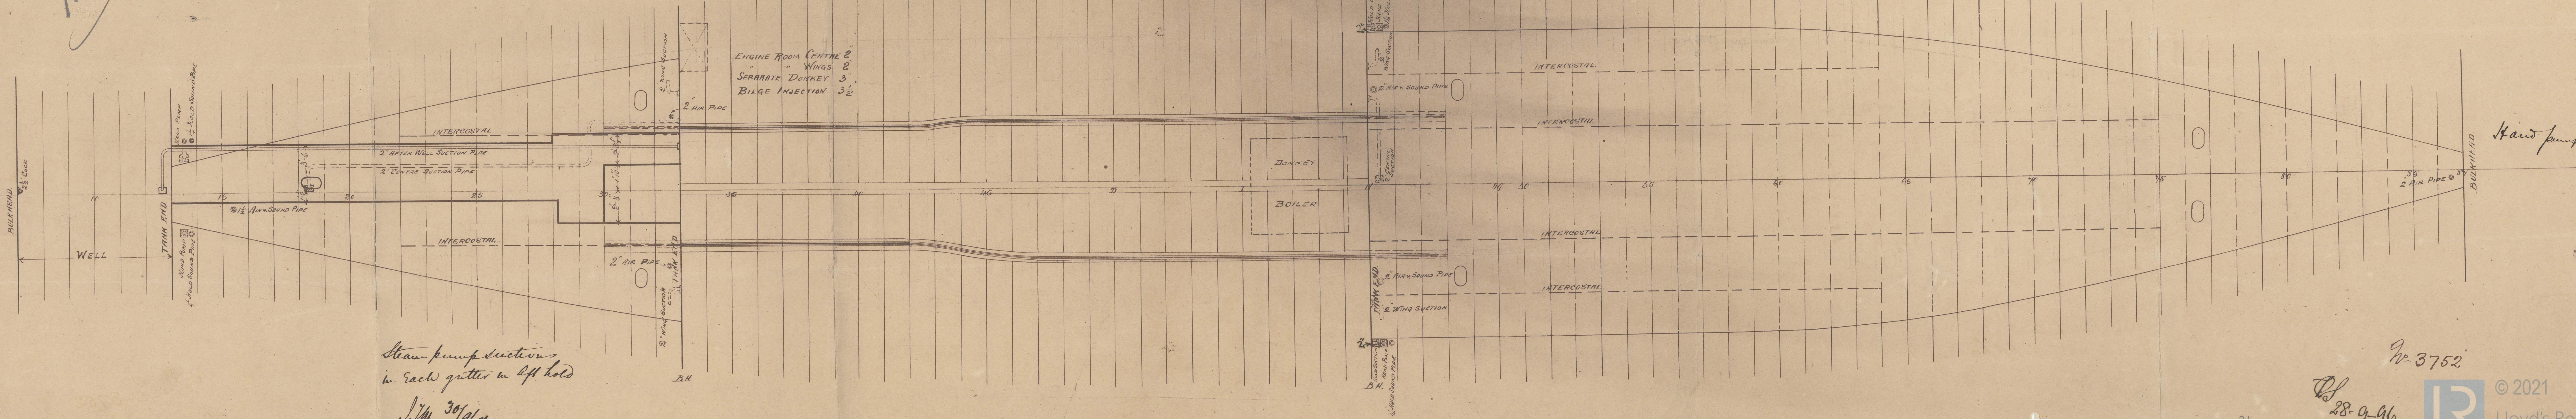

Steam pump suction
in each gutter in aft hold

Lim 30/9/96

2-3752

28-9-96

SLD1004-0156 $\frac{2}{2}$

SLD1004-0156 1/2

No. 188 1/2

Enclose to Messrs.
Lloyds. Surveyors
For approval.

Date, 23/7/96



S'ld S. B. 6° N° 188

Pumping
Arrangement

S S Norman

SUNDERLAND. No. 18527.

SLD1004-0156²/₂



© 2021

Lloyd's Register
Foundation