
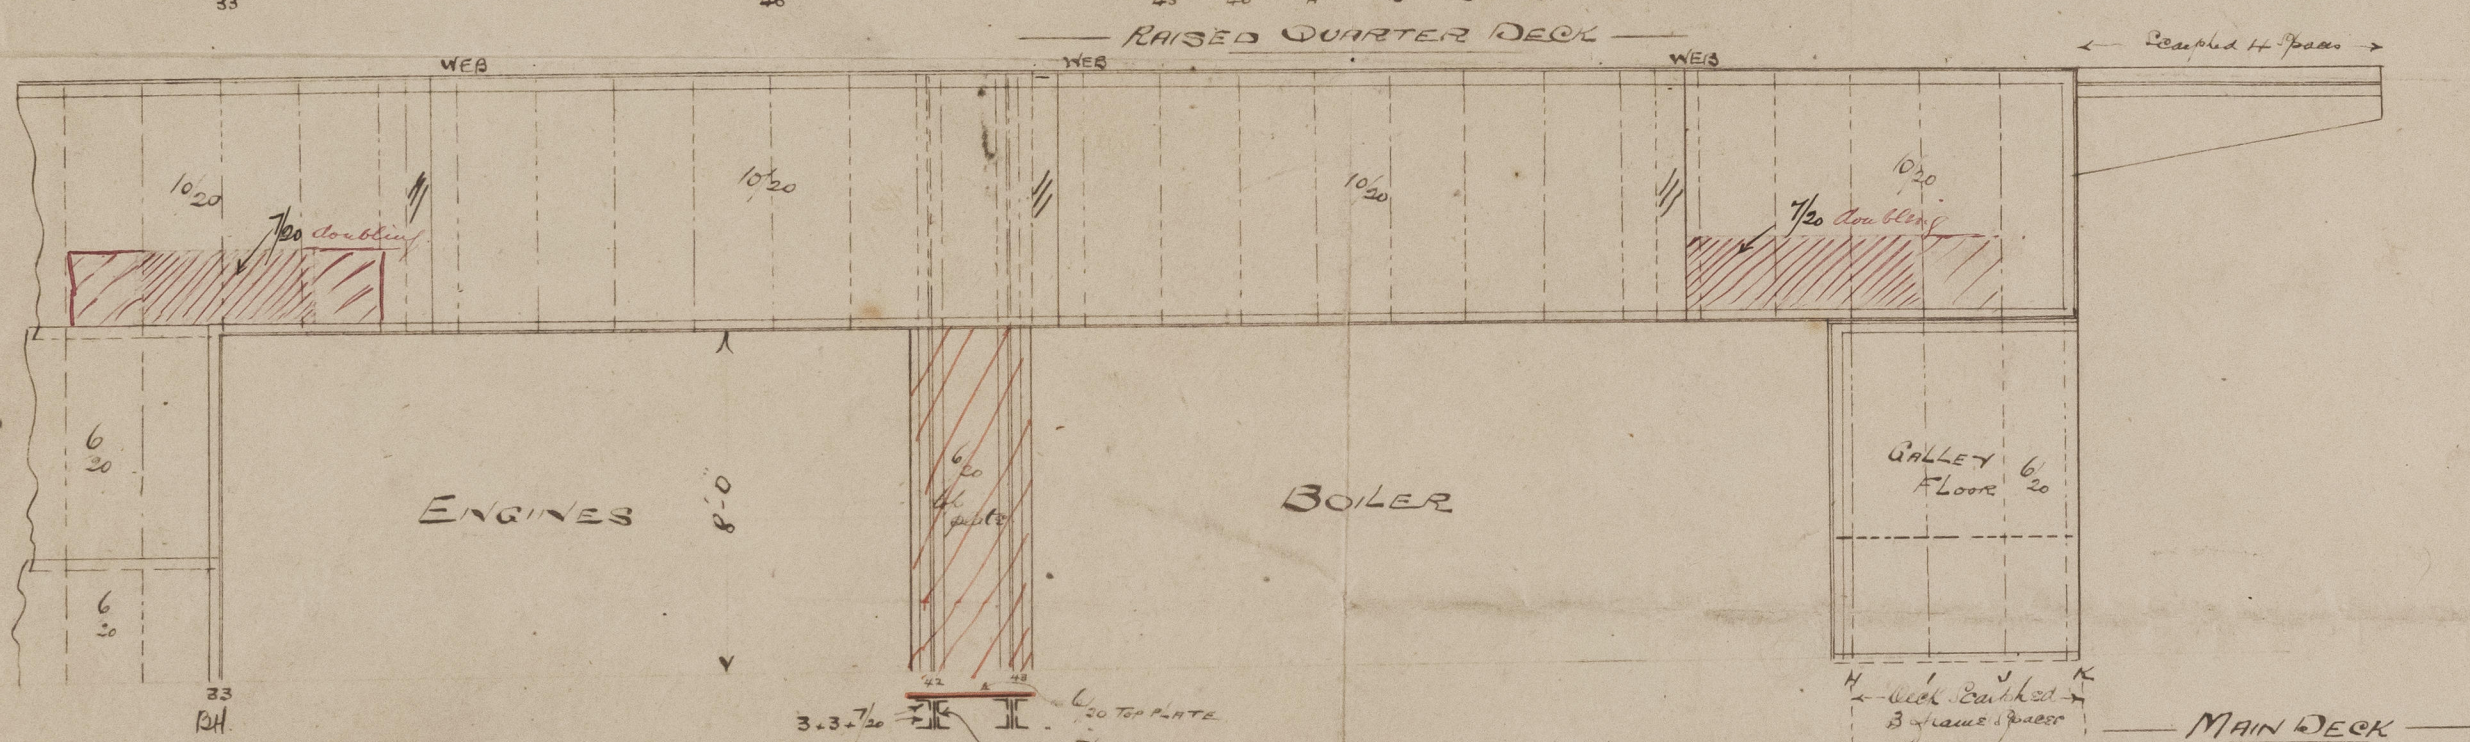



21.9.96

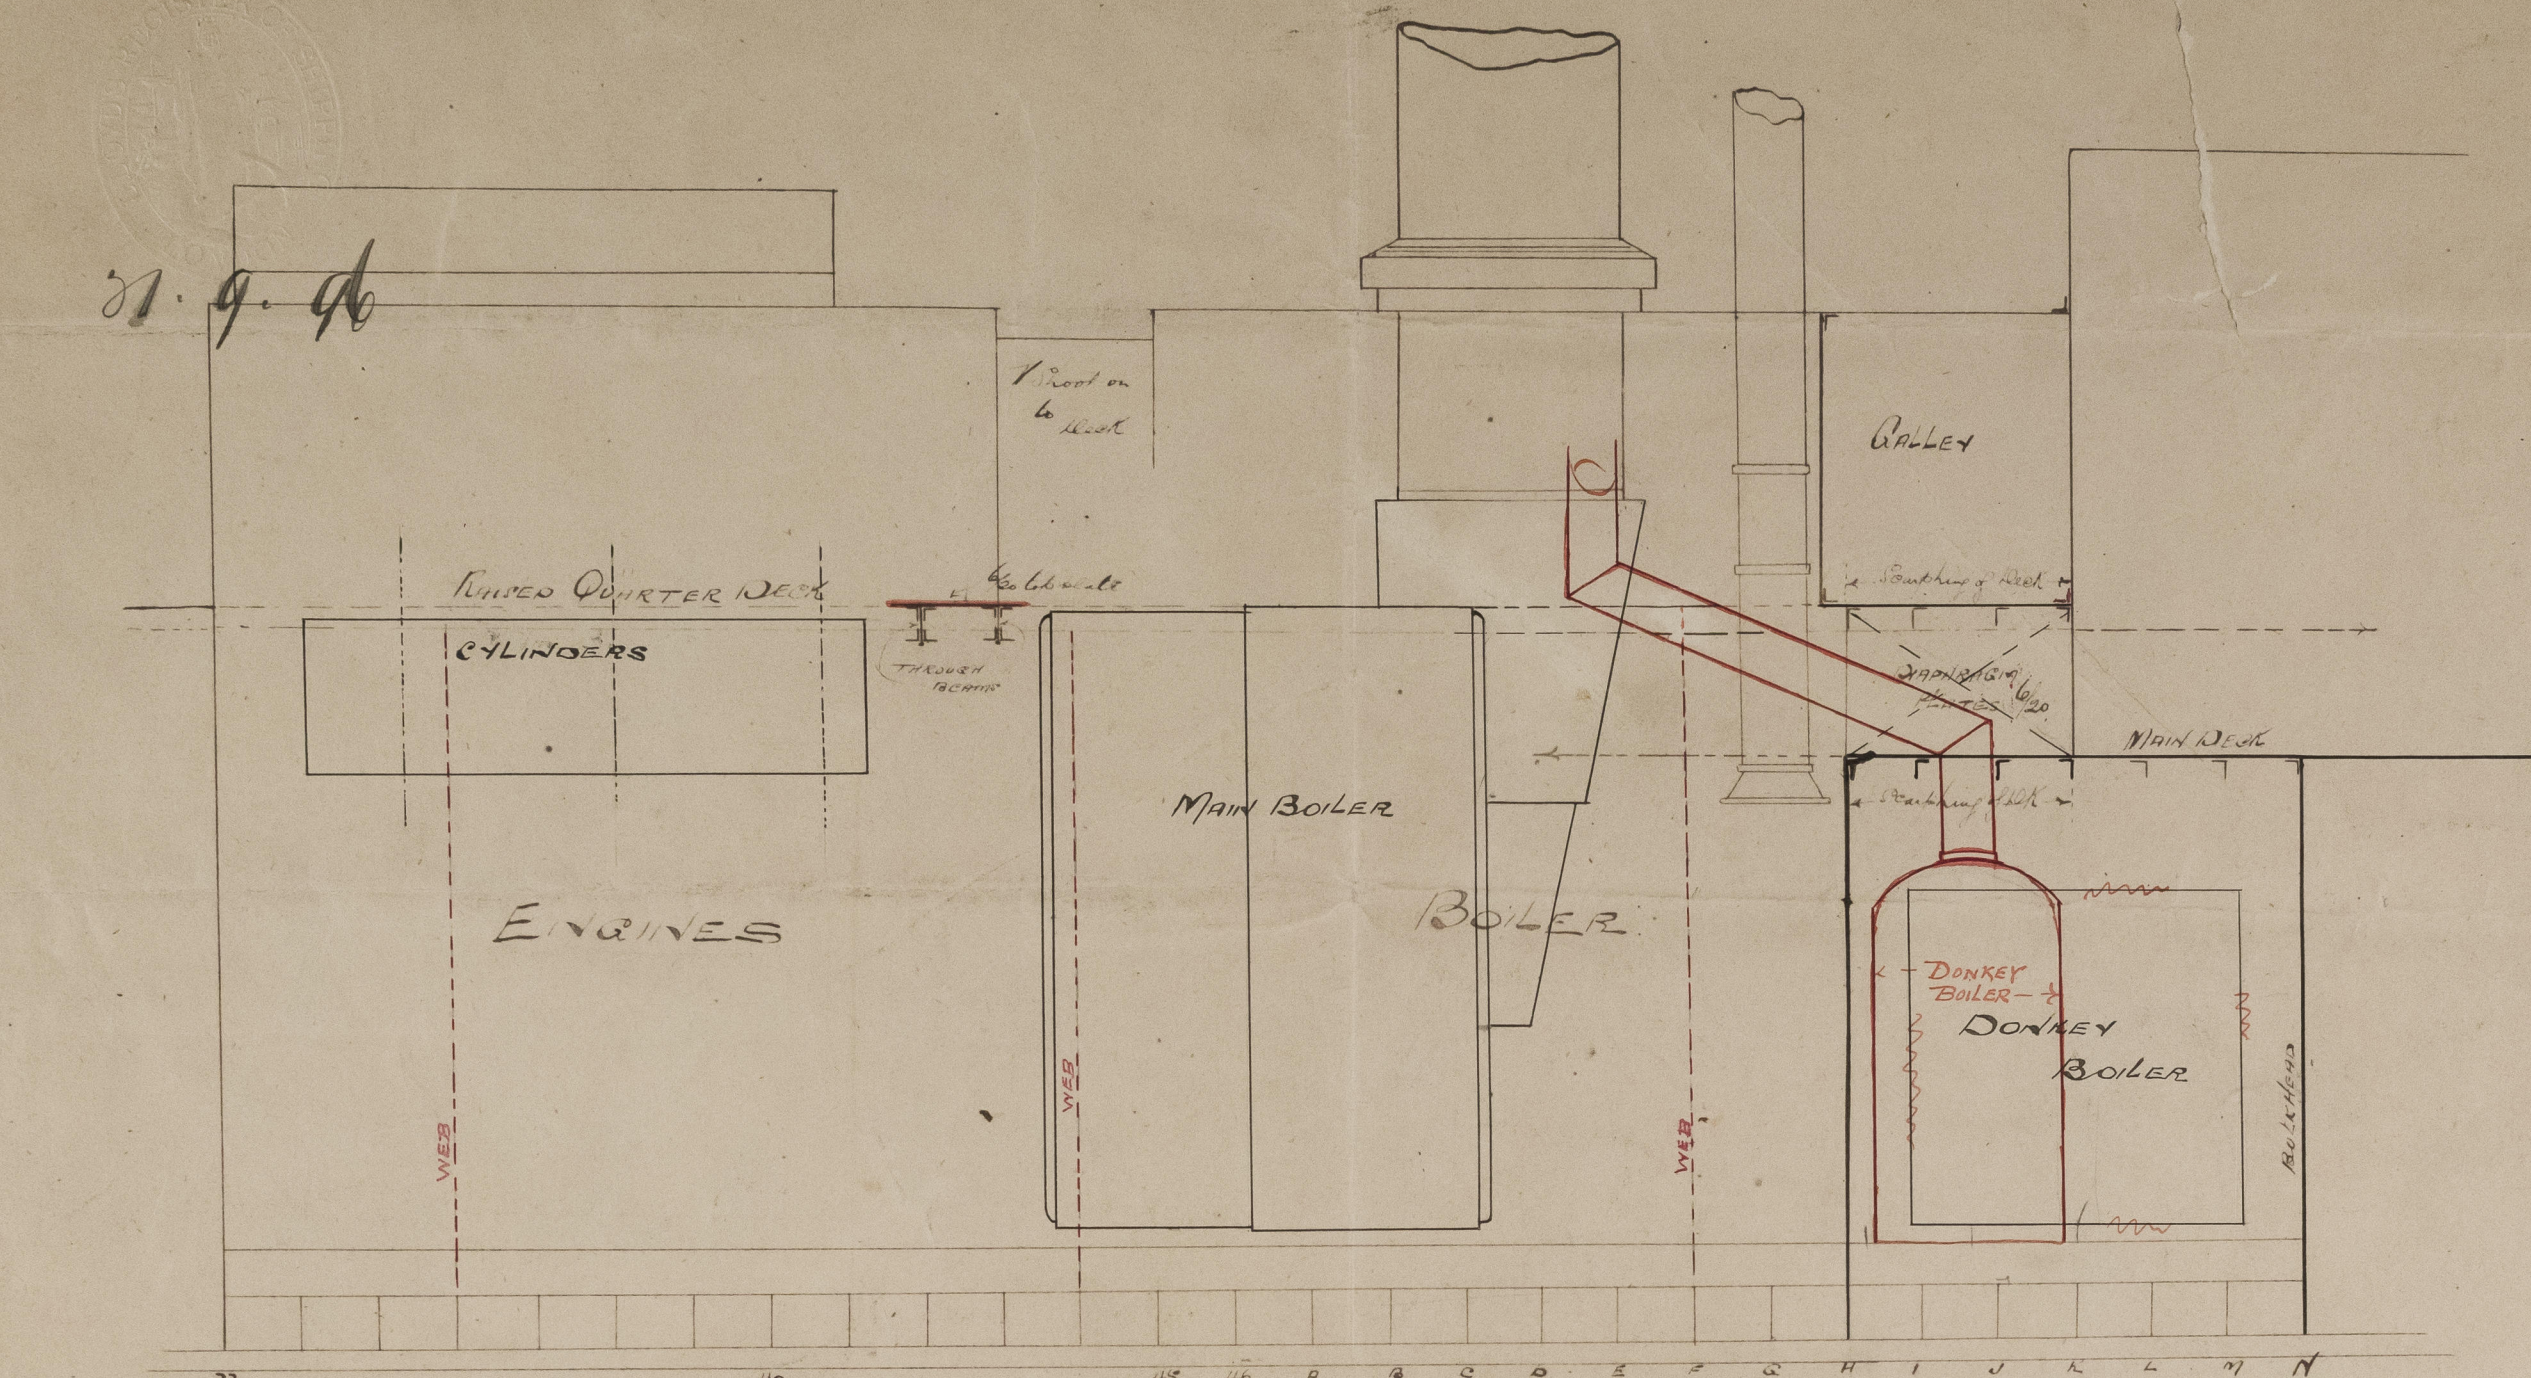


PLAN OF ENGINE + BOILER SPACE

No 188 S/S

SCALE 1/4" = 1 FOOT

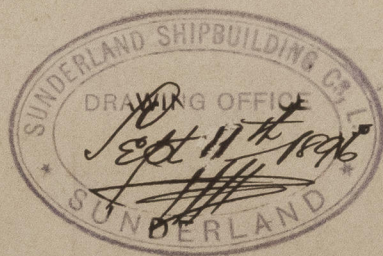

21.9.96

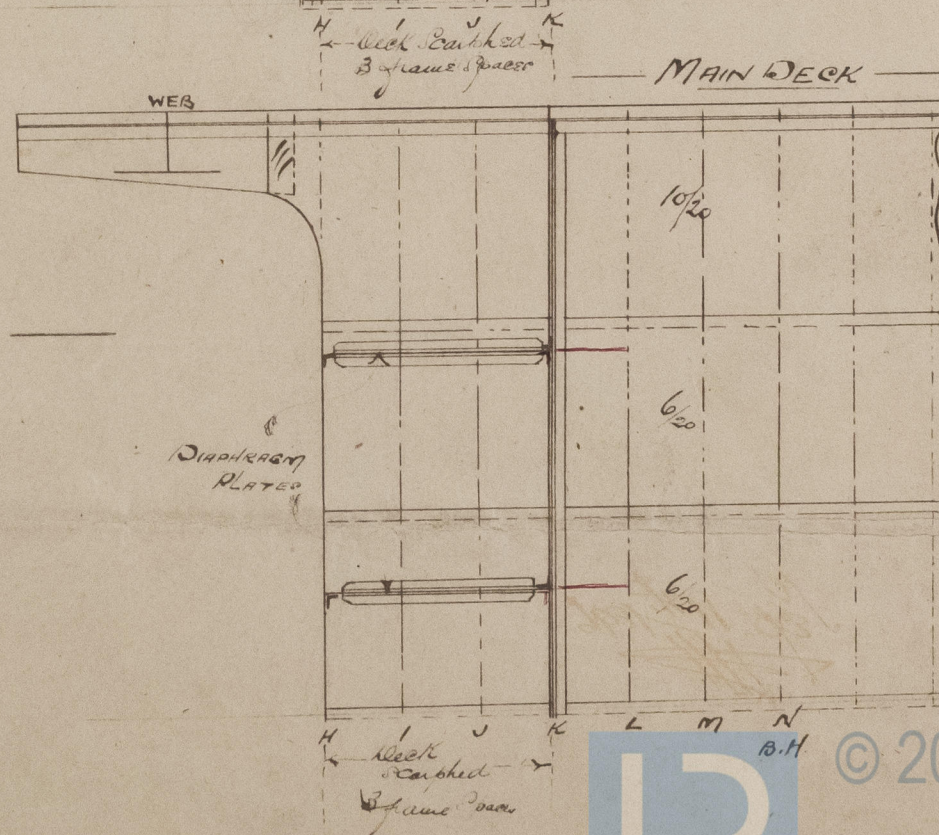

SLD1004-0157



© 2021

Lloyd's Register Foundation

Sunderland SB Co
No 188.

Sketch of
E & B. Space

Sunderland No. 18527



SLD1004-0157



© 2021

Lloyd's Register
Foundation