

No. 188<sup>4</sup>/<sub>5</sub>


Enclose to  
Mess<sup>rs</sup> Sloyds Surveyors  
Date, 17/8/96.

Nº 188 S/S.


LENGTH B.P. .... 205' - 7"  
 BREADTH MLD<sup>R</sup>. 28-9  
 DEPTH MLD<sup>R</sup>. .... 13' - 2"  
 CLASS 100 A.I. LLOYDS AS A COLLIER  
 SCALE  $\frac{1}{2}$ " = 1 FOOT



20. 8. 96  
4. 9. 96  
51. 9. 96<sup>5</sup>/<sub>2</sub> Side  
butts

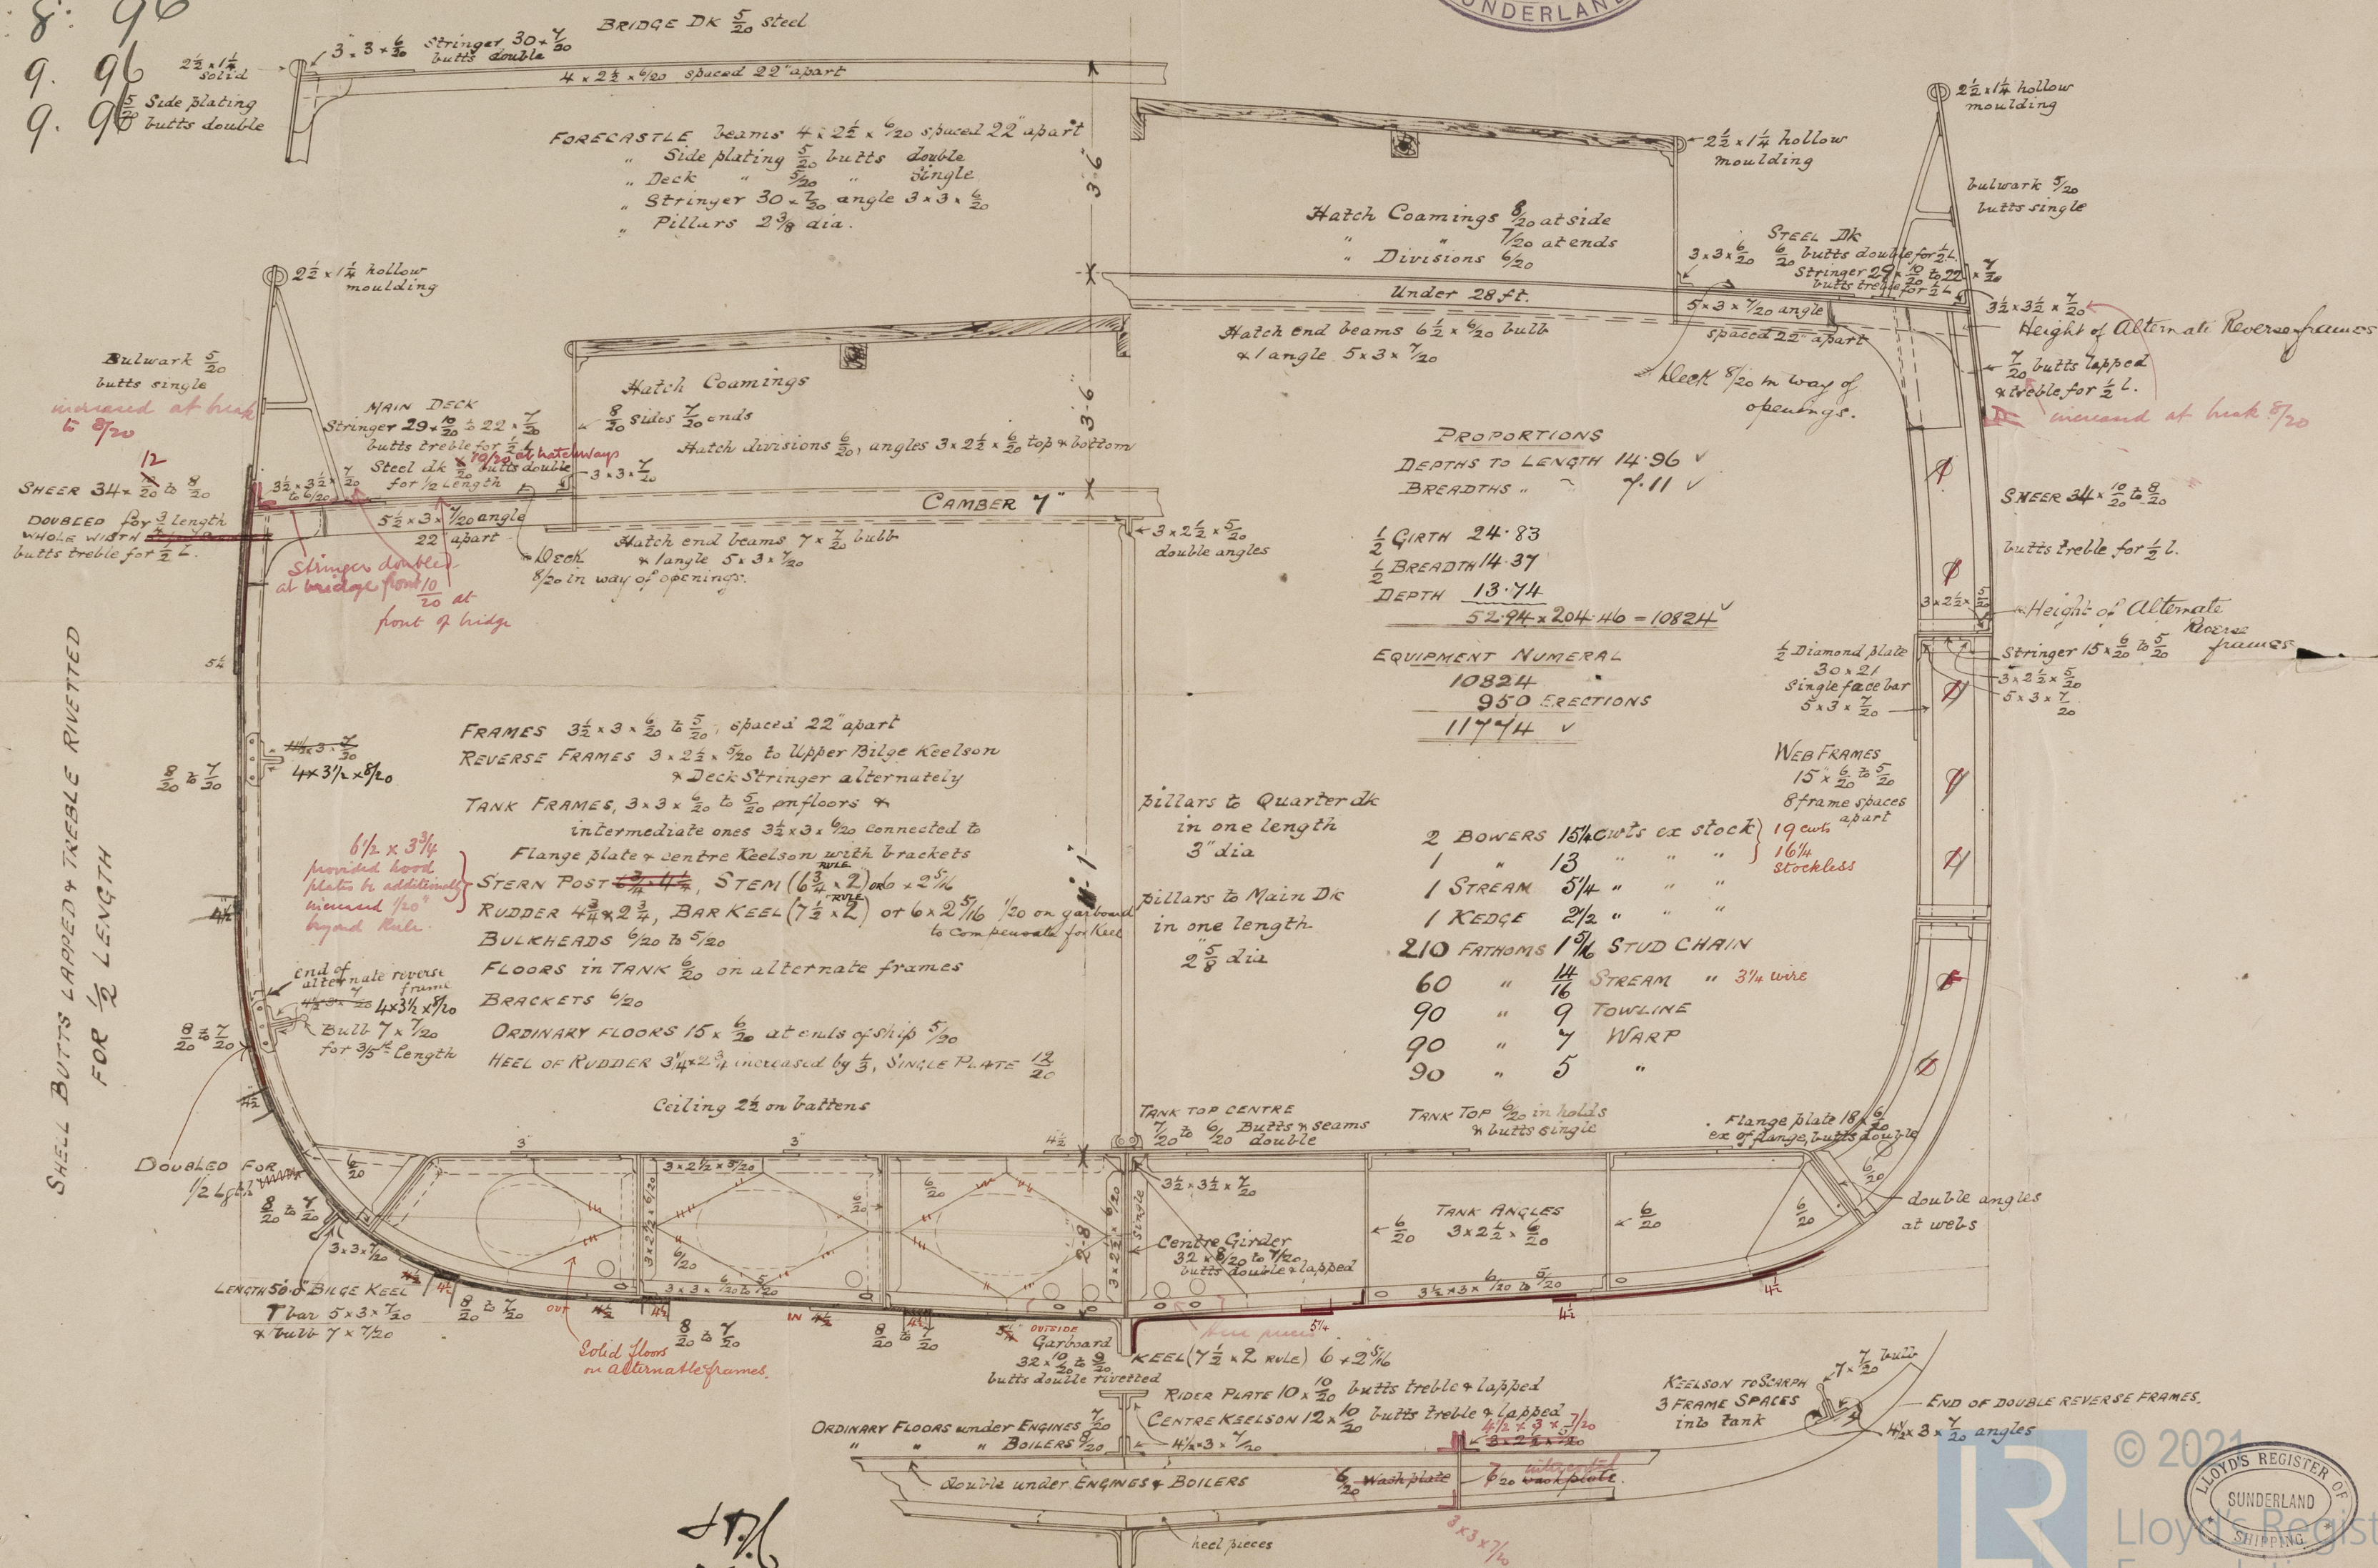

SLD1004-0158<sup>2</sup>/2

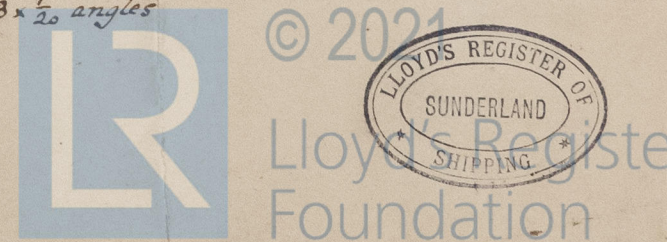









Sunderland S.Bb°

N° 188 s.s.

Midship Section  
s.s. "Norman"

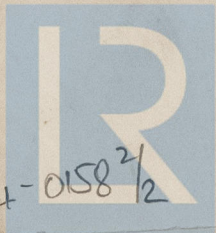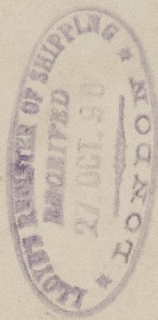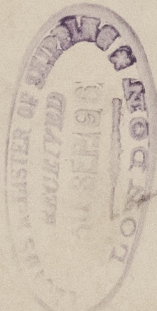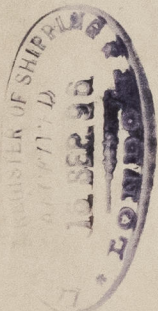

© 2021

Lloyd's Register  
Foundation

SLD1004-0158<sup>2</sup>/<sub>2</sub>