

Length Overall 37.0 about.

Height of Gudgeons from Stern frame.

Section at A.B


Section at C.D

— 553 —




—Cast steel frame—

Scales $\frac{1}{2}$ & $1\frac{1}{2}$ = 1 foot.



To pass Messrs Lloyd's Surveyor's
inspection.

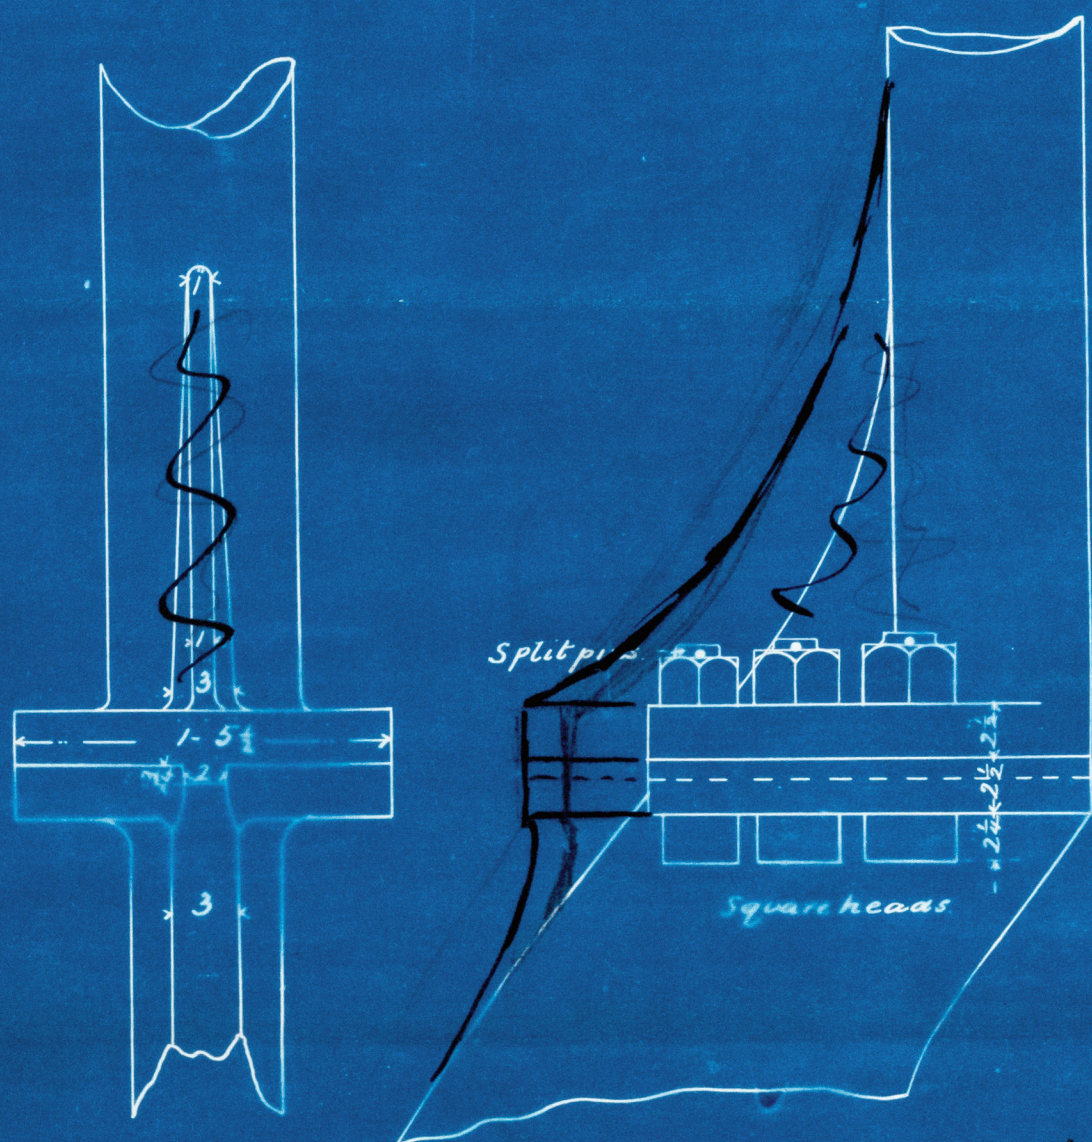

See plan attached
of makers

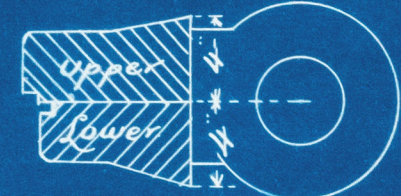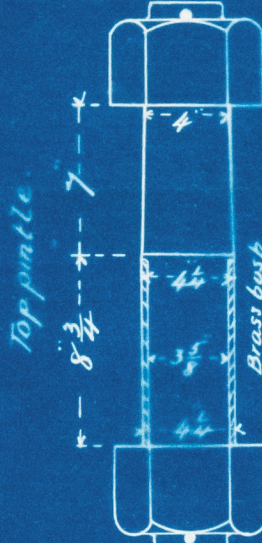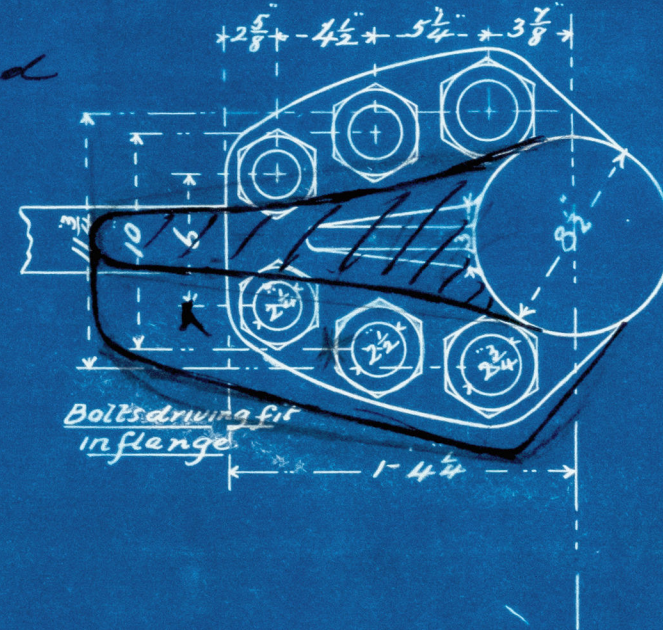

Sections at Stoppers

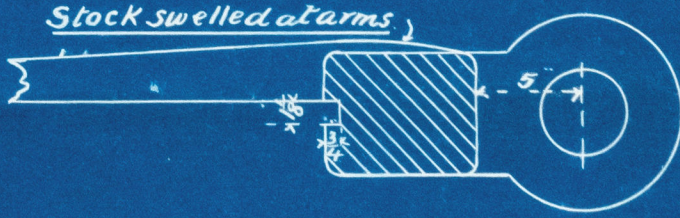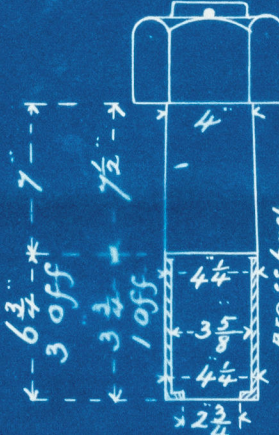

Section of frame

16/3/96

James Laing

553

Cast Steel Rudder

See plan by makers

of "Westralia"

Sunderland N^o 12599.

SLD1005-0110



© 2021

Lloyd's Register
Foundation