

23-2-96
27-5-96

MIDSHIP SECTION

S.S. N^o 553

LENGTH BP 327-0 B^oTH MLD 41-0 DEPTH MLD 23-0

CLASS 100 A.I. LLOYDS

THREE DECK RULES

SCALE 1/2" = 1 FOOT

NUMERALS

1/2 CIRTH — 41.25
1/2 BREADTH — 20.50
DEPTH — 23.85
85.60
7.00
78.60 x 325.34 =
25571 27849

PROPORTIONS


7.93 BREADTHS IN LENGTH
19.30 DEPTHS TO MAIN DECK
13.64 DEPTHS TO UPPER DECK

EQUIPMENT N^o

1/2 CIRTH — 41.25
1/2 BREADTH — 20.50
DEPTH — 23.85
85.60 x 325.34 =
27849
2514
30363
BRIDGE 186-0
FORECASTLE 49-0
235-0

EQUIPMENT N^o 30363

3 BOWERS 36 1/2 CWTs EX STOCK (COLLECTIVE WCHTS 104 CWTs)
1 STREAM 11 1/2 " " "
1 KEDGE 5 1/2 " " "
270 FATHOMS 1 15/16 CHAIN CABLE
90 " 1 1/16 STREAM CHAIN, OR 4 1/4 STEEL WIRE
100 " 12" TOWLINE OR 4 " "
90 " 10 HAWSER
90 " 8 1/2 WARPS

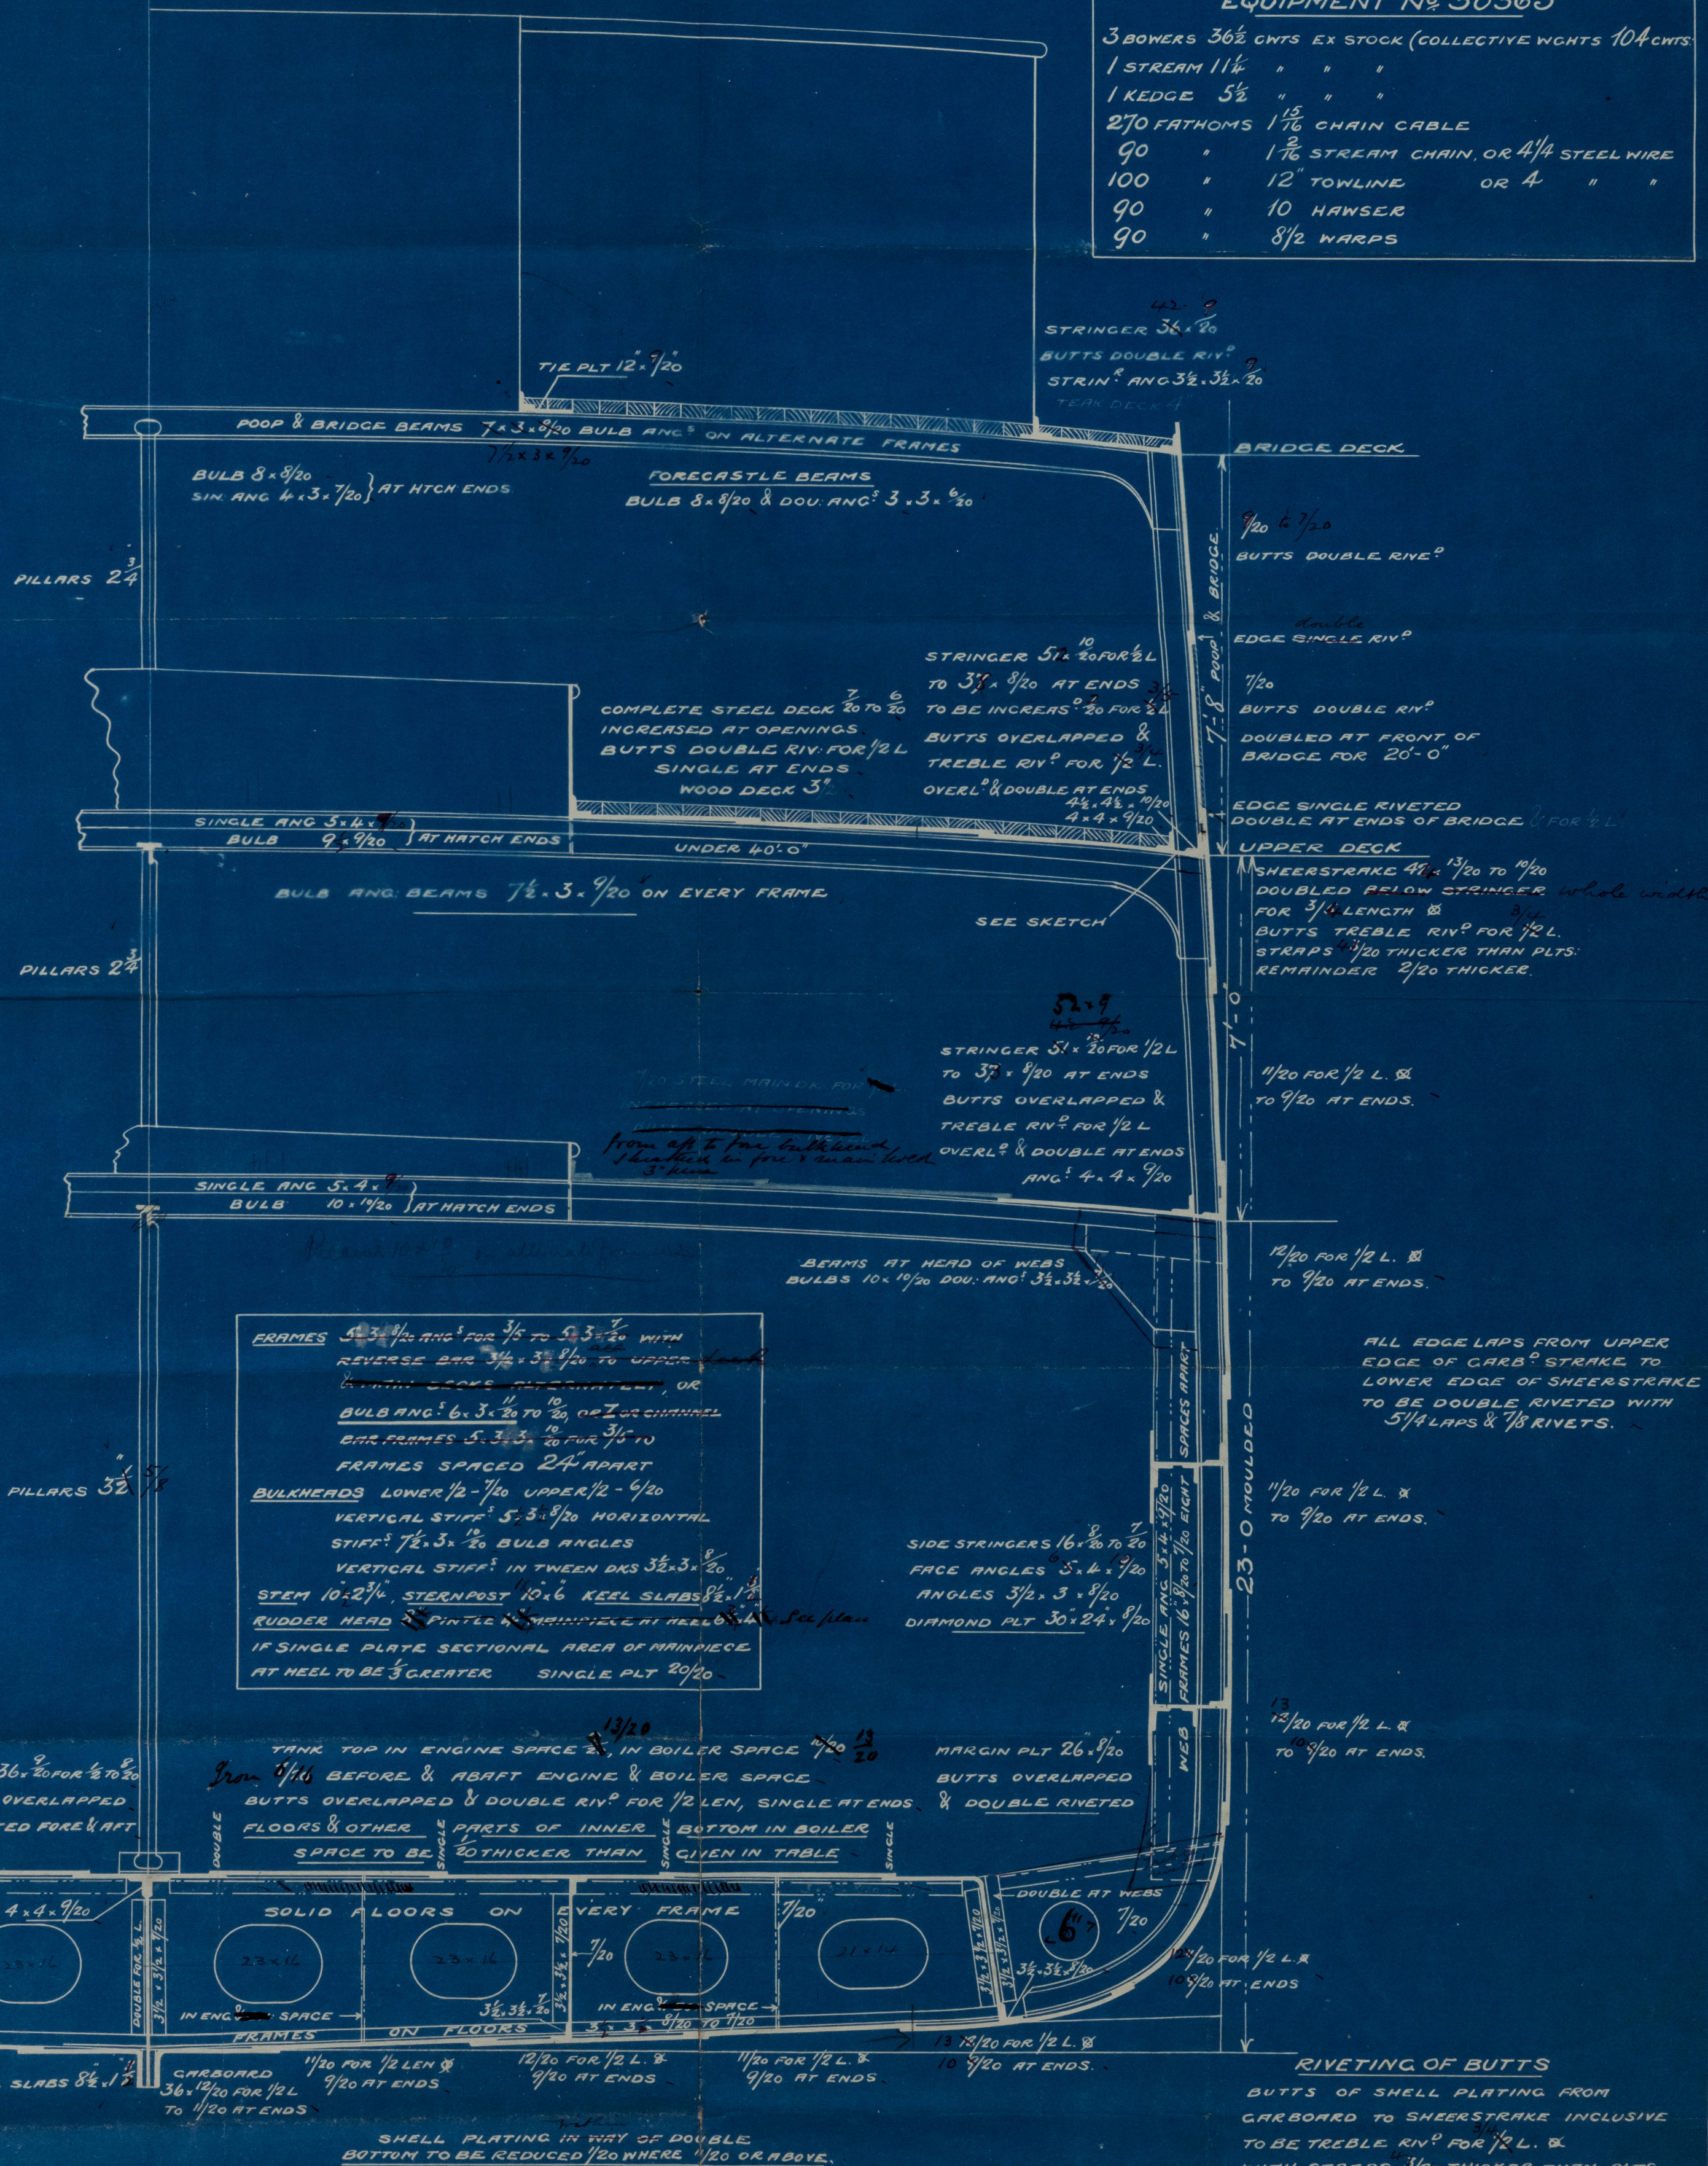

JAMES LAING
DEPTFORD YARDS
SUNDERLAND





© 2021
Lloyd's Register

SLD1005-0111

James Caird
No 553
Mid Section
S.S. Australia



Sed 18599

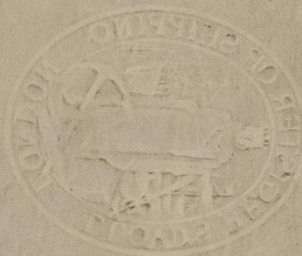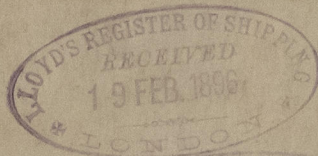

© 2021

Lloyd's Register
Foundation

SLD1005-011