

SS N<sup>o</sup>553

SKETCH SHOWING STRENGTHENING AT FRONT OF BRIDGE


25.2.96

SECTION AT 91 & AFT

SECTION AT 92 TO 96


SECTION FROM 99 TO 108

SCALE 1/2 INCH = 1 FOOT

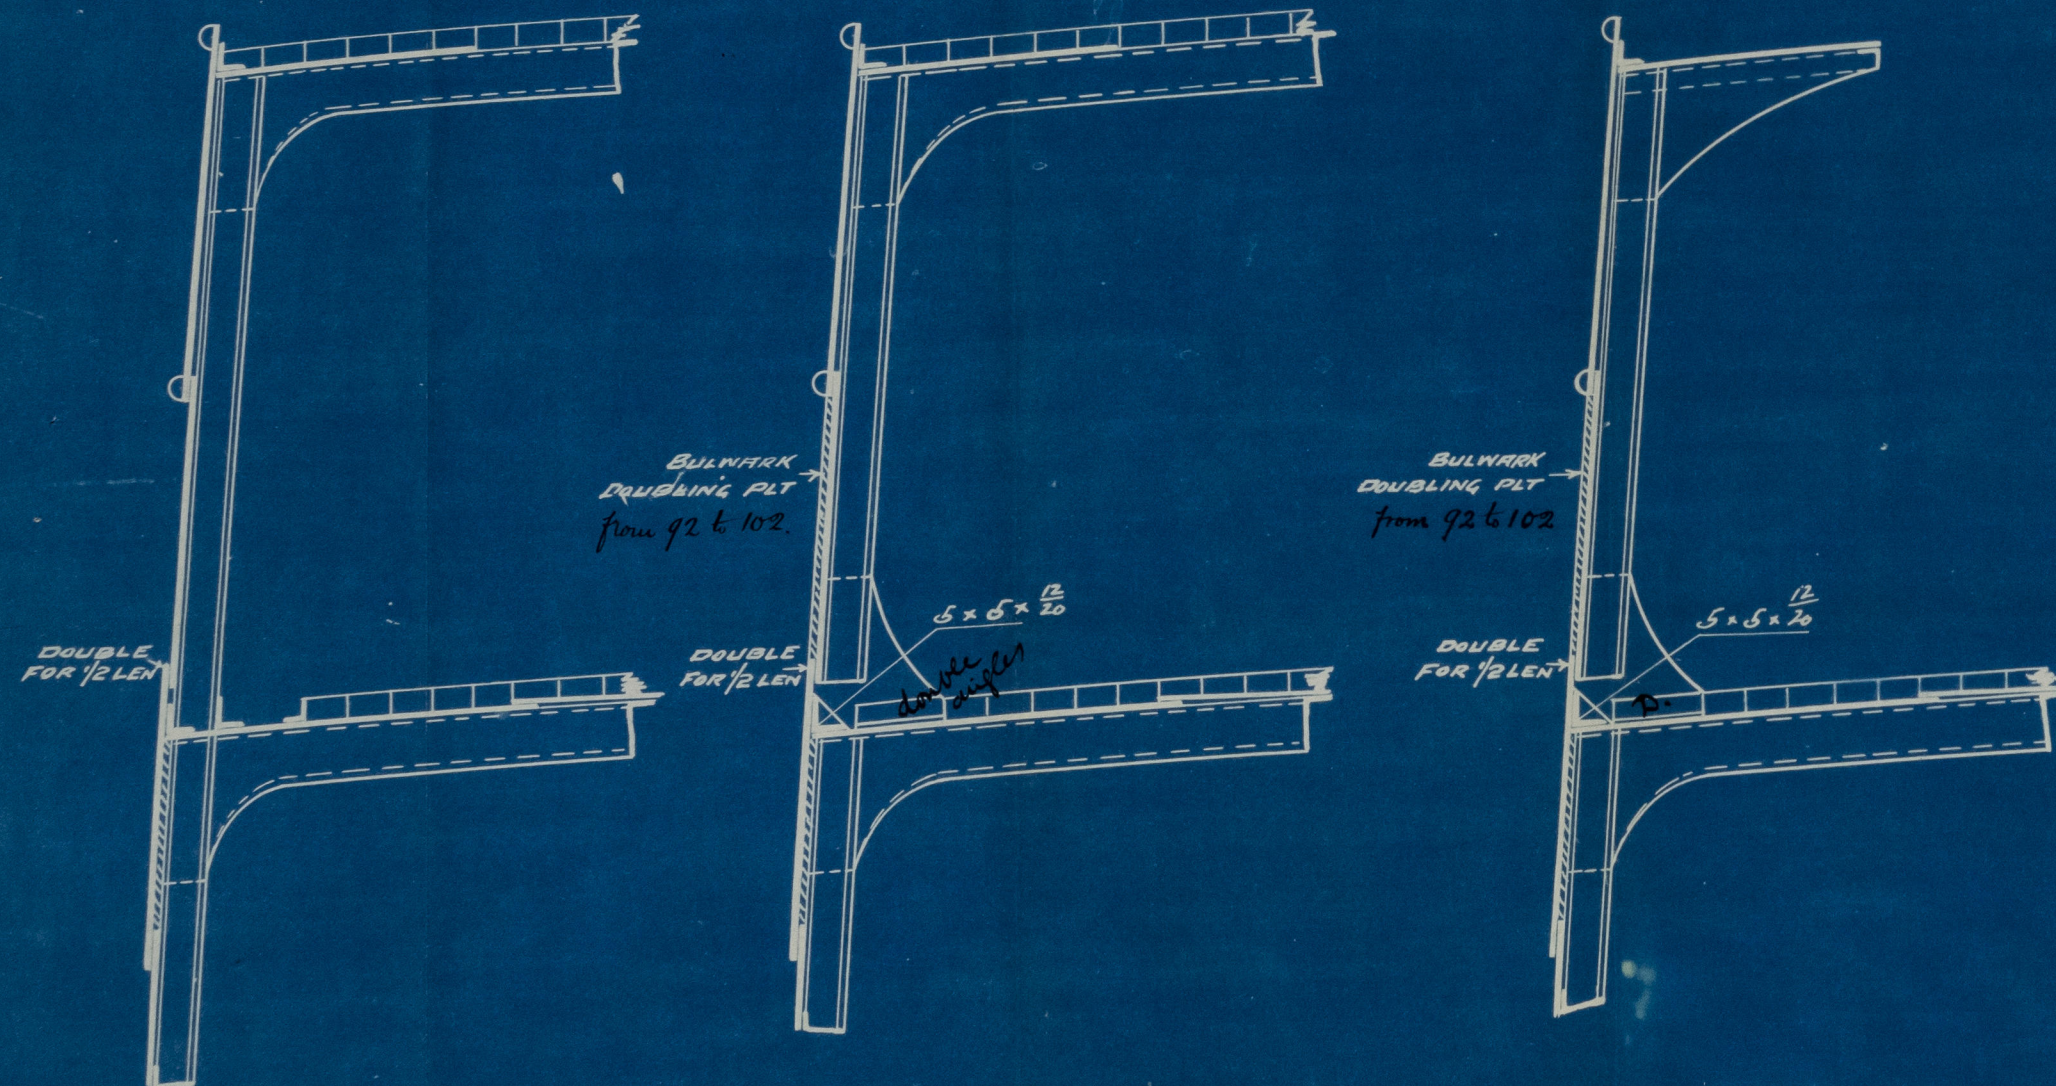

ELEVATION OF SIDE PLATING

SCALE 1/8" = 1 FOOT

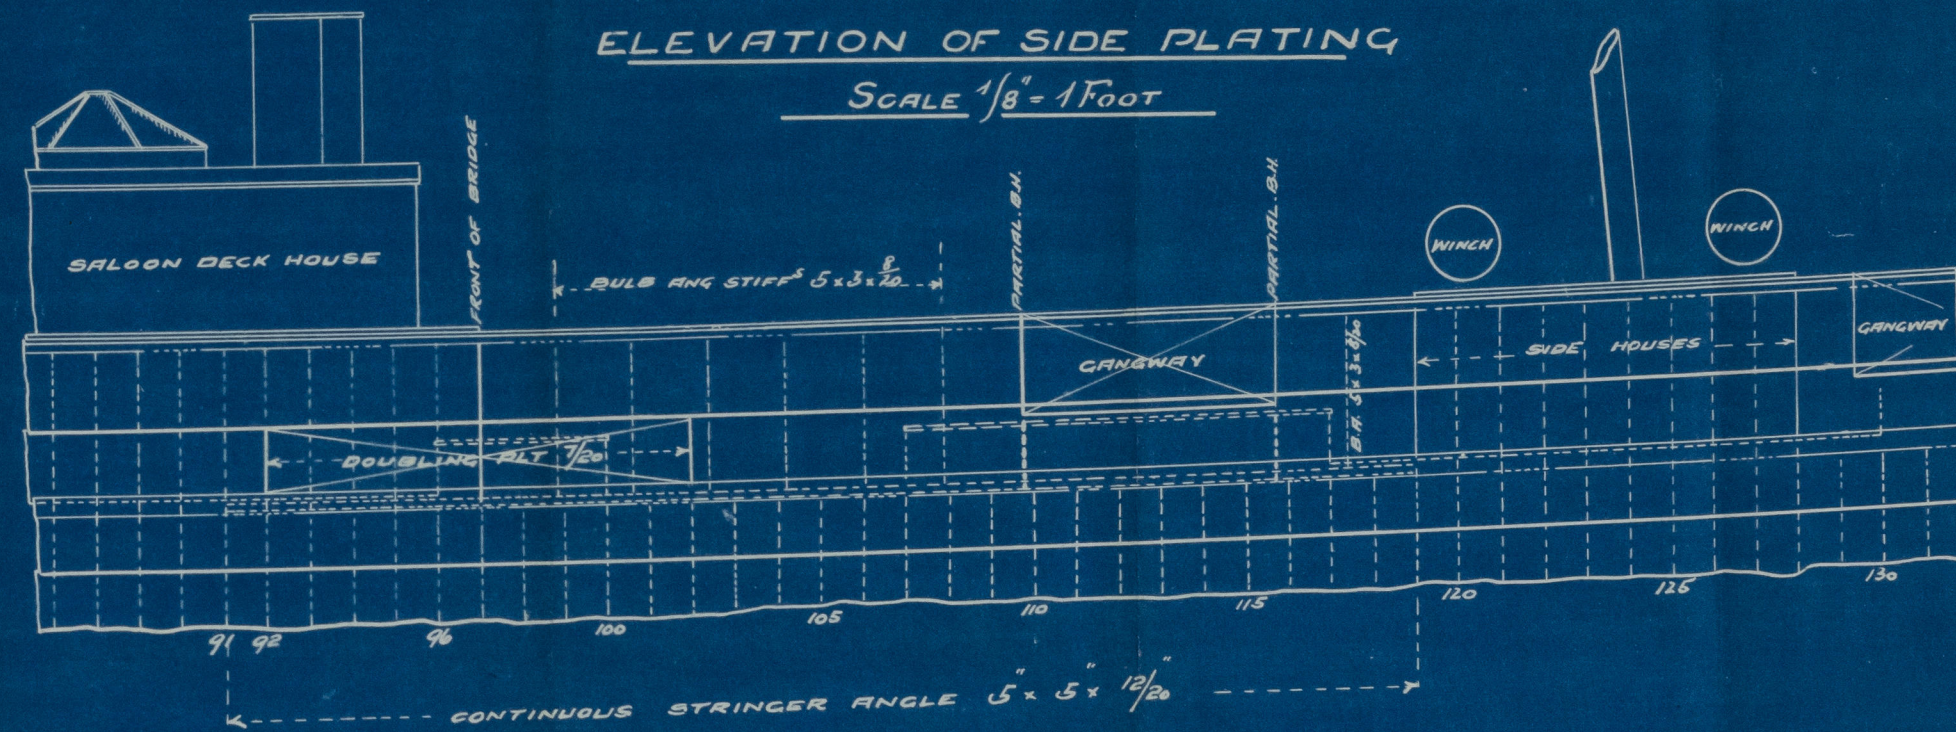

J.L.  
20/2/96

JAMES LAING  
DEPTFORD YARDS  
SUNDERLAND

SLD1005-0112





James Laing  
No 553

Shipping agent at  
Bridge Street

S. S. "Westralia"

Shd. F. E. No 18599



© 2021

Lloyd's Register  
Foundation

SLN1005-0112