


24. 9. 96  
 6. 11. 96 (No. 64)  
 2. 9. 97 (No. 72)

PROFILE OF S.S. 64. *No. 66, also No. 65*  
*app. 1/10/96*  
*class 72*  
*app. 2. 9. 97*


Dimensions	
Length B.P.	325' 0"
Breadth Ex.	44' 0"
Depth Mid. (Upper Deck)	26' 10"
Scale 1/4" = one foot	

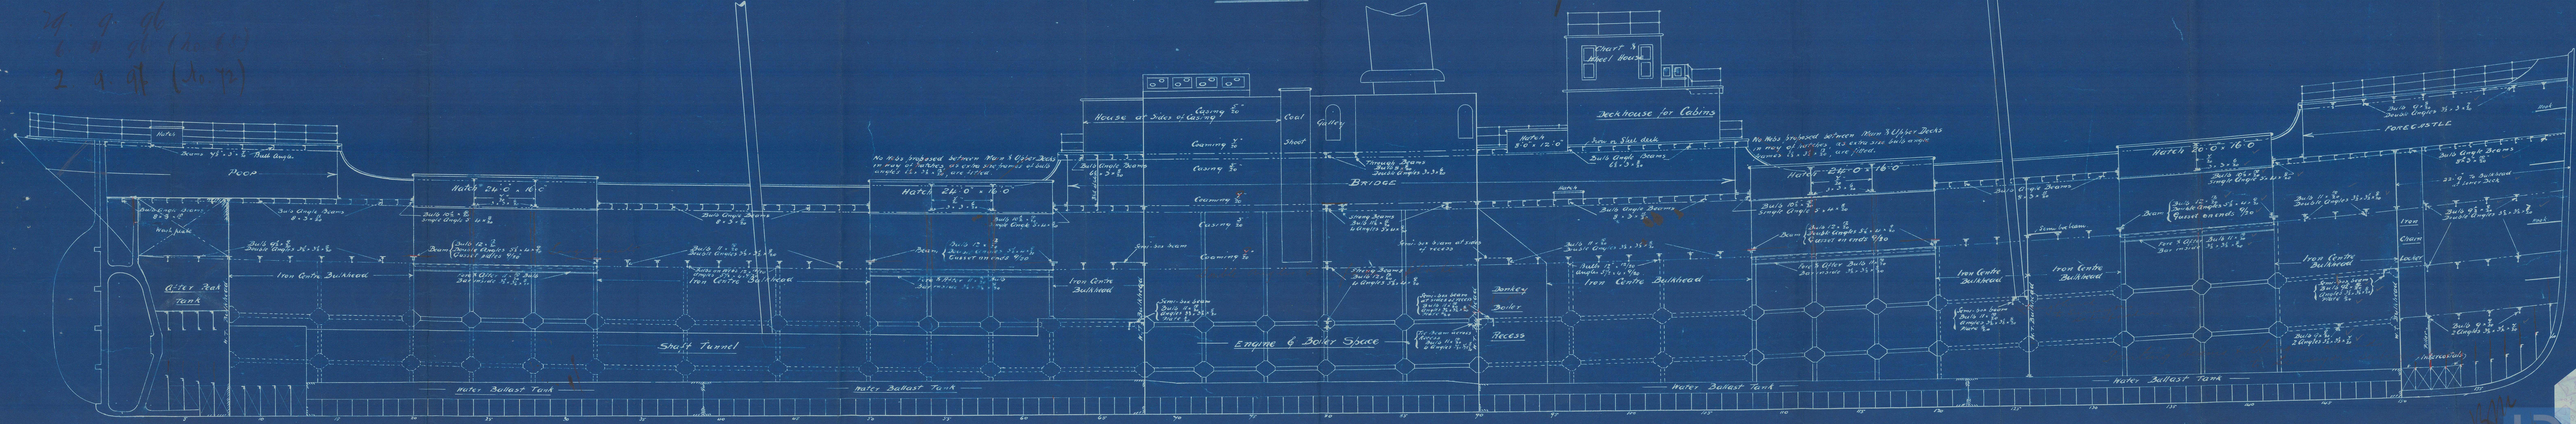

9210-100178





J. Freeman & Co  
No 65  
S.S. Rugby & No 66  
Longitudinal Section

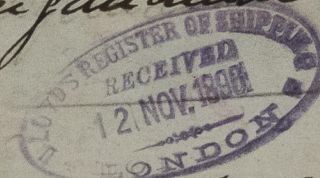

No 65 Rugby  
S.S. Ursula Bright  
SUNDERLAND. No 18692

No 66  
S.S. Ursula Bright  
SUNDERLAND. No 18844

No 72

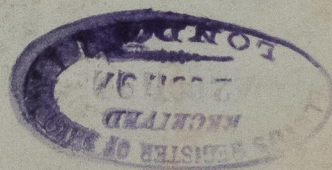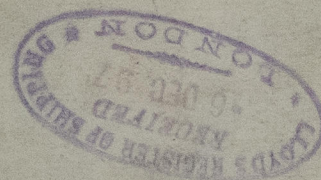

SLD1007-0125



© 2021

Lloyd's Register  
Foundation