
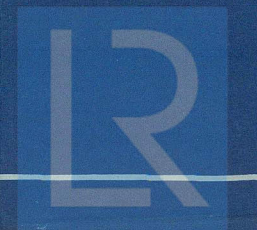
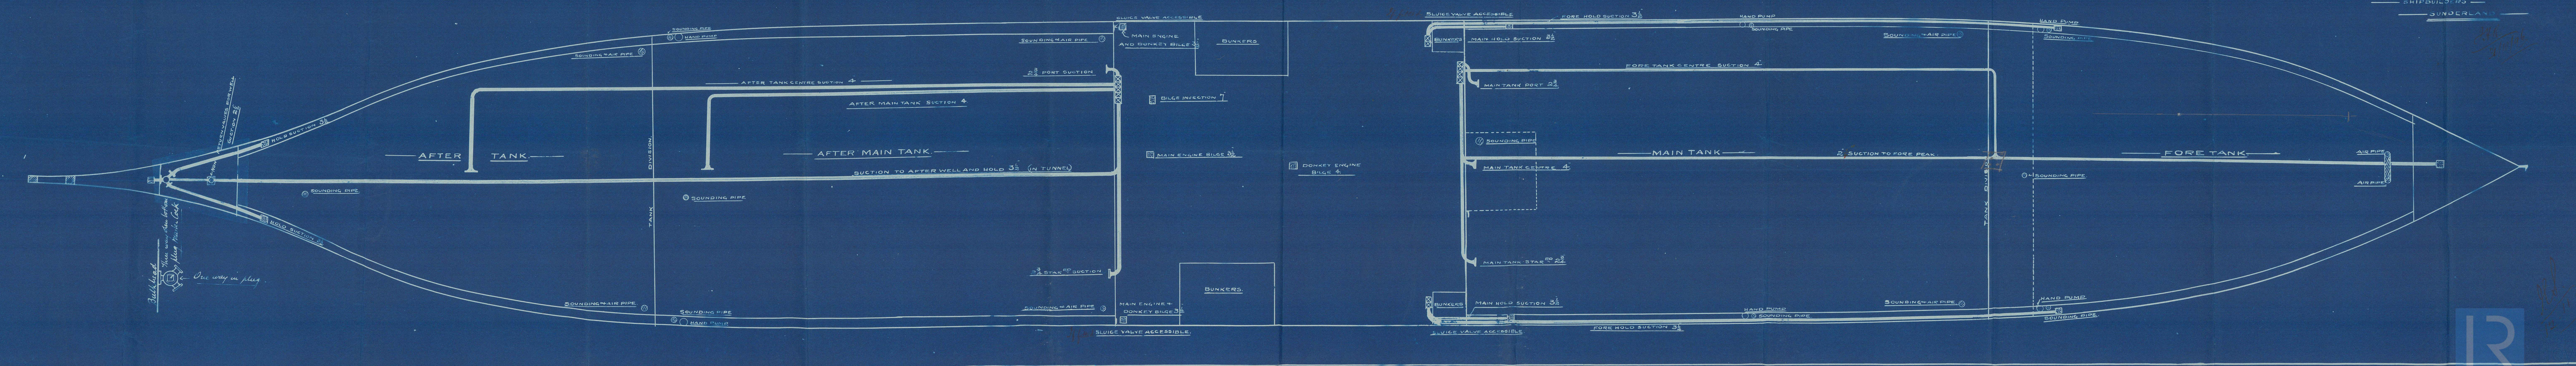



Handwritten notes:
R.H. 12.11.96
20.11.96

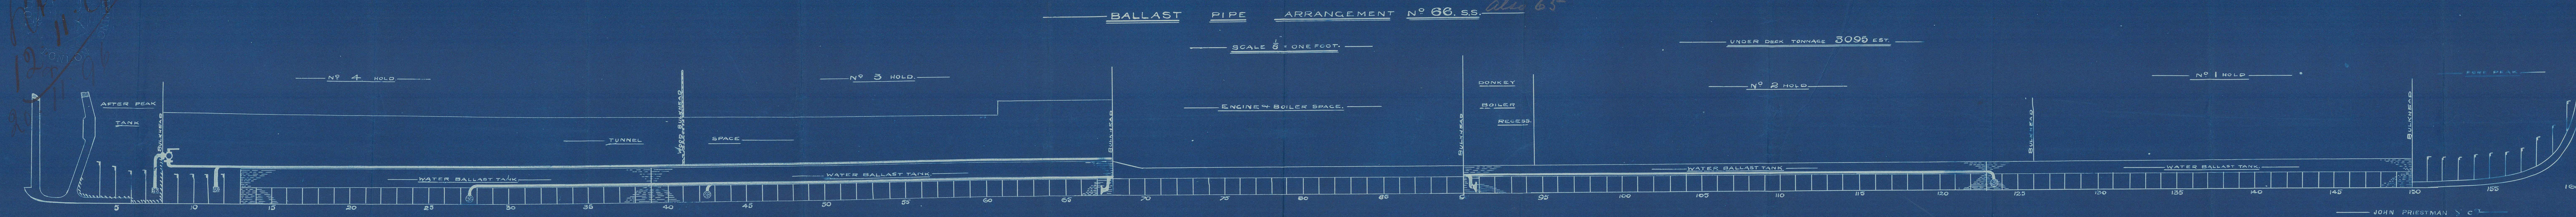

SLD1007-0128

J Prestman
N^o 66.

Pumpnigplace
Uruta Bright


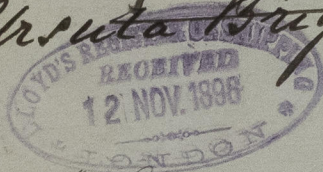


s/s "Pugby"
Indb report no 2028

SUNDERLAND. N^o 18692

No 65: S.S. Pugby
No 66 S.S. Uruta Bright

SUNDERLAND. 18844

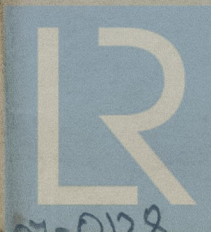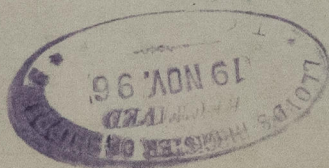

© 2021

Lloyd's Register
Foundation

SLA1007-0128