


A.
B.
13/7/46


25.7.46
7.5.46

S. S. N^o 555.
SCALE $\frac{1}{2}$ " = 1 FOOT.

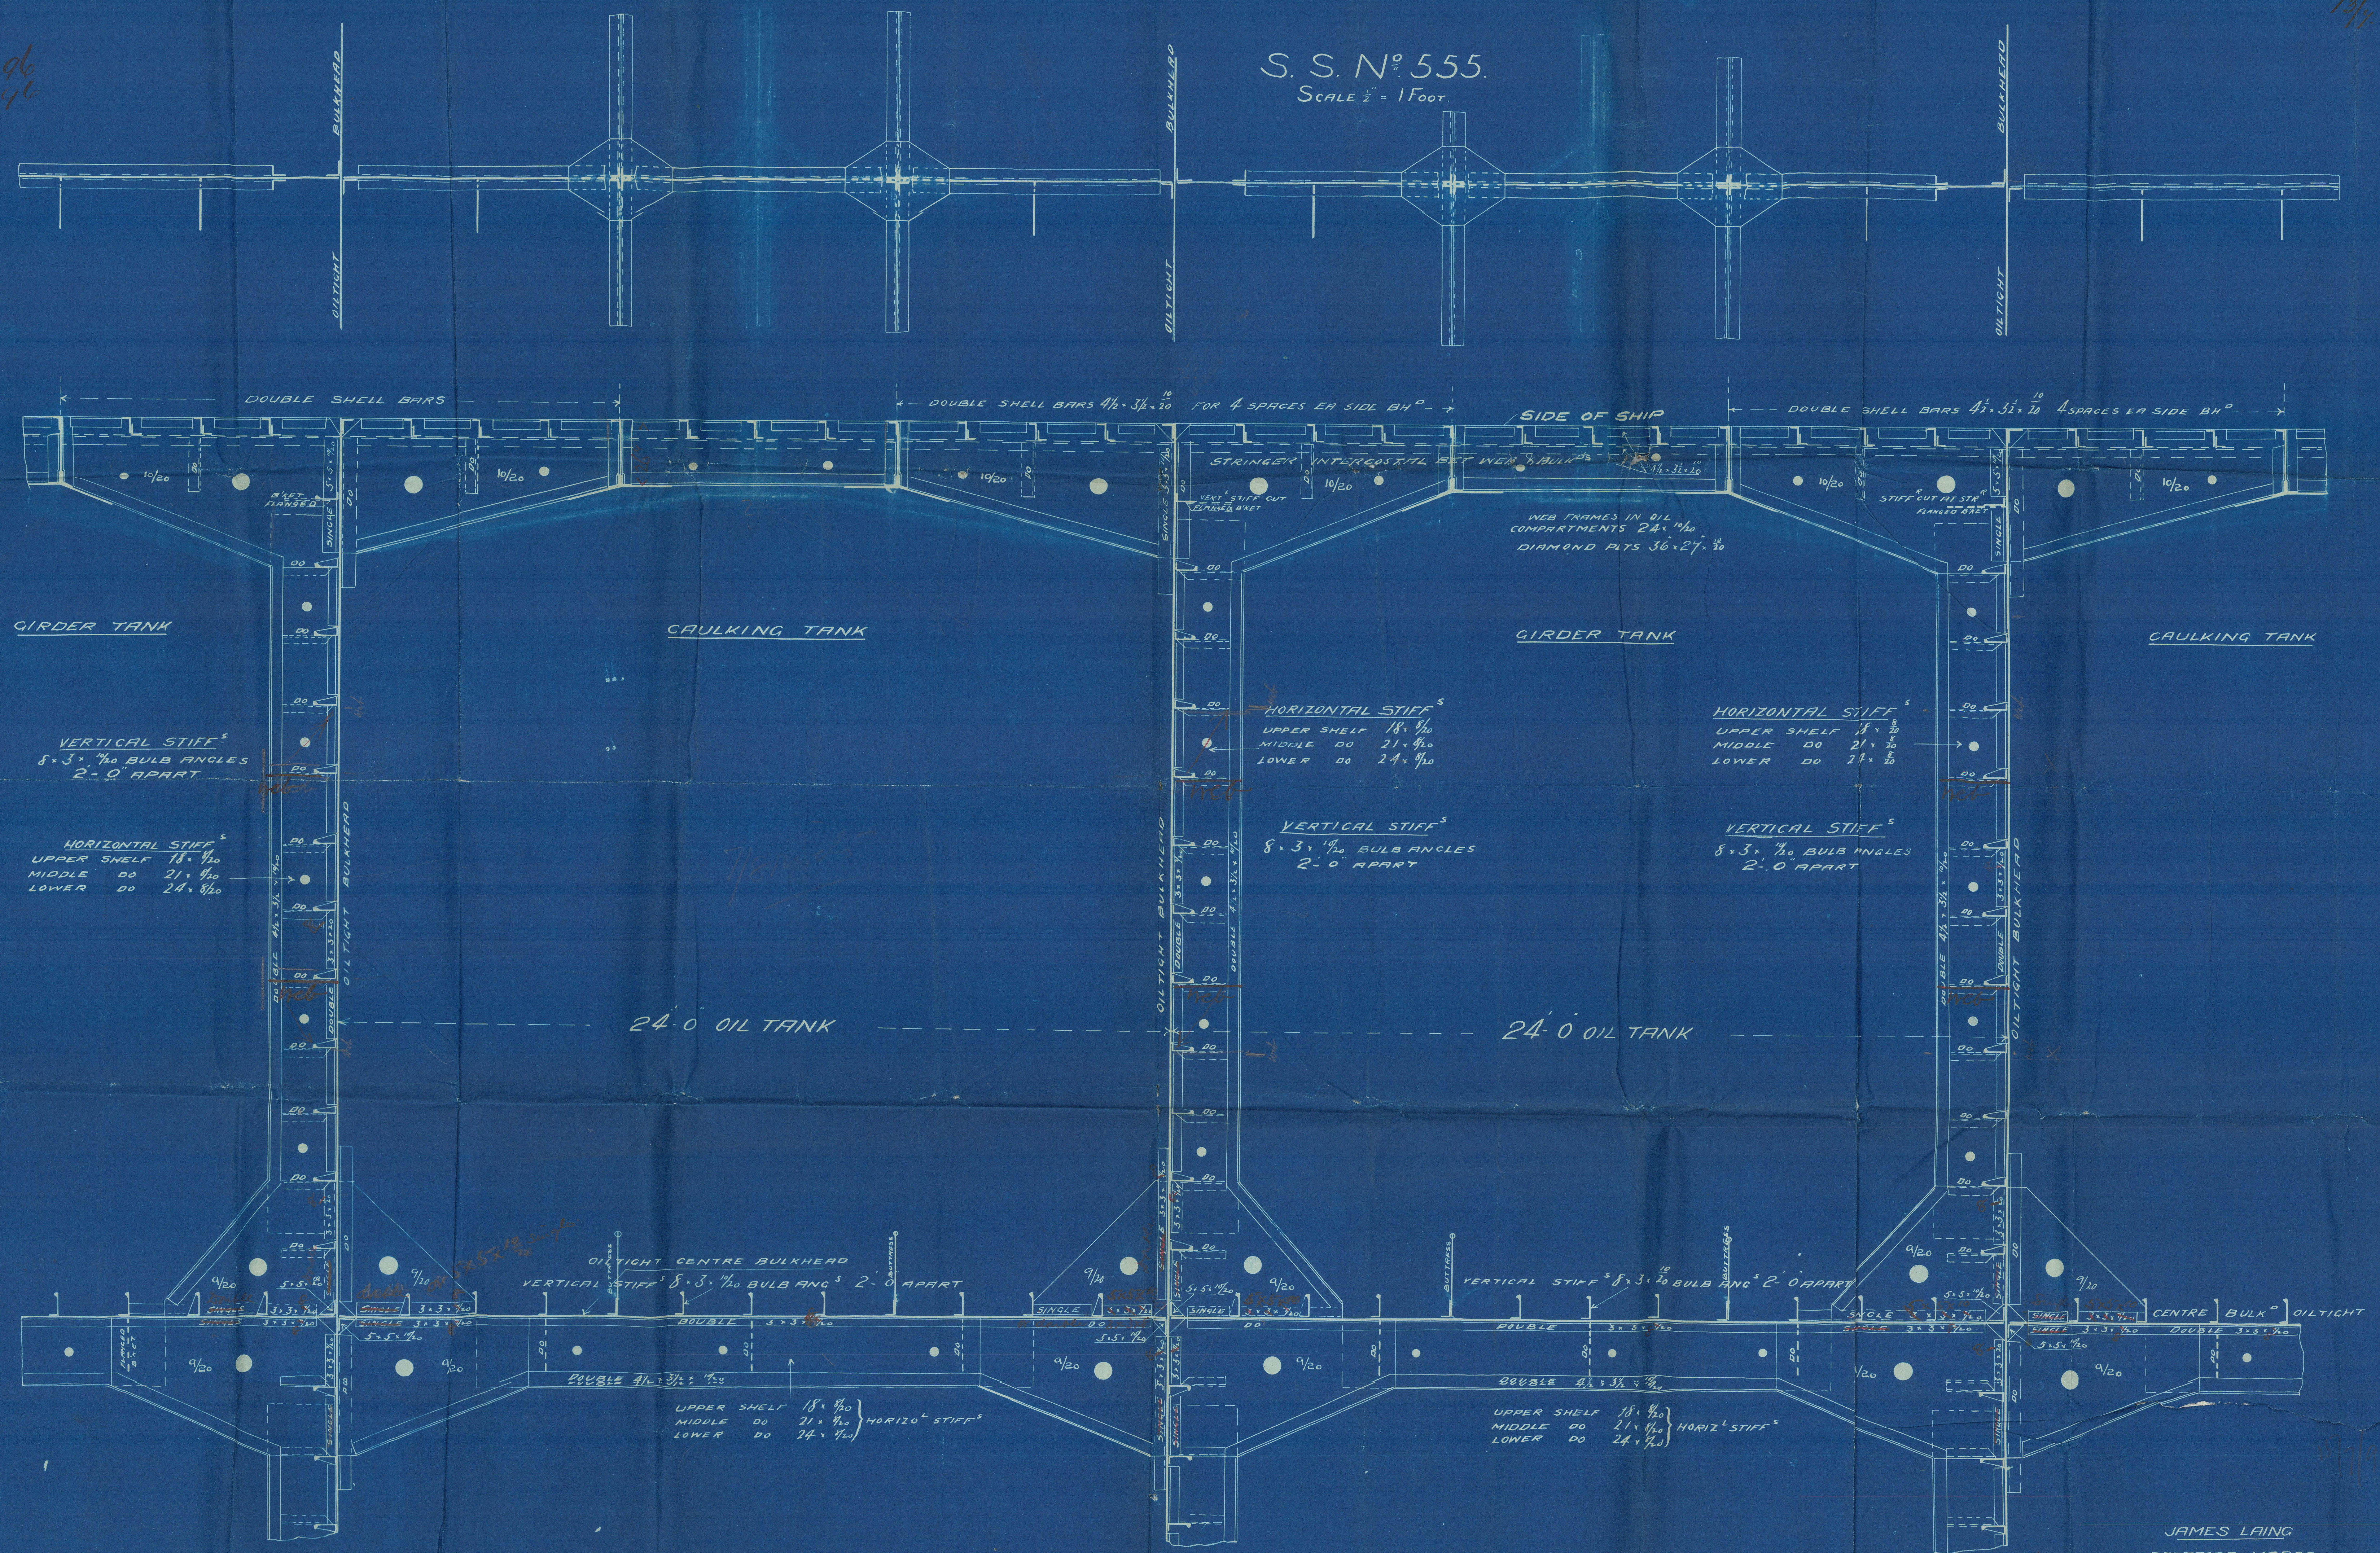

JAMES LAING
DEPTFORD YARDS
SUNDERLAND
5/7/46

SCD 1012-0139

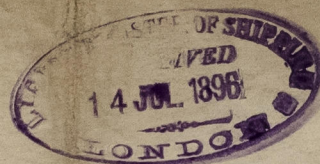


Rainy 5-5-5

Oil Tanks

S.S. "TUSCARORA"
SUNDERLAND. N^o 19342.

Plankhead Steffening

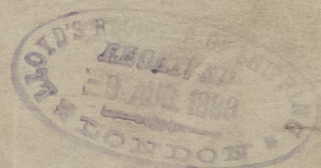

© 2021

Lloyd's Register
Foundation

SLD1012 - 0139