



A.
B.
13/4/96

SCALE 1" = 1 FOOT.


25.7.96
7.8.96

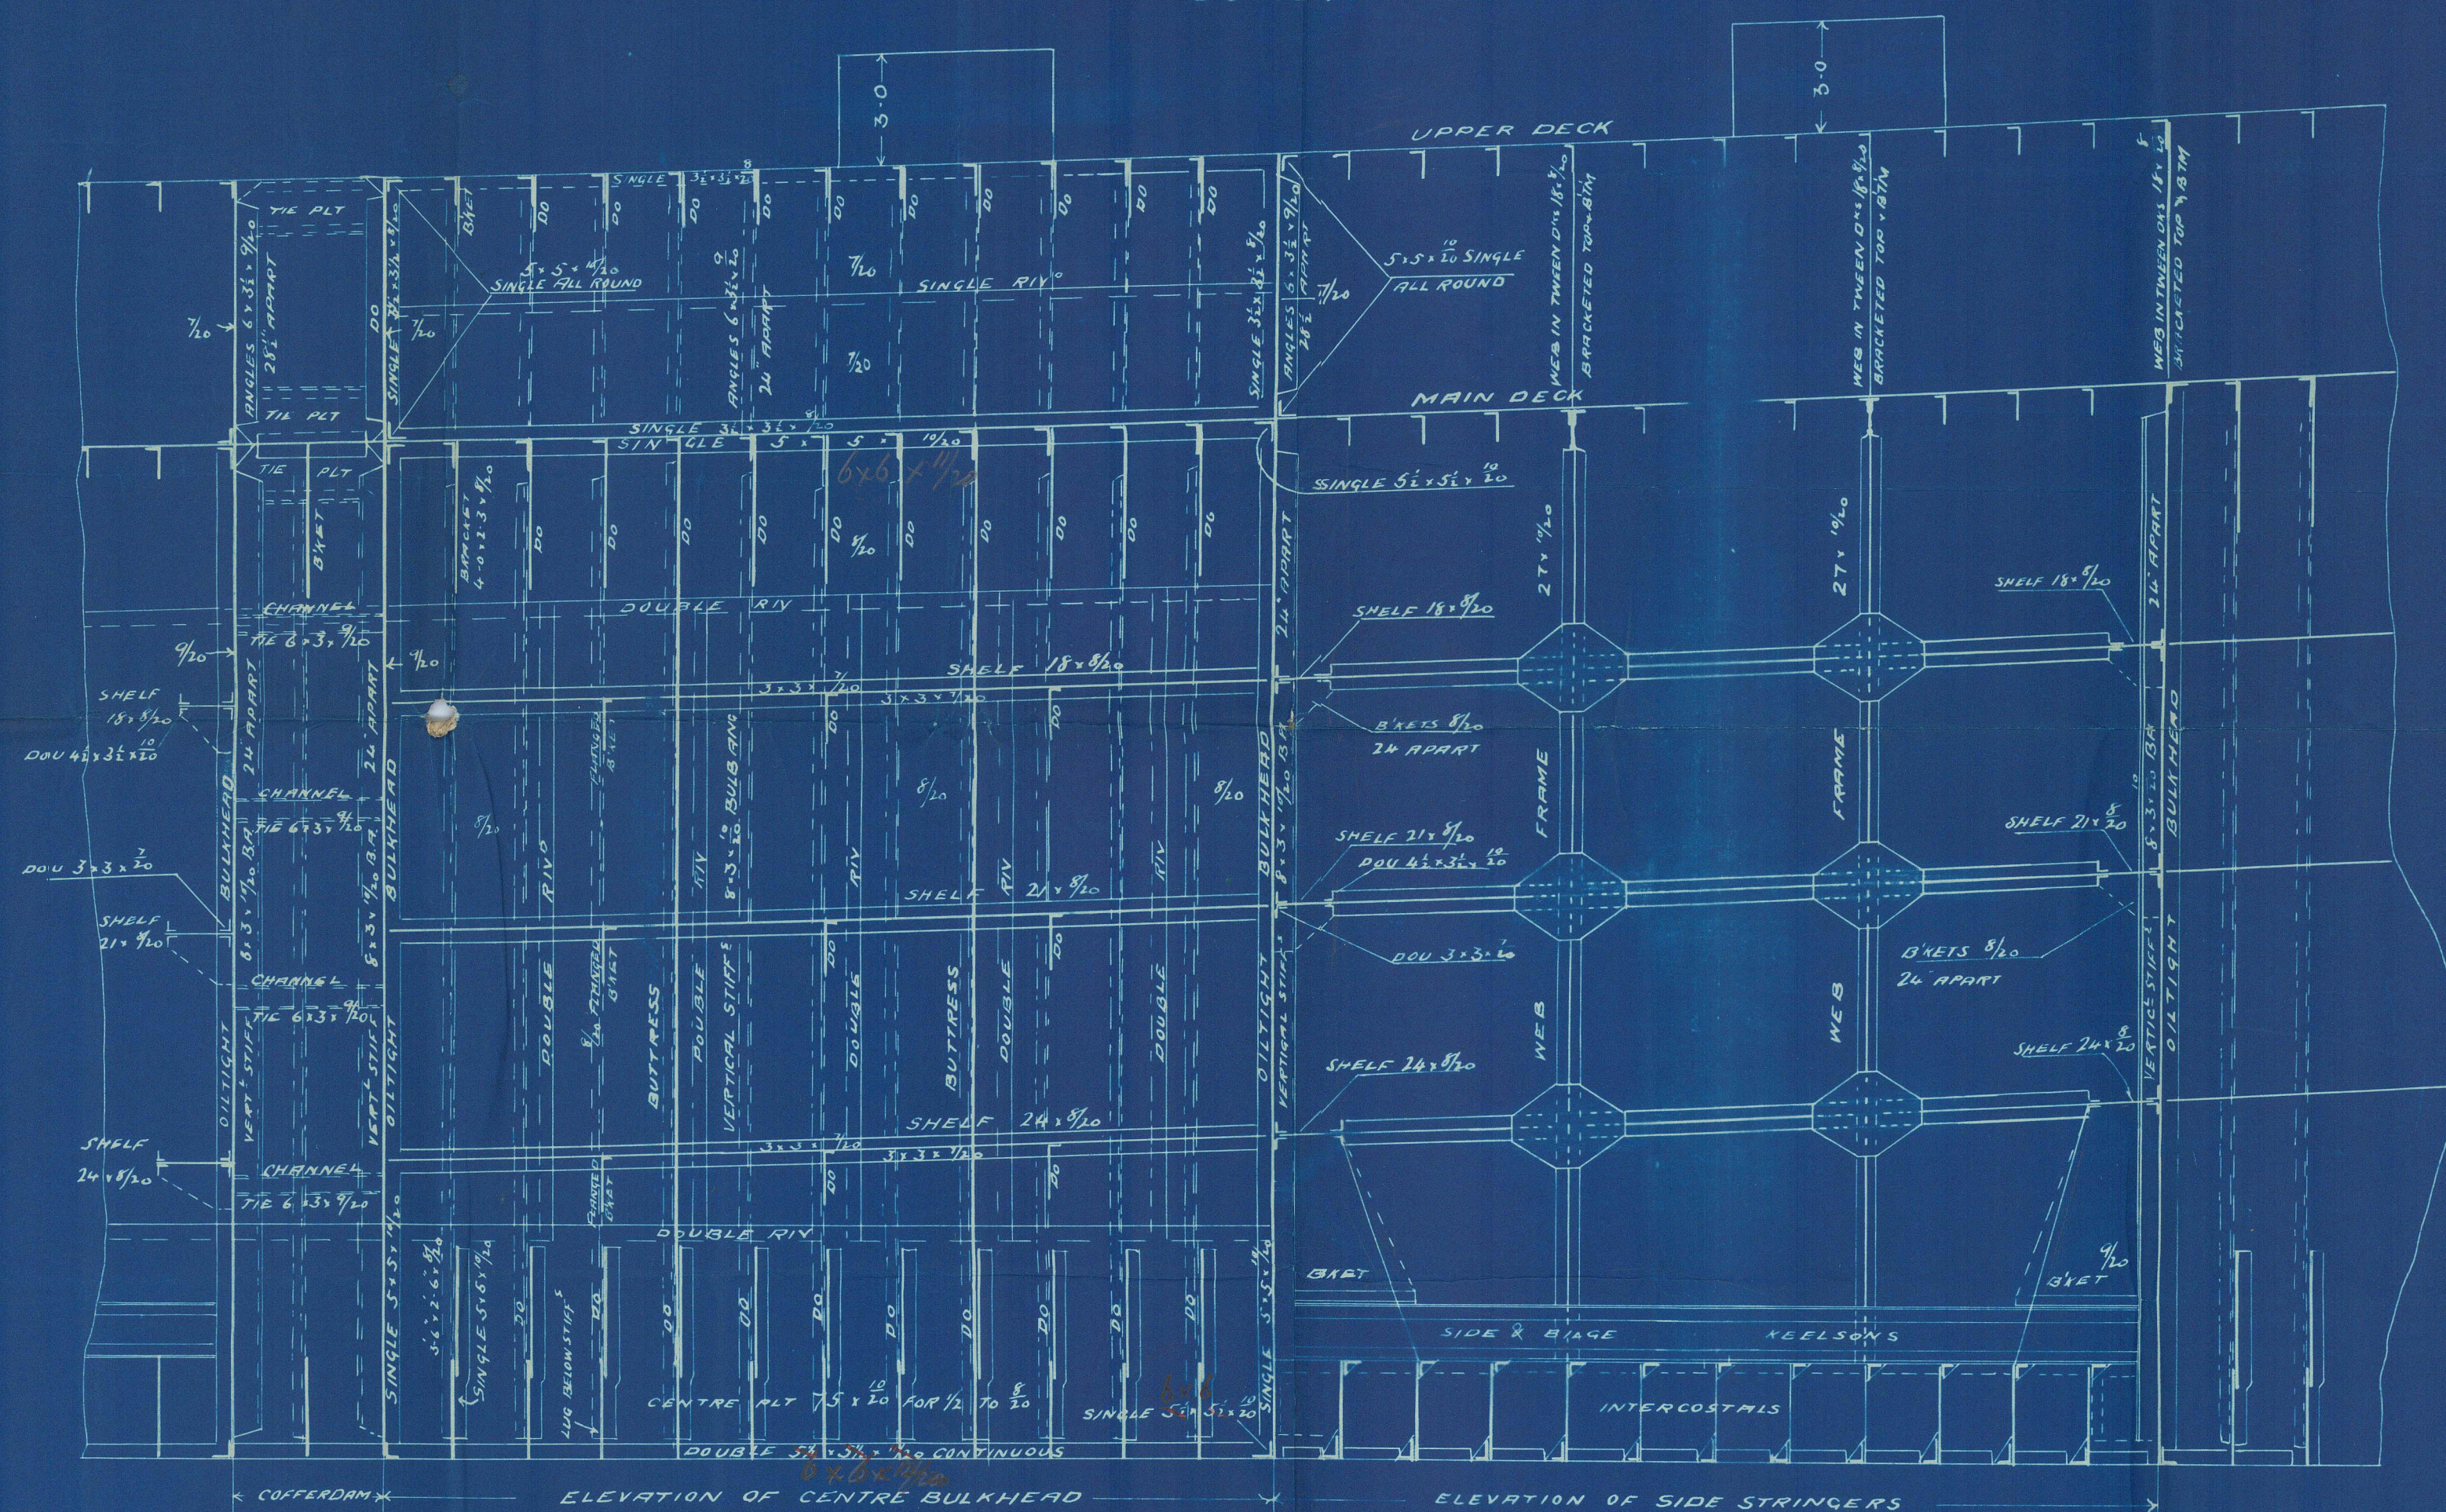

PLAN OF UPPER DECK

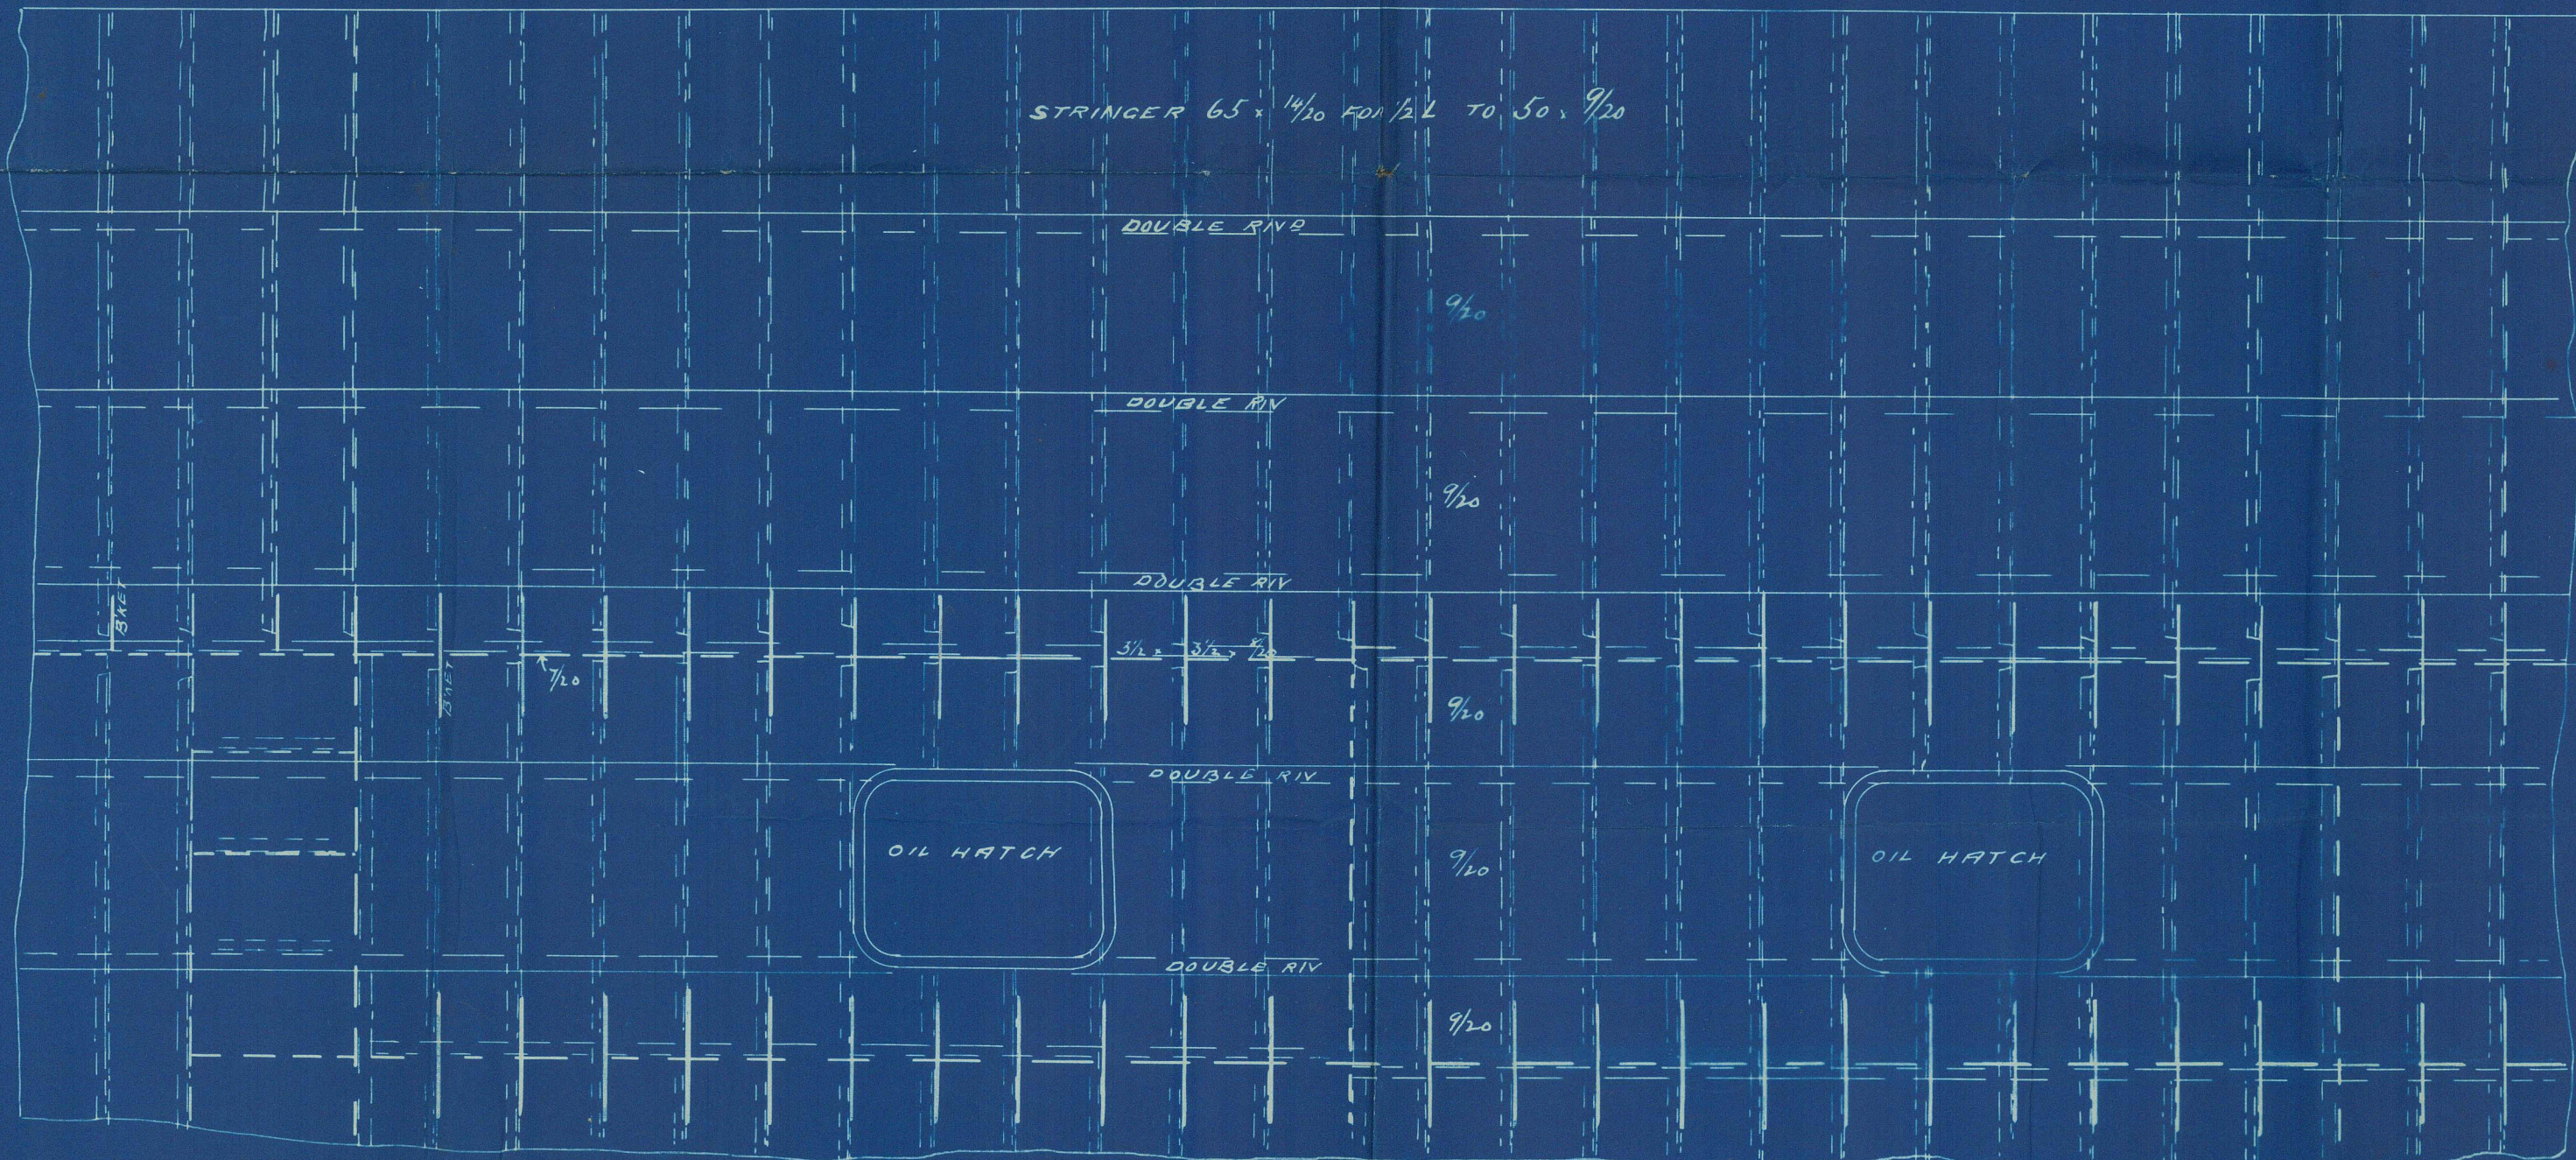


PLAN OF MAIN DECK

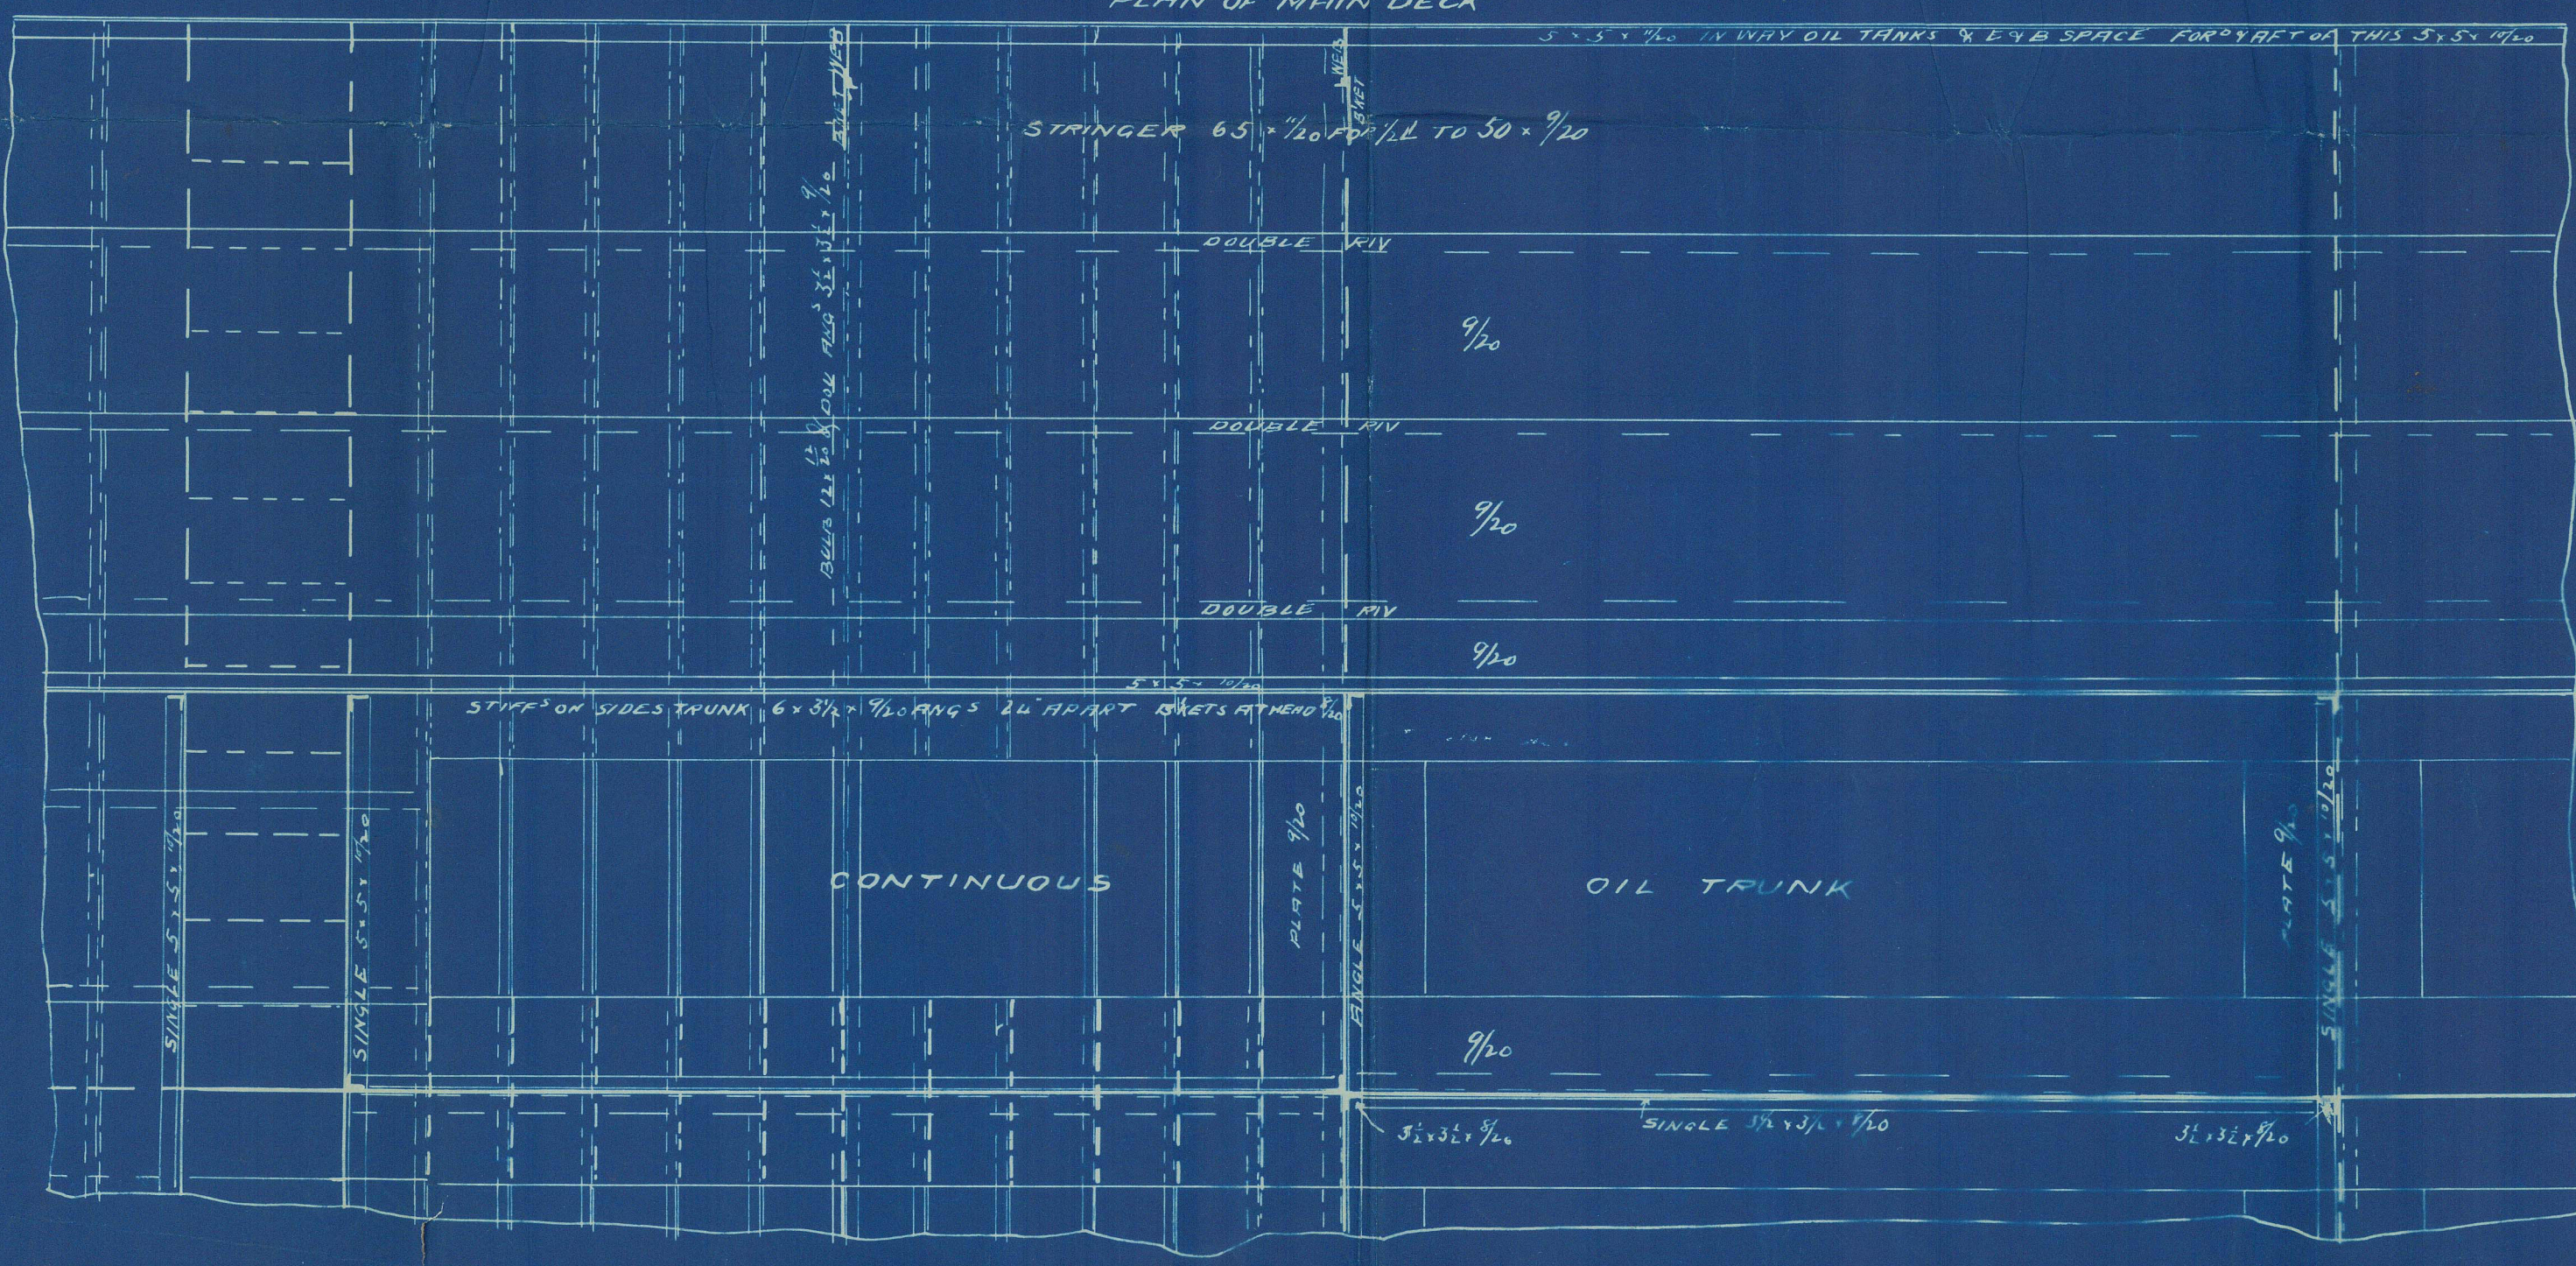

see amendments
on other sketches
15/7/96

JAMES LAING
DEPTFORD YARDS
SUNDERLAND

25/7/96

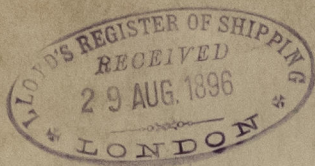

J. Cairns 5-5-5
Centre line Bulkhead

S.S. "TUSCARORA"

SUNDERLAND. N° 19342



© 2021

Lloyd's Register
Foundation

SLD 1012 - 0141

LLOYD'S REGISTER OF SHIPPING
RECEIVED
24 JUL 1896
LONDON

LLOYD'S REGISTER OF SHIPPING
RECEIVED
14 JUL 1896
LONDON

LLOYD'S REGISTER OF SHIPPING
RECEIVED
30 JUL 1896
LONDON

SLD1072 - 0141



© 2021

Lloyd's Register
Foundation