
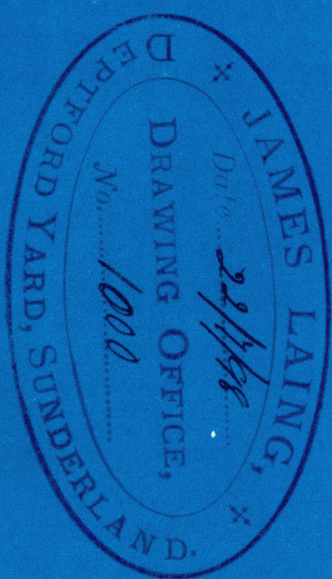


S S N° 555

SCALE $\frac{1}{4}$ " = 1 FT.

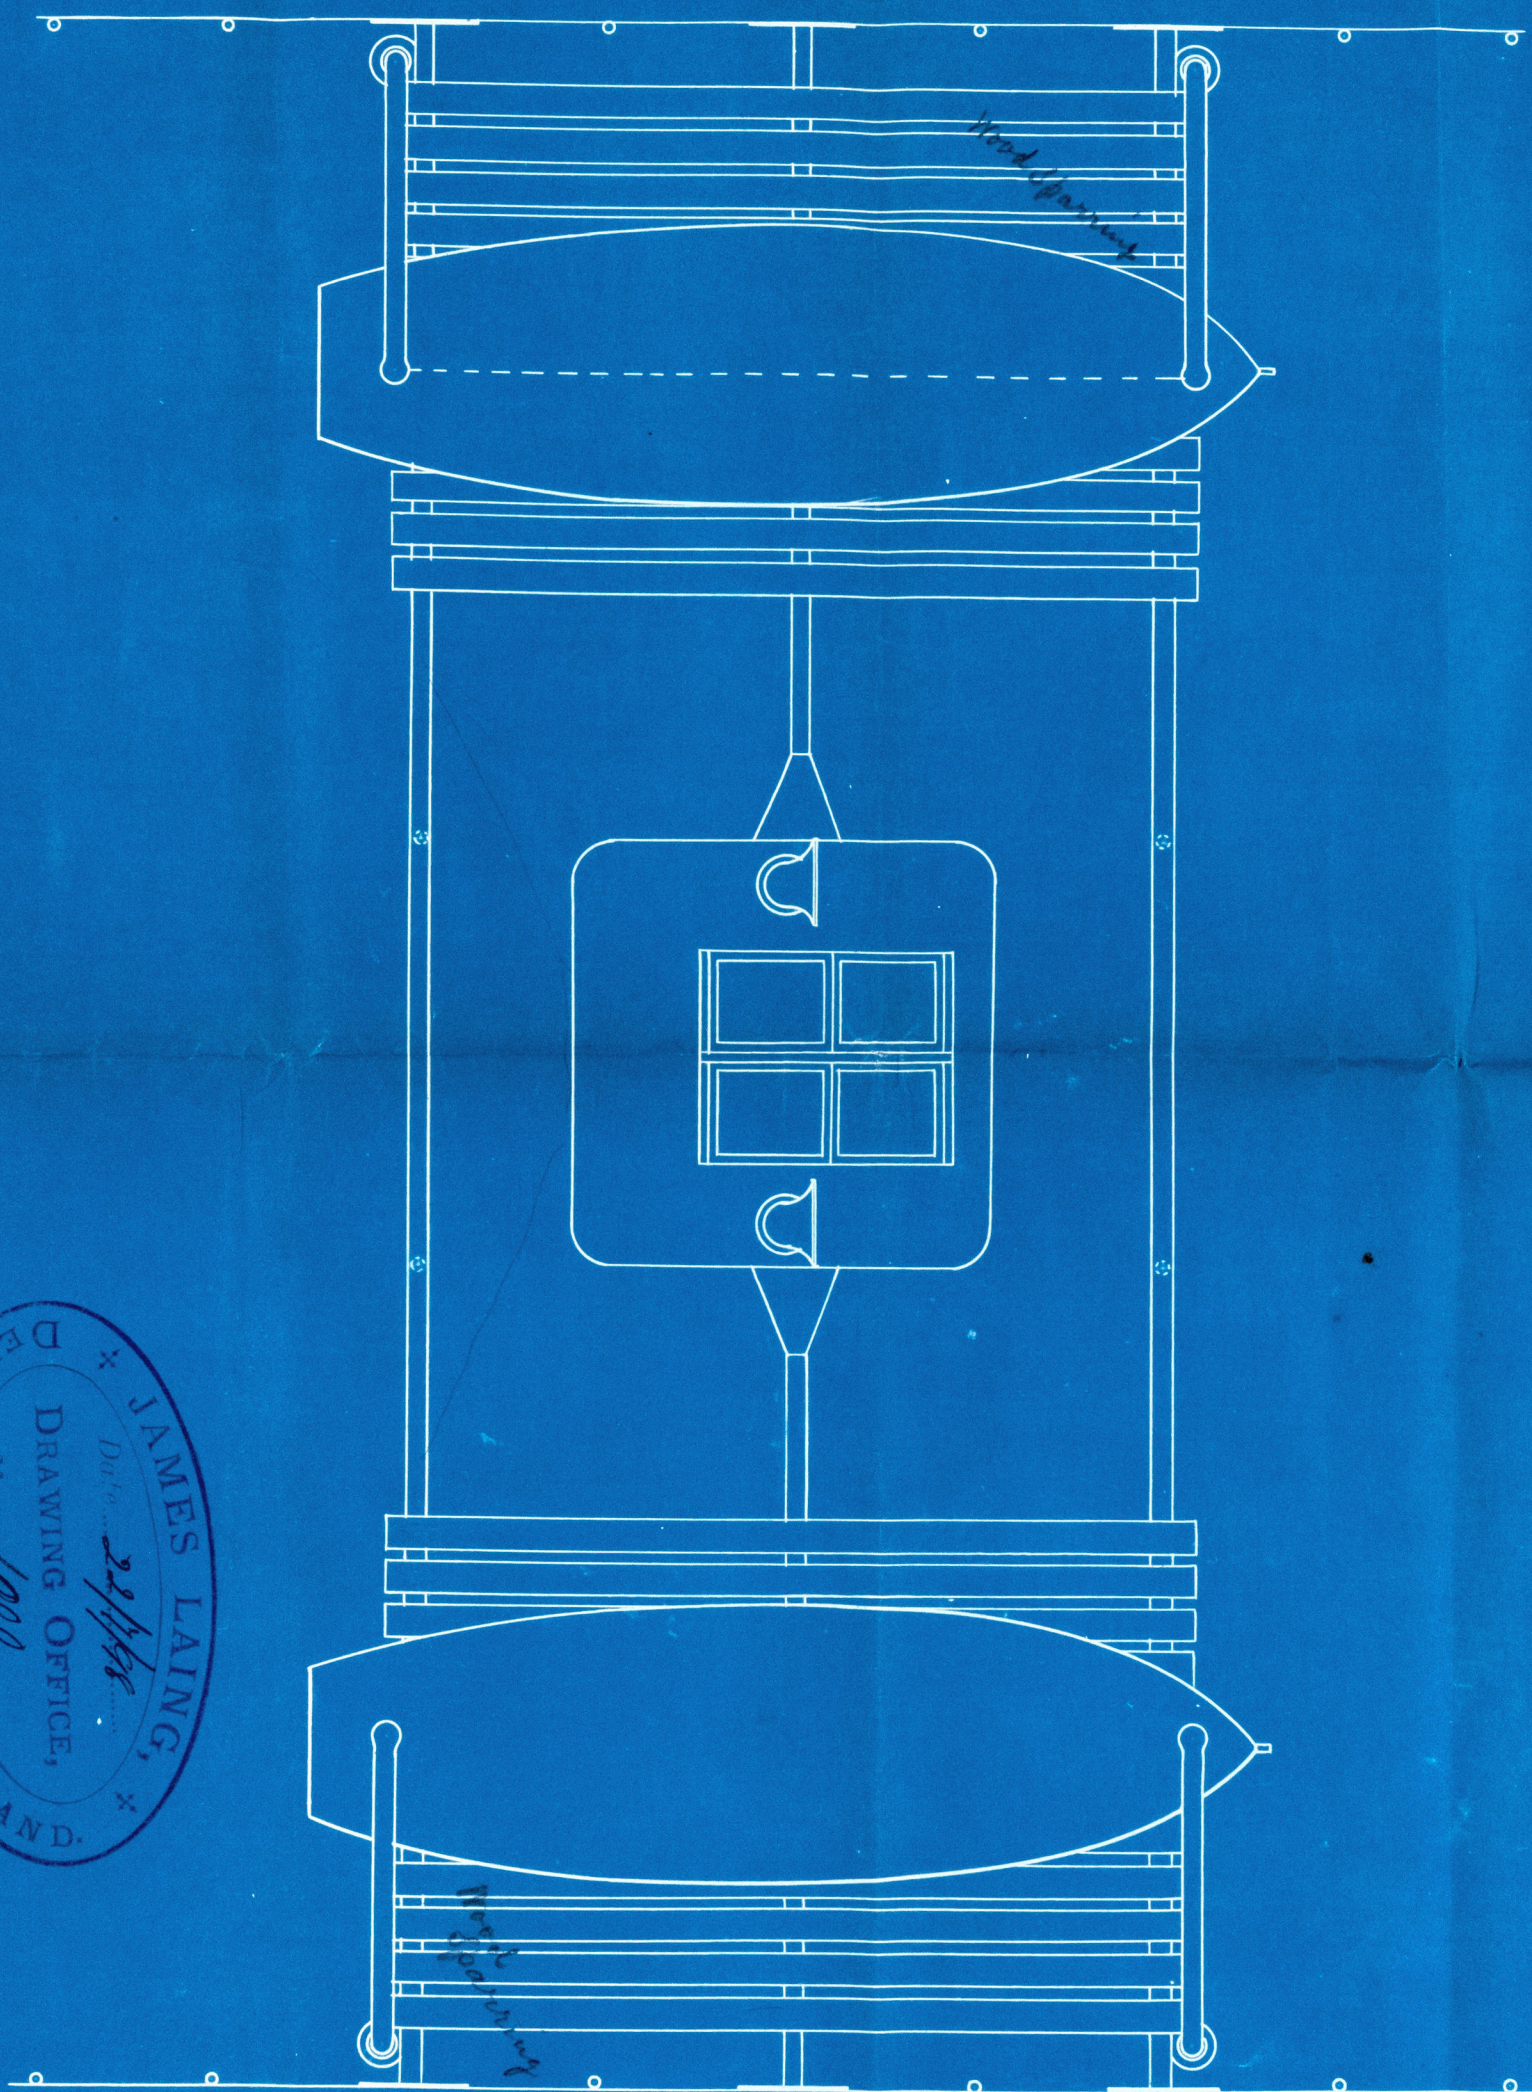

© 2021

Lloyd's Register
Foundation

SLD1012 -0160

Sir James Caird

No. 555.

Boat Skids.

"Ynocarora".

SUNDERLAND. N^o 19342



© 2021

Lloyd's Register
Foundation

SLD 1012 - 0160