




31-8-96

Cast Steel Stem.

S. S. No 555.

Scale 1/2" = 1 Foot.

24.8.96
LLOYD'S REGISTER

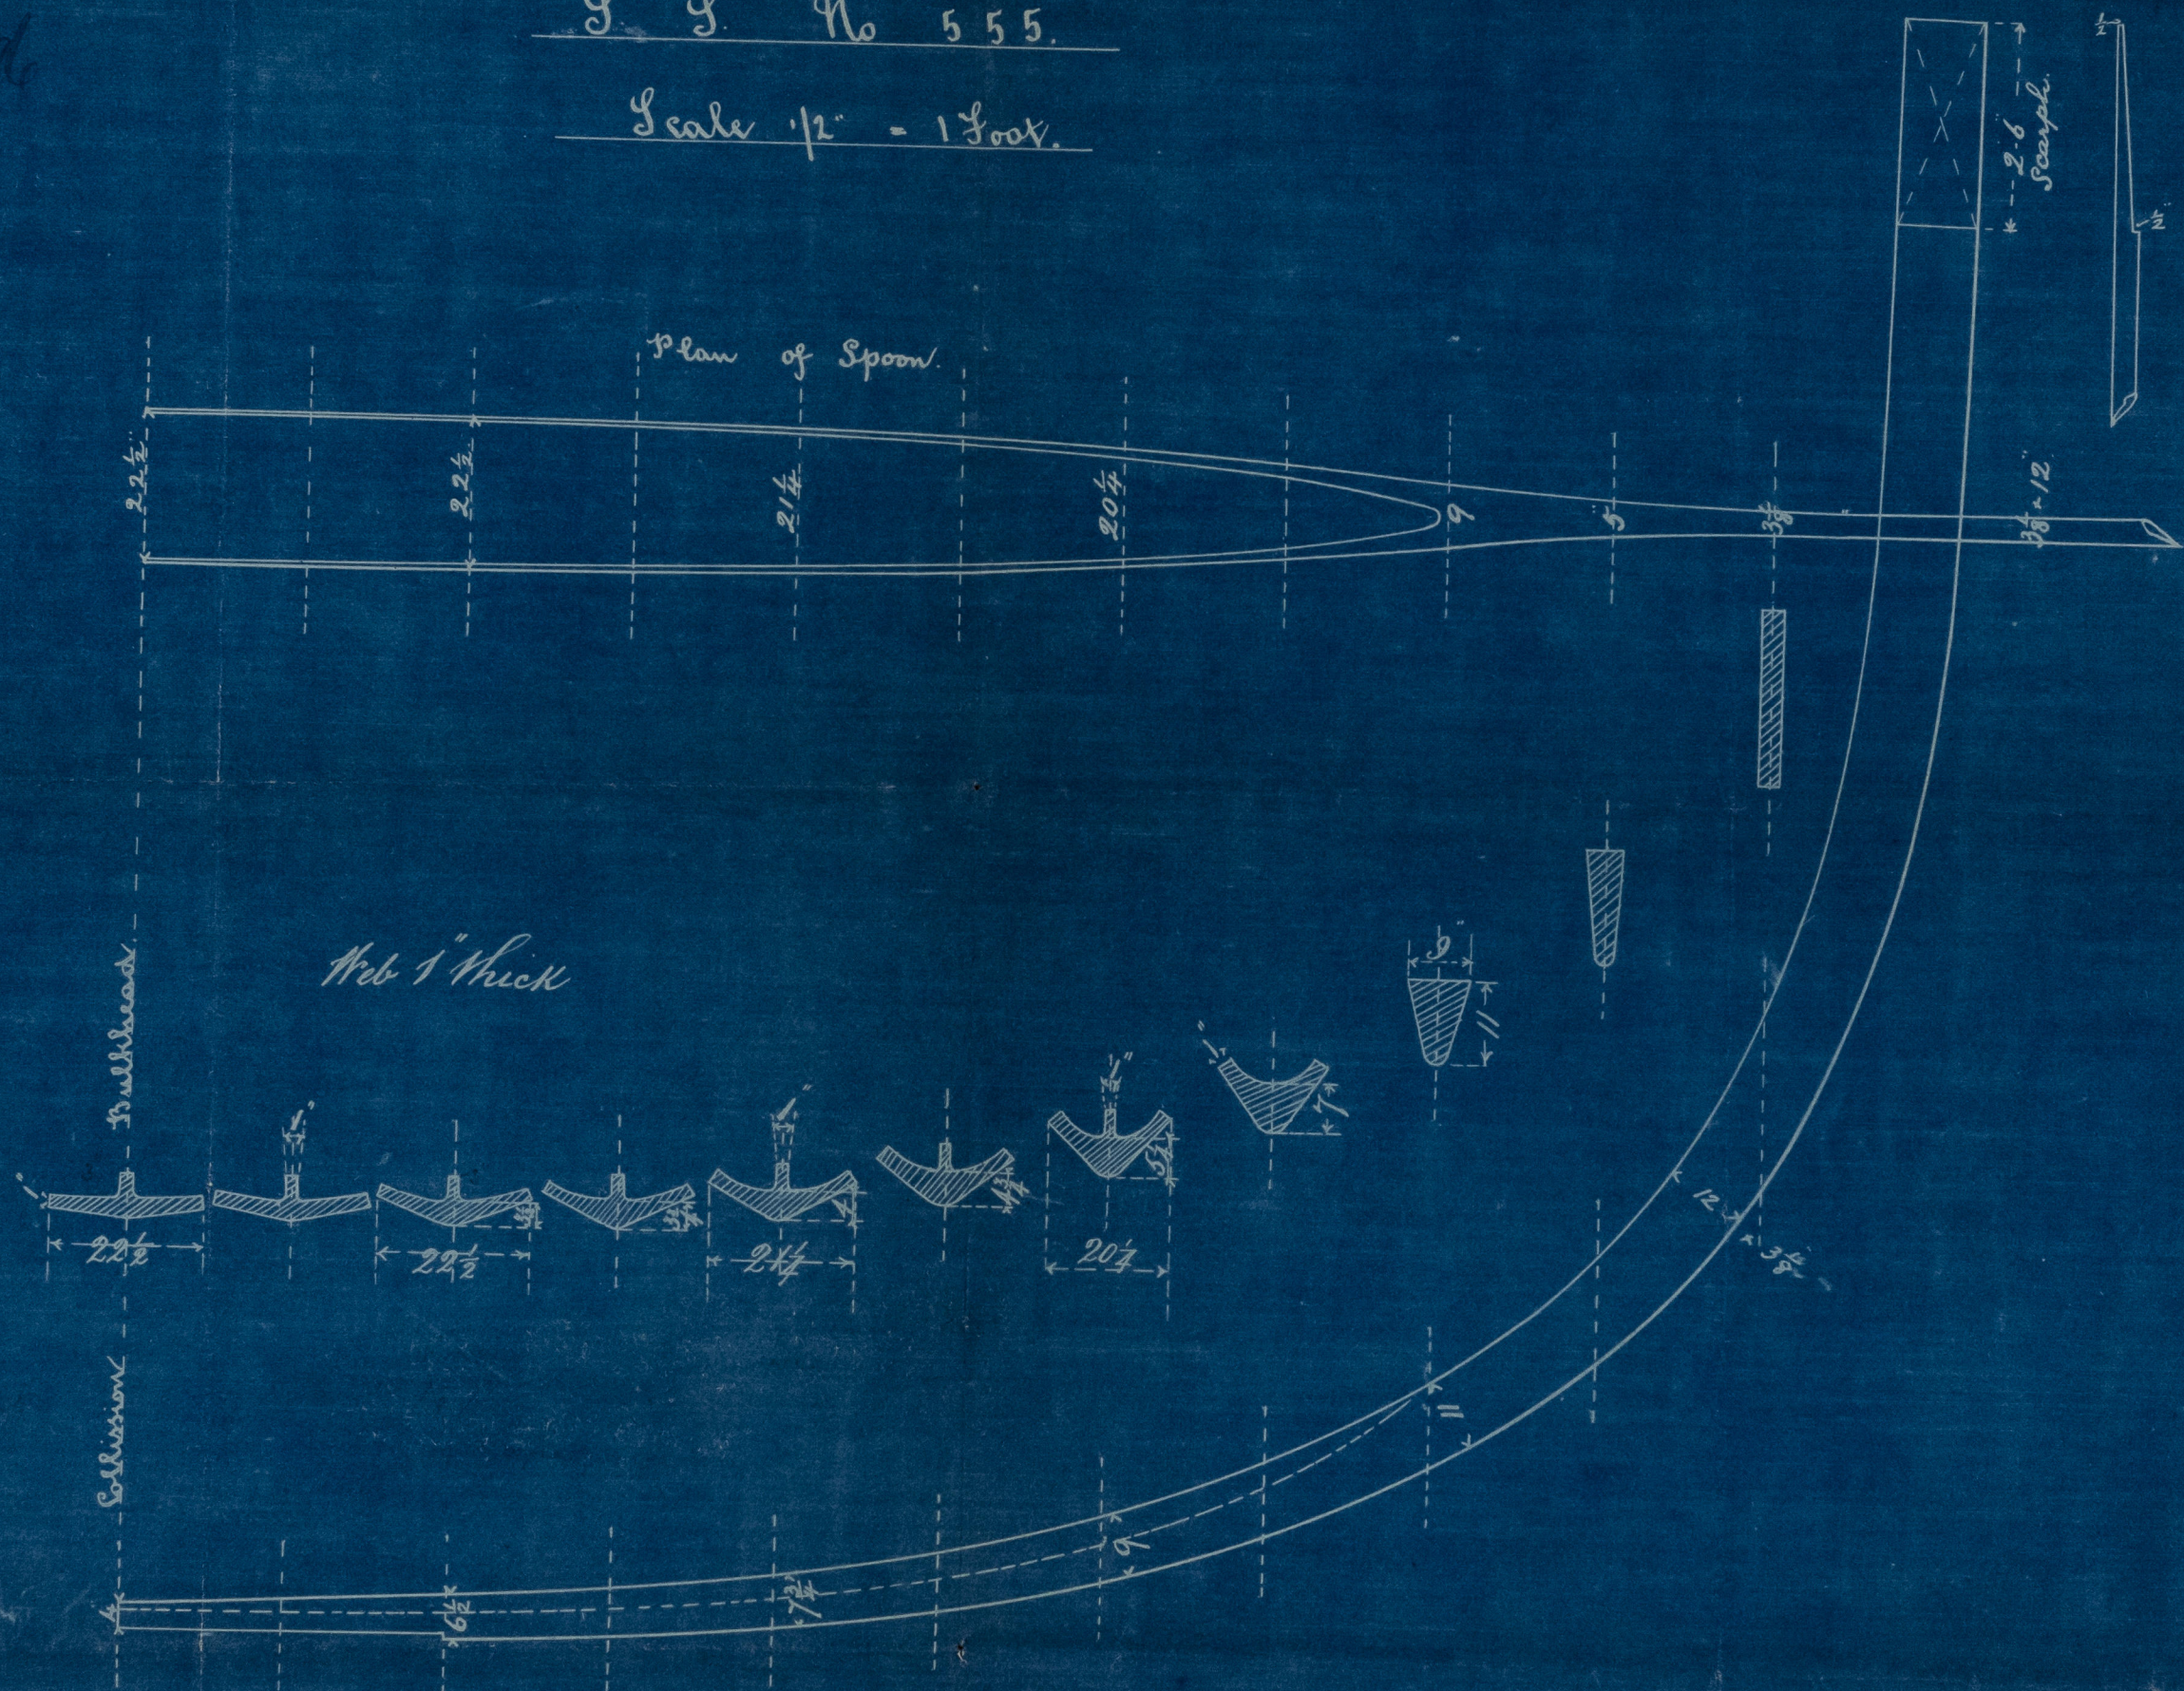


31/8/96



James Laing
Weyford Yards
Sunderland.

SLD 1012 - 0163

James Loring
No 555
S.S. "TUSCARORA" *Lower part of stem*
SUNDERLAND. No 19342

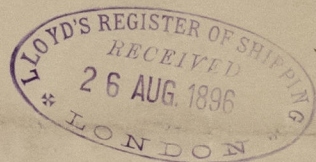

© 2021

Lloyd's Register
Foundation

SLD1012 - 0163