

Lloyd's Register of British and Foreign Shipping.

(Report on Vessel No. 19482 Port Sunderland)Sund
No. 3734 a

SHIP FORGINGS OR CASTINGS.

I have to report that the undermentioned Iron ~~or Steel~~ Forgings ~~or Castings~~,
 manufactured by The Wraith Quay Forge Co.
 of Sunderland for the Vessel No. 94, being built
 by The Strand Slipway Co. of Sunderland
 have been inspected by me as set forth below, and found to be, so far as can be seen,
sound.

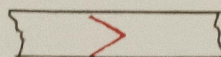
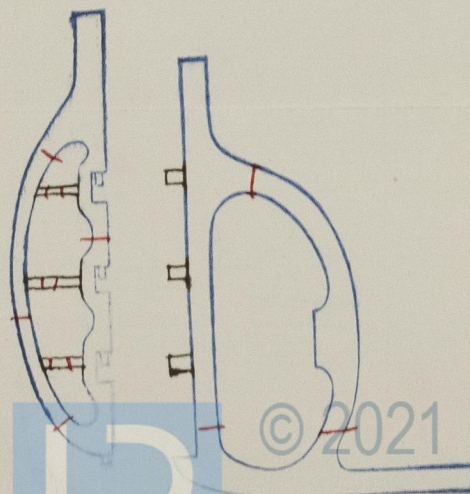
Mark on Forgings.

Lloyd's

No. 3734 aNo. 6-W. H. CameronSunderland
10/10/98

	STERN FRAME.	RUDDER FRAME.	STEM.
Material* ...	<u>Scrap</u>	<u>Scrap</u>	<u>Scrap</u>
How made ...	<u>Forged</u>	<u>Forged</u>	<u>Forged</u>
Dimensions ...	<u>8 1/2 x 5"</u>	<u>7-3 1/2</u>	<u>8 1/2 x 2 1/2</u>
Progress on Inspection	<u>Forged Smithed</u>	<u>Forged Smithed</u>	<u>Forged</u>
Date when Inspected	<u>Dec 7/97 to Jan 27/98</u>	<u>July 5th to Sept 13/98</u>	<u>Jan 17/98</u>

SKETCHES OF FRAMES SHOWING POSITION AND DESCRIPTION OF WELDS OF FORGINGS, OR PARTICULARS OF
 TESTS APPLIED TO CASTINGS.

Welds

Fee (if any chargeable) £ : :

To be paid at

* If of Iron, state whether scrap or puddled Iron.