

Lloyd's Register of British and Foreign Shipping.

(Report on Vessel No. 19482 Port Sunderland)SunderNo. 3734a.

SHIP FORGINGS OR CASTINGS.

I have to report that the undermentioned Iron or ~~Steel~~ Forgings or Castings,
^{Repaired}
 manufactured by The North Quay Forge Co.

of Sunderland for the Vessel No. 94, being built

by The Strand Slipway Co. of Sunderland

have been inspected by me as set forth below, and found to be, so far as can be seen,

sound and efficient. The stern and rudder frames of this vessel
were broken when the ship was launching and have been repaired
as shown on sketch



Mark on Forgings.

Lloyd's

No 3734aNo. 6.W. H. CameronSunderland
3.12.98

	STERN FRAME.	RUDDER FRAME.	STEM.
Material* ...			
How made ...			
Dimensions ...			
Progress on Inspection	<u>Repairing</u>	<u>Repairing</u>	
Date when Inspected	<u>Oct 24th to Nov 7/98</u>	<u>Oct 19th to Nov 12/98</u>	

SKETCHES OF FRAMES SHOWING POSITION AND DESCRIPTION OF WELDS OF FORGINGS, OR PARTICULARS OF TESTS APPLIED TO CASTINGS.

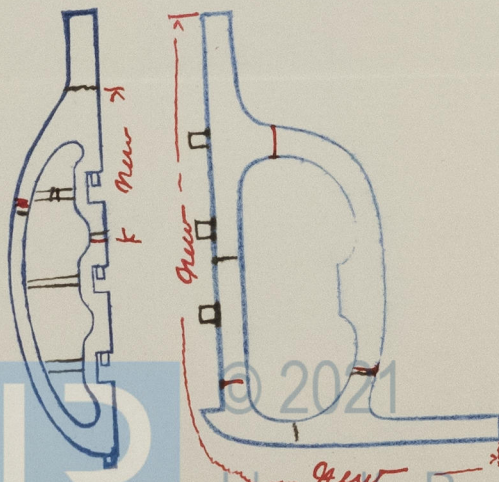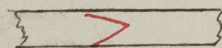

Fee (if any chargeable) £

To be paid at

* If of Iron, state whether scrap or puddled Iron.