

# Midship Section N<sup>o</sup> 94SS and N<sup>o</sup> 98.

Scale  $\frac{1}{2}$ " = 1 foot

Class 100 A1

258.0 x 36.8 x 19.2 Moulded at Side

also N<sup>o</sup> 100

appo. 22/1/98


appo. 15/2/99

23.11.97

6.7.98

22.4.98 (N<sup>o</sup> 98)

15.2.99

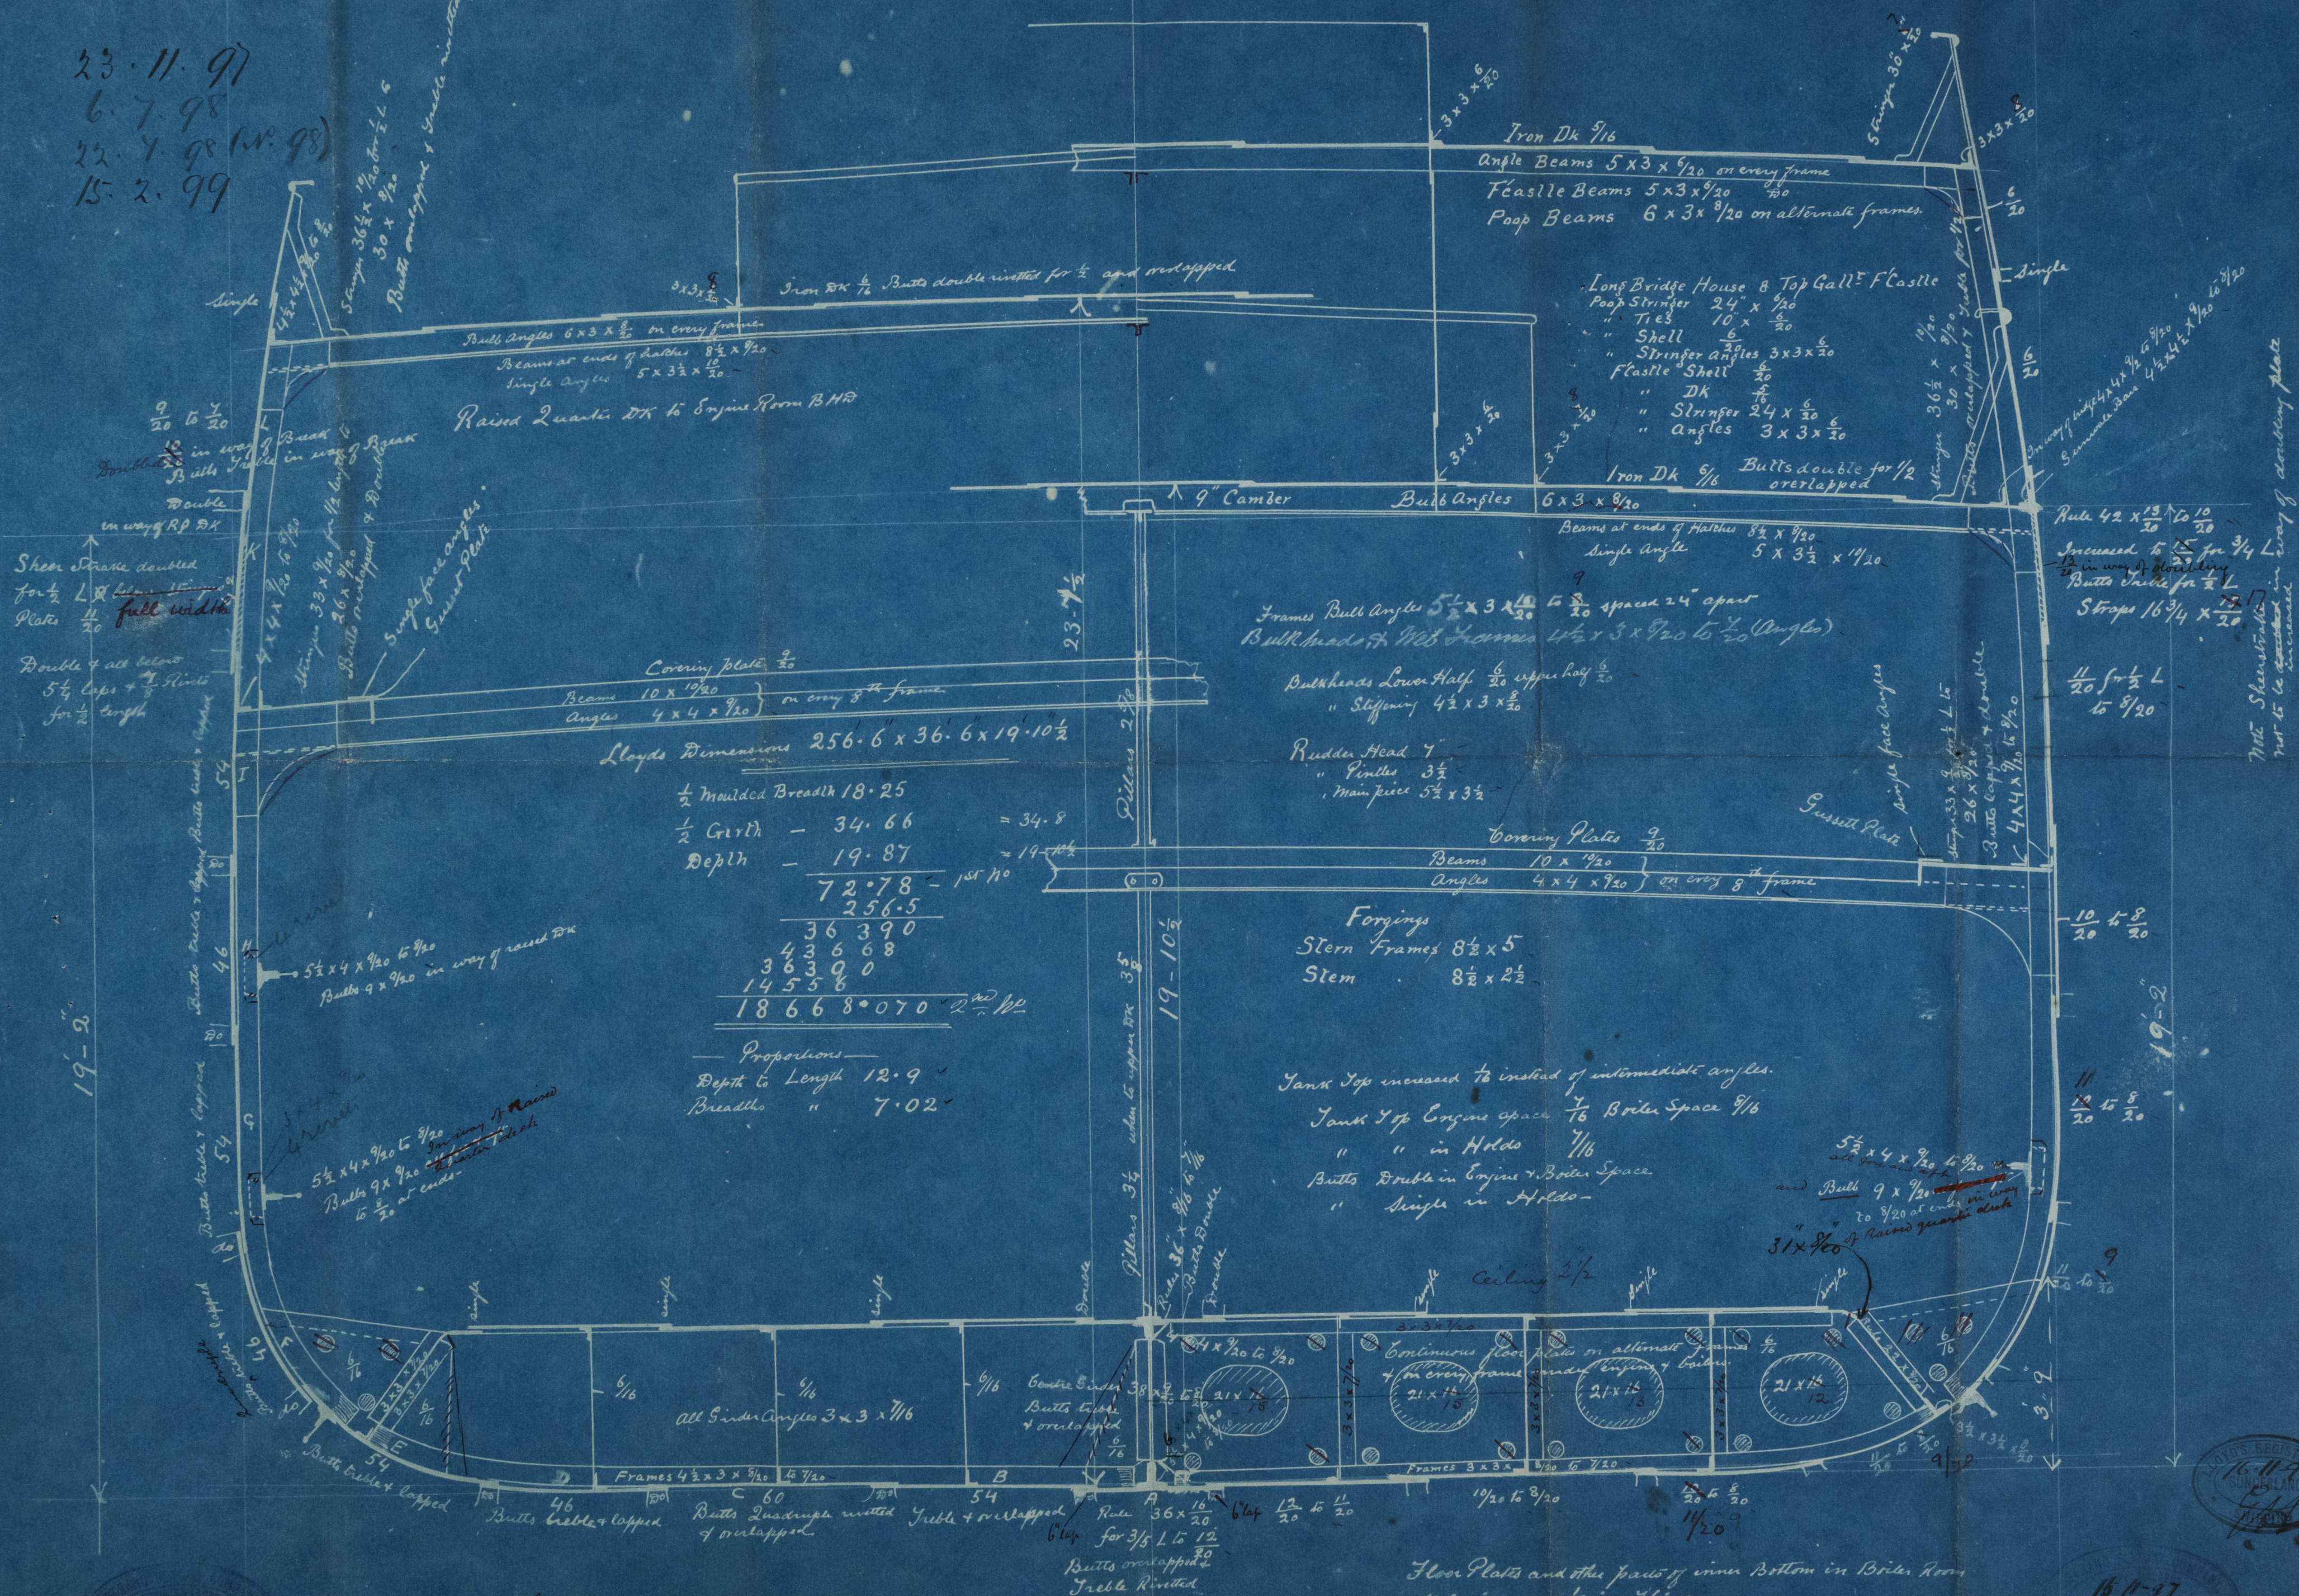




SL1015-0037



Strand Slipway Co.  
— No 94 —

Midship Section

~~X~~ S. S. "Abchurch"  
Sd 19482

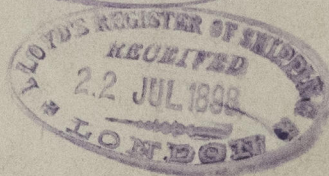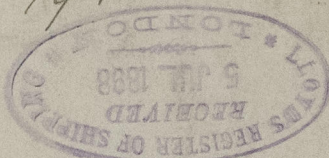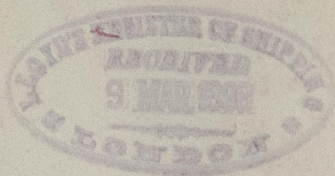



Also No 98 appo. 22/7/98

S. S. Gottfried

Sunderland. No 19697

S. S. Aline Montreuil

Sunderland. No 20103

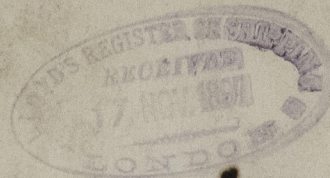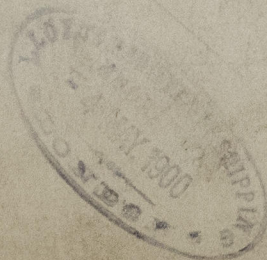

© 2021

Lloyd's Register  
Foundation

5101475-2000