
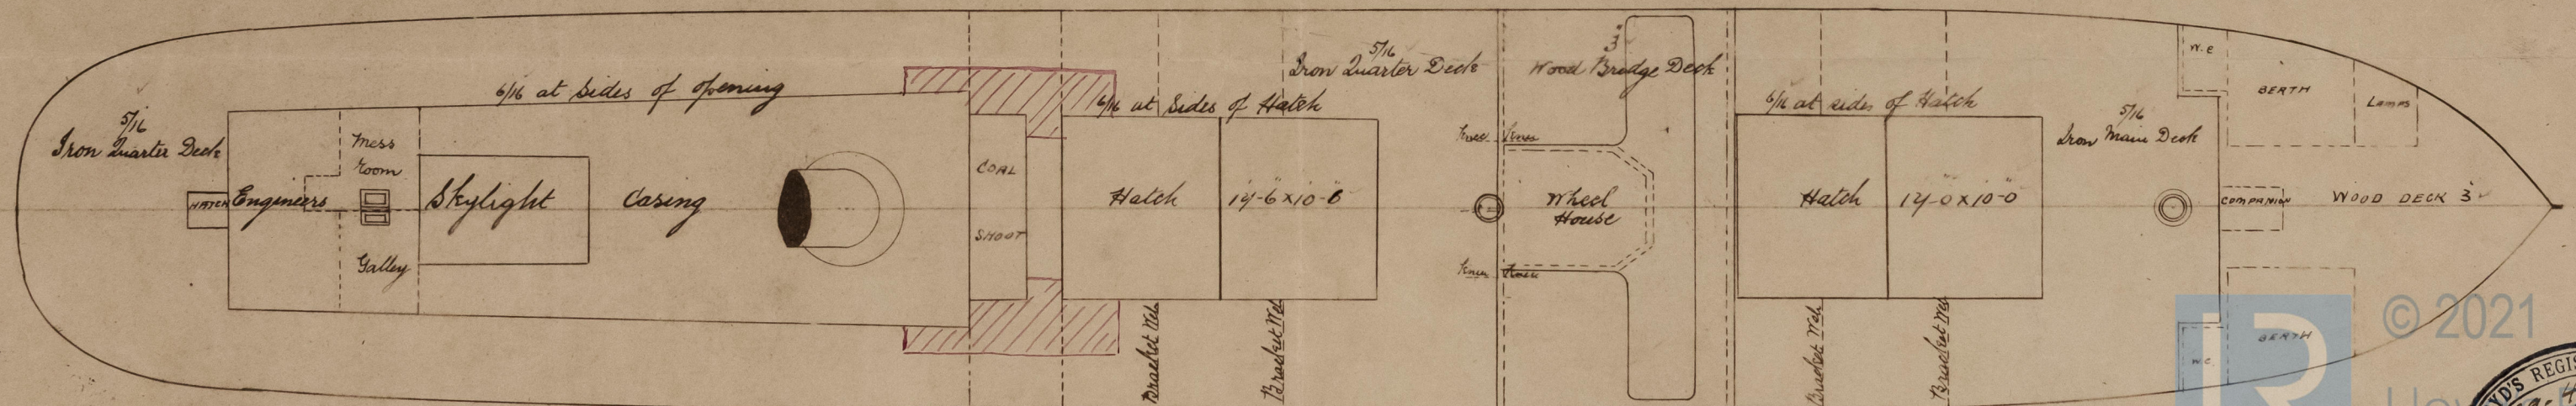
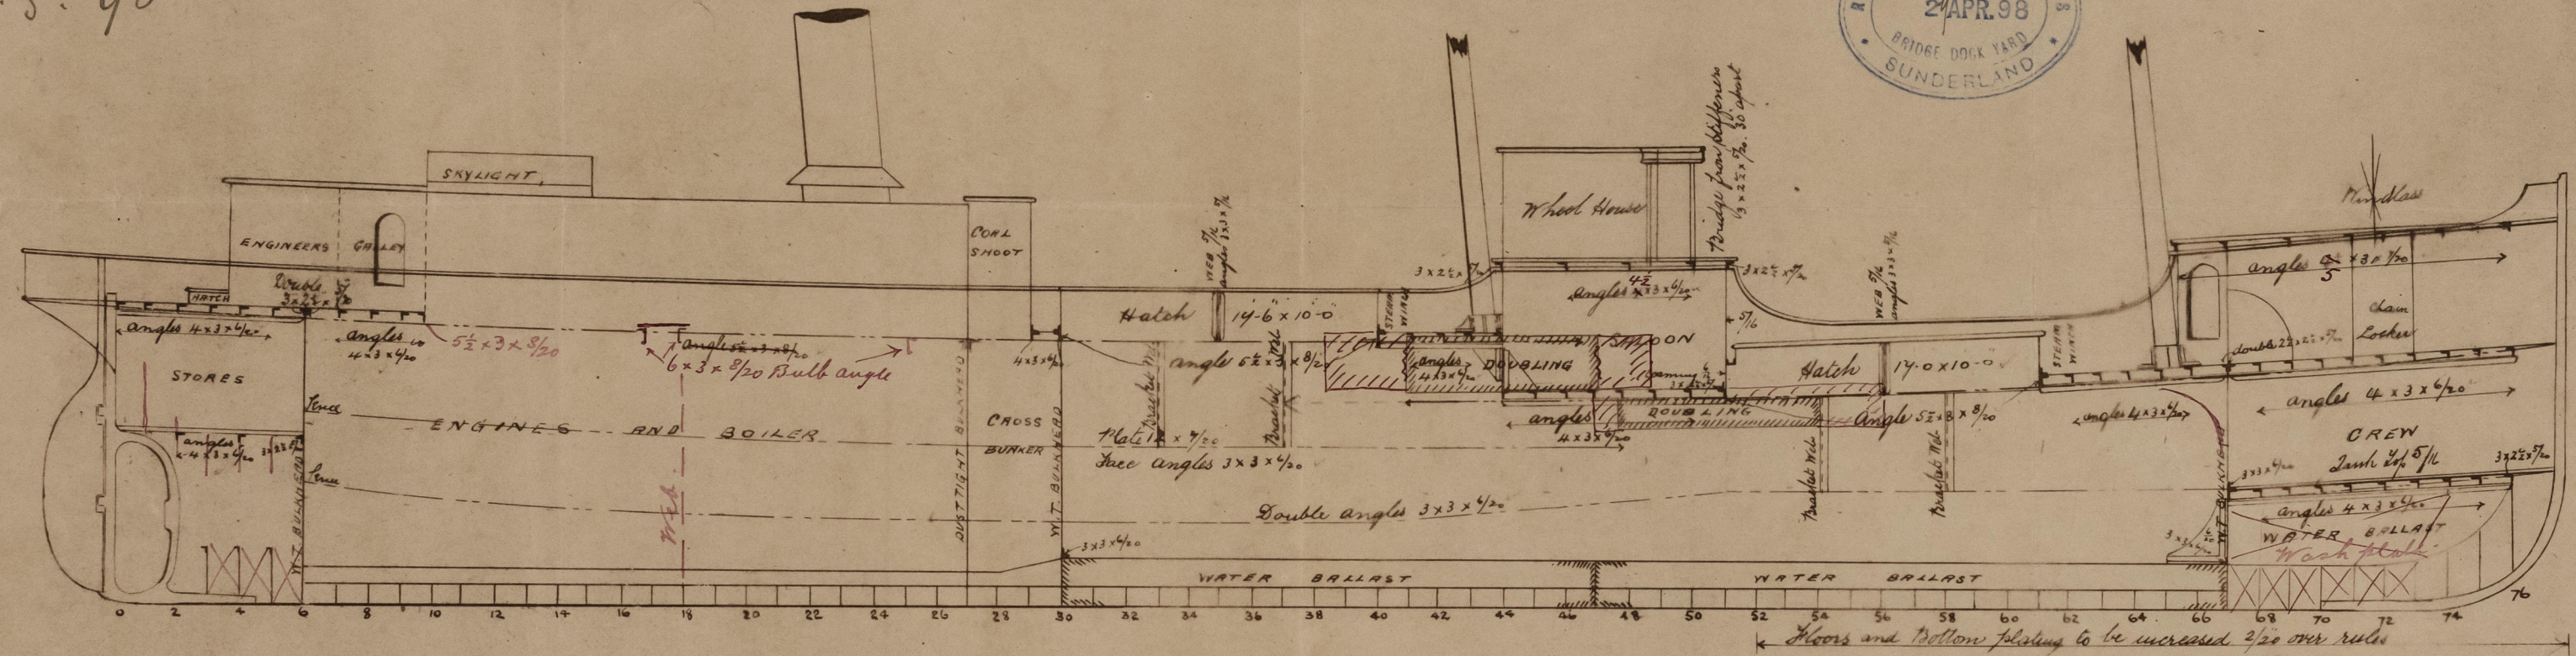


2.5.98


— S. S. No 207 —
— Beam Arrangement —
— Scale 1 Foot —

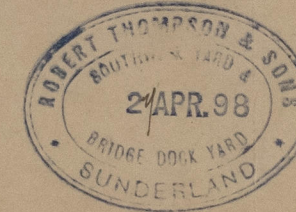

J.P.V.
25/98

© 2021



SLD1016-0165

R. THOMPSON & SONS

— S. S. N° 207 —

PROFILE



S. S. "Fremington"

Sunderland. No. 19571



© 2021

Lloyd's Register
Foundation