

S. S. Fremington

Received at

Office,

Lloyd's Register of British and Foreign Shipping.

(Report on Vessel No. 19571 Port Sunderland)

Sound

No. 3880 a

SHIP FORGINGS OR CASTINGS.

I have to report that the undermentioned Iron or Steel Forgings or Castings, manufactured by Messrs R S Bagnall Sons of Wylton for the Vessel No. 207, being built by Messrs R Thompson Sons of Sunderland have been inspected by me as set forth below, and found to be, so far as can be seen, Sound

Mark on Forgings.

Lloyd's

No. 3880 a


N. 6.

Wylton


Sunderland  
19/10/98

	STERN FRAME.	RUDDER FRAME.	STEM.
Material* ... ..	<u>Scrap</u>	<u>Scrap</u>	<u>Scrap</u>
How made ... ..	<u>Forged</u>	<u>Forged</u>	<u>Forged</u>
Dimensions ... ..	<u>6 x 3"</u>	<u>4 1/2 - 2 1/4</u>	<u>6 x 1 3/8</u>
Progress on Inspection	<u>Forged &amp; smoothed</u>	<u>Forged &amp; smoothed</u>	<u>Forged</u>
Date when Inspected	<u>May 25<sup>th</sup> to June 18/98</u>	<u>Aug 18<sup>th</sup> to Sept 24/98</u>	<u>June 18/98</u>

SKETCHES OF FRAMES SHOWING POSITION AND DESCRIPTION OF WELDS OF FORGINGS, OR PARTICULARS OF TESTS APPLIED TO CASTINGS.

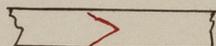

Welds

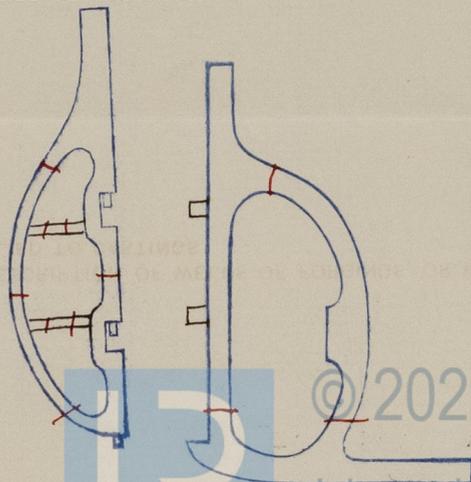

Fee (if any chargeable) £ : :

To be paid at

\* If of Iron, state whether scrap or puddled Iron.