

<u>— Anchors and Chains —</u>	
<u>Equipment No 6587</u>	
1 Bower Anchor	8-1.0 Stockless
1 " "	8 0 0
Collector	10-1 0
1 Stream Anchor	2 0 0 Ex. of stock
1 Redge "	1 0 0
165 fms of $3\frac{1}{2}$ " stud chain cable.	
45 "	$1\frac{1}{2}$ " stream chain or $2\frac{1}{2}$ " stockless
45 "	4' hump Lowses or $2\frac{1}{2}$ "
90 "	5' " Hammer or $1\frac{1}{4}$ "


MIDSHIP SECTION

Length B. P.	136-0
" for Lloyds	135-0
Breadth Extreme	23-2
Moulded	23-0
Depth of Hold to Lloyds floor	10-7
Moulded	11-2

Scale $\frac{1}{2}'' = \text{One ft}$
Class 100 A1. STEEL

ROBERT THOMPSON & SONS
BRIDGE DOCK YARD
SUNDERLAND
24 APR. 93

A circular library stamp in blue ink. The outer ring contains the text "ROBERT THOMSON & SONS" at the top and "SUNDERLAND" at the bottom, separated by two small stars. Inside the ring, the text "SOUTHAMPTON" is at the top and "BRIDGE DOCK YARD" is at the bottom. In the center, the date "24 APR. 98" is stamped, with a handwritten mark resembling a stylized "M" or "24" over the "APR".

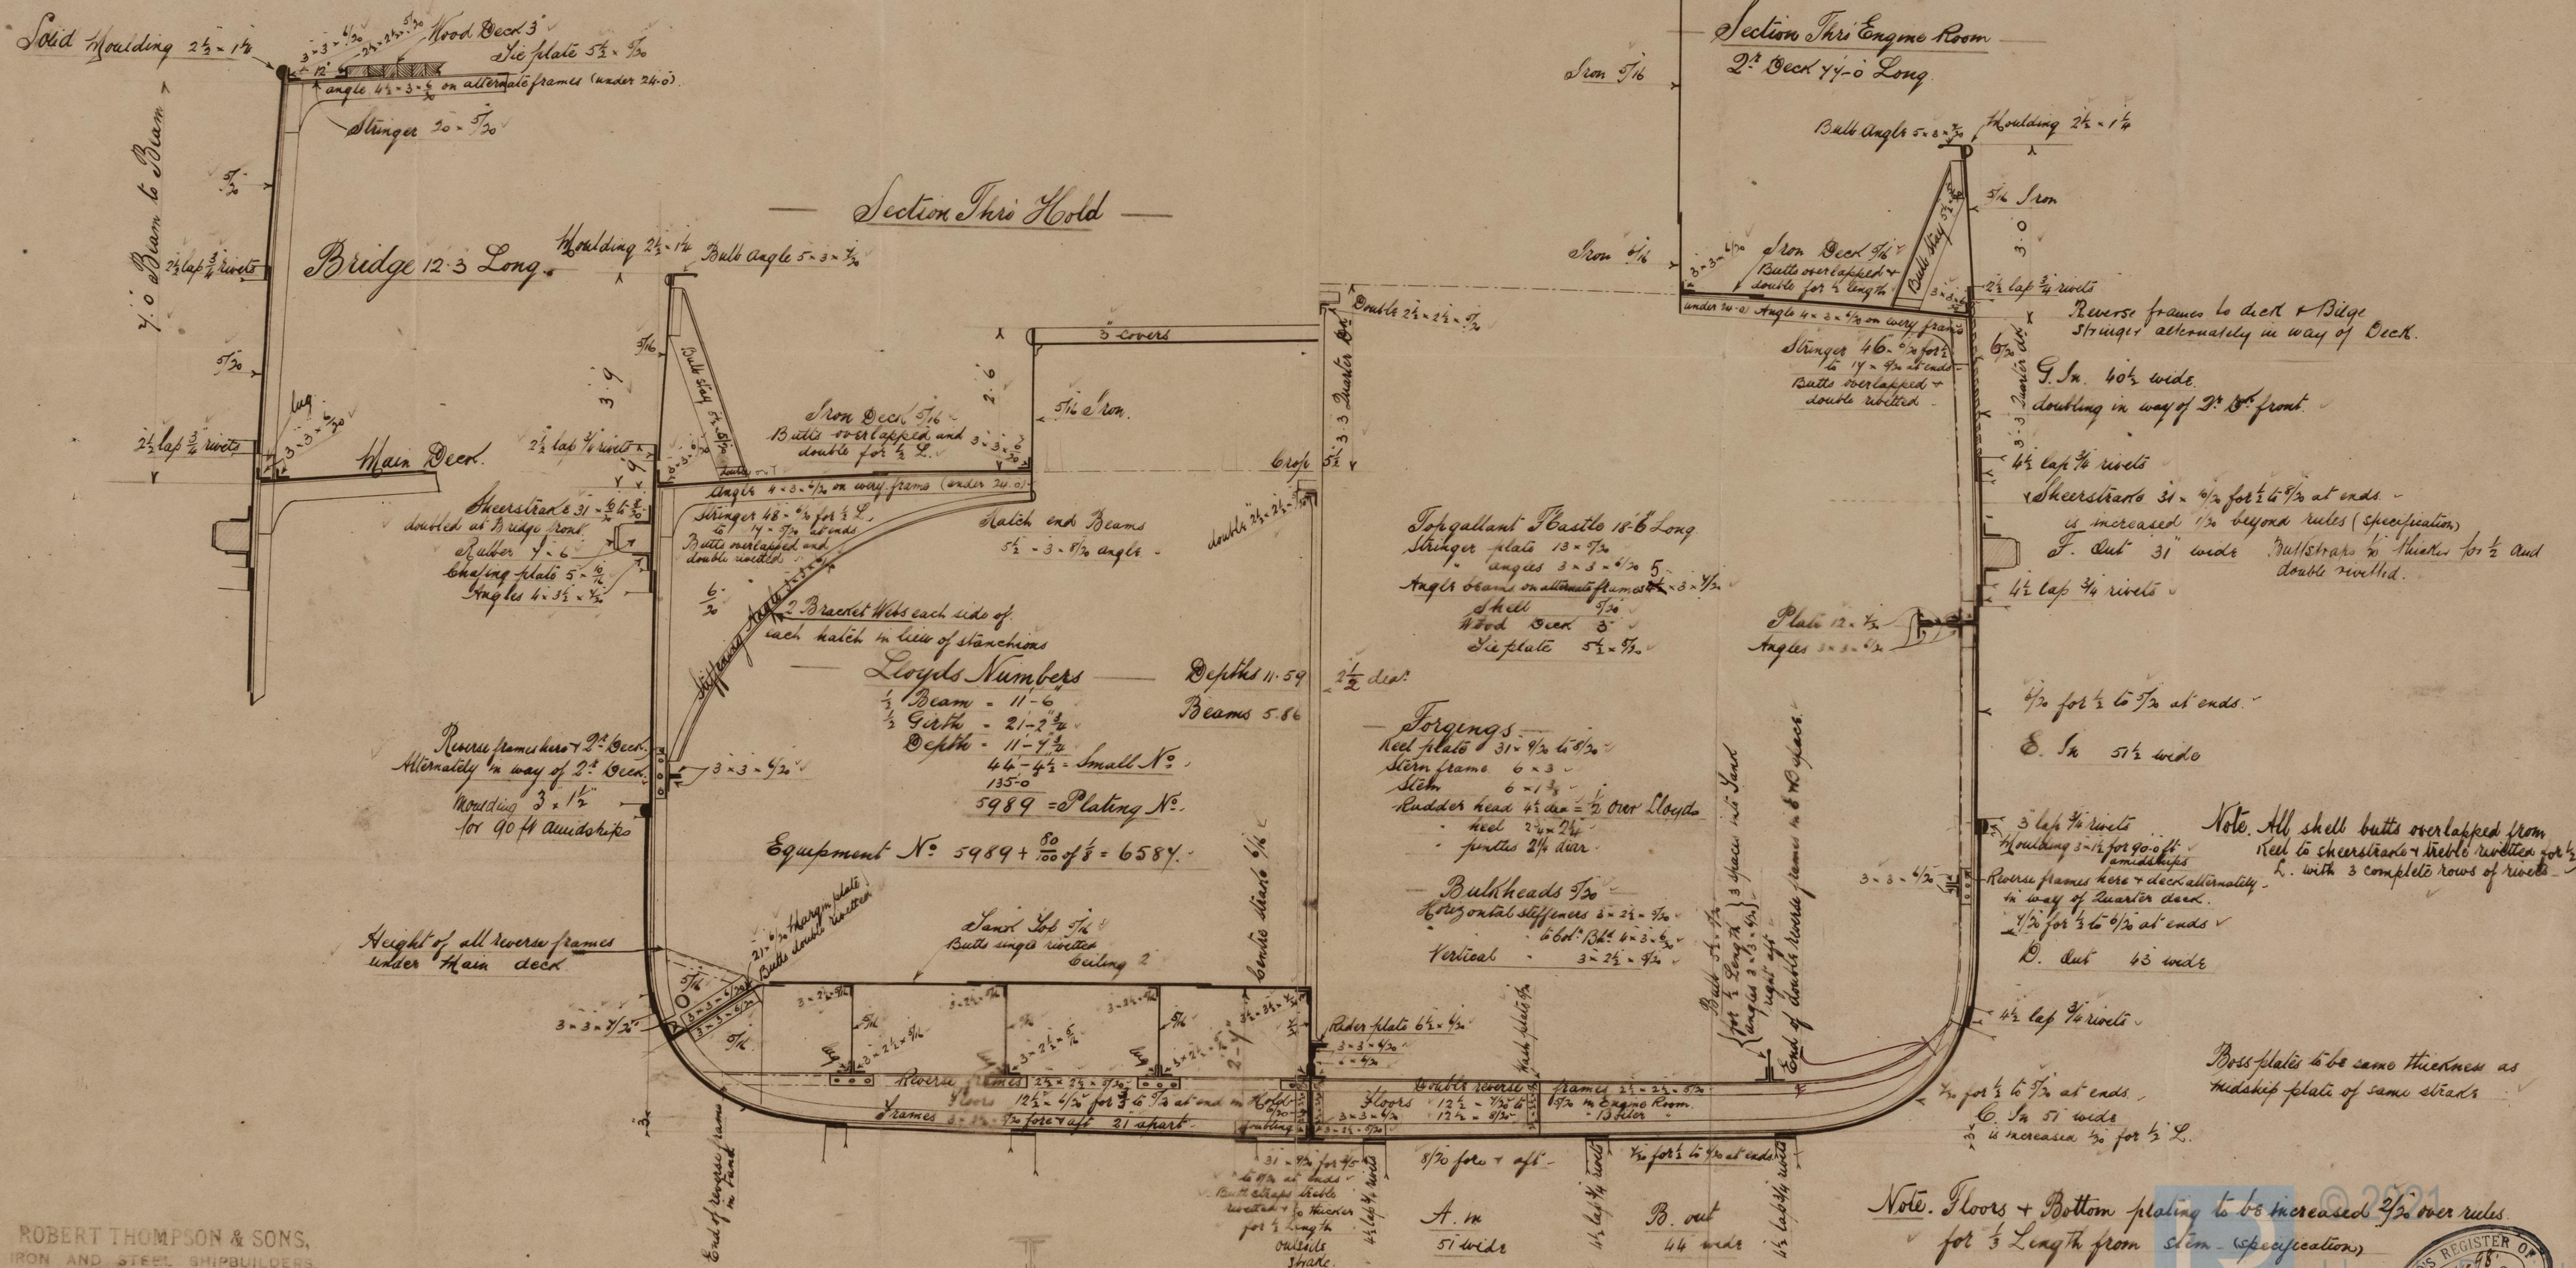


ROBERT THOMPSON & SONS,
IRON AND STEEL SHIPBUILDERS,
AND REPAIRERS,
SOUTHWICK YARD & BRIDGE DOCKYARD,
SUNDERLAND.

Note. Floors + Bottom plating to be increased $\frac{1}{2}$ over rules
for $\frac{1}{3}$ Length from stem - (specification)


SLA1016-0173

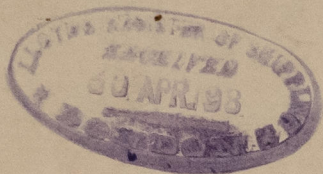

R. THOMPSON & SONS
— S. S. N° 207 —
MIDSHIP SECTION



S.S. 'Premington'

Sunderland. W. 1957.



© 2021

Lloyd's Register
Foundation