


6. 5. 98

Section showing connection
of Stinger to Bulkhead
Scale 1" = 1 foot.

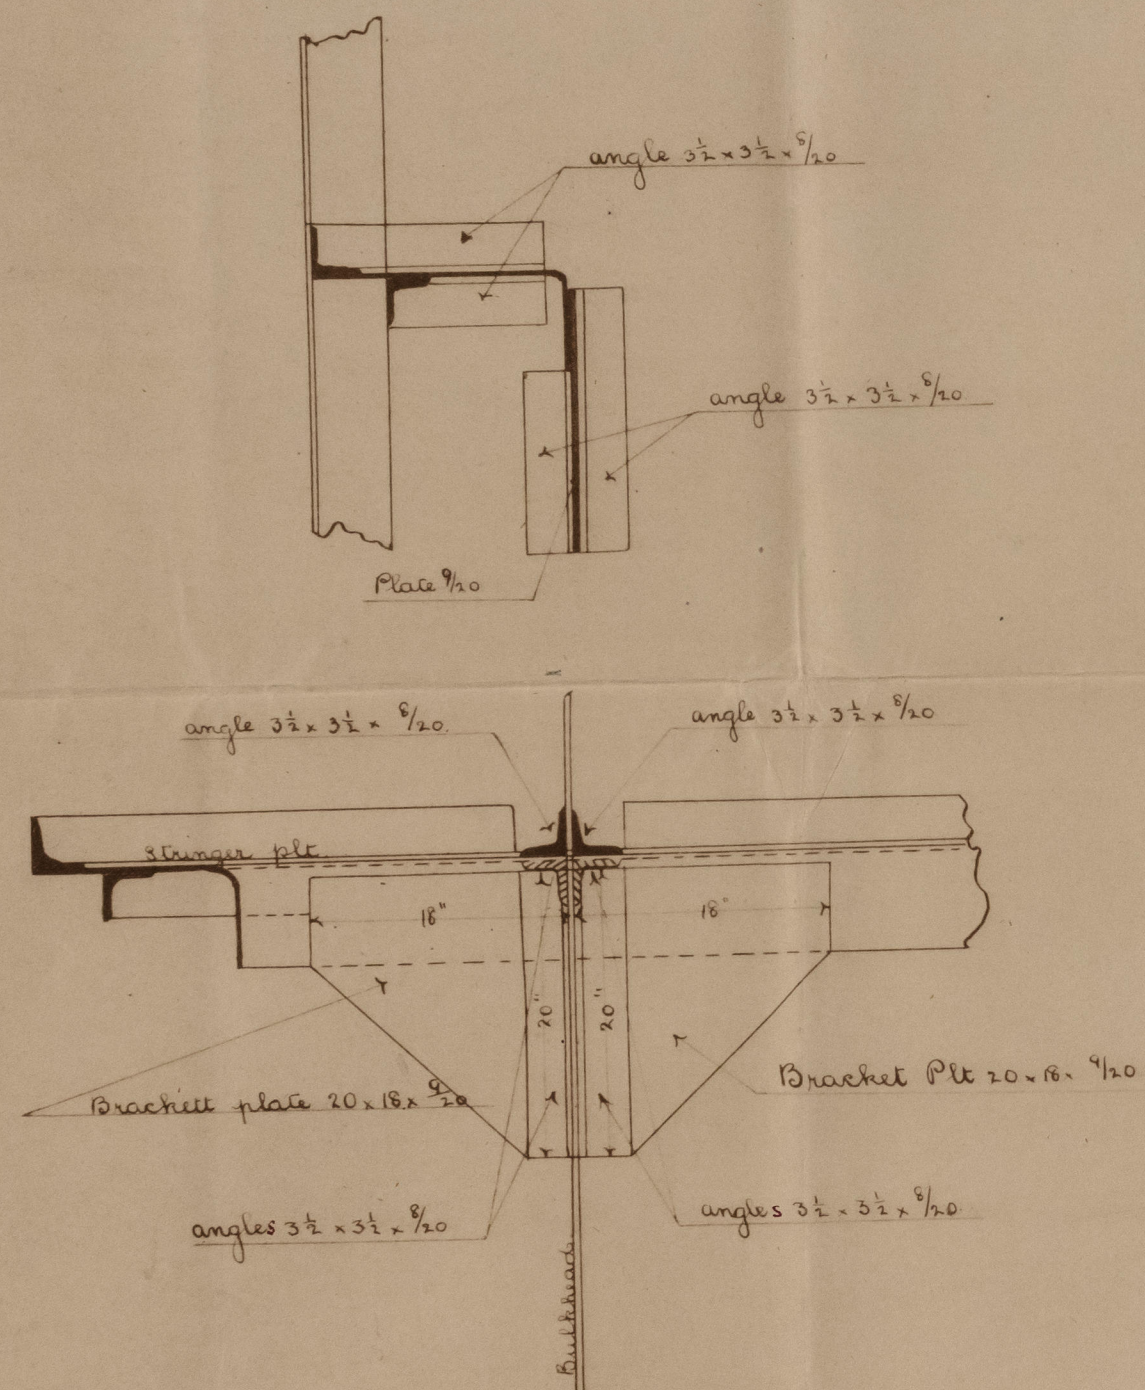


S.S. N° 557



Proposed arrang^e of Bulk^{es}


Scale 1/4" = 1 foot

Section in tween Decks

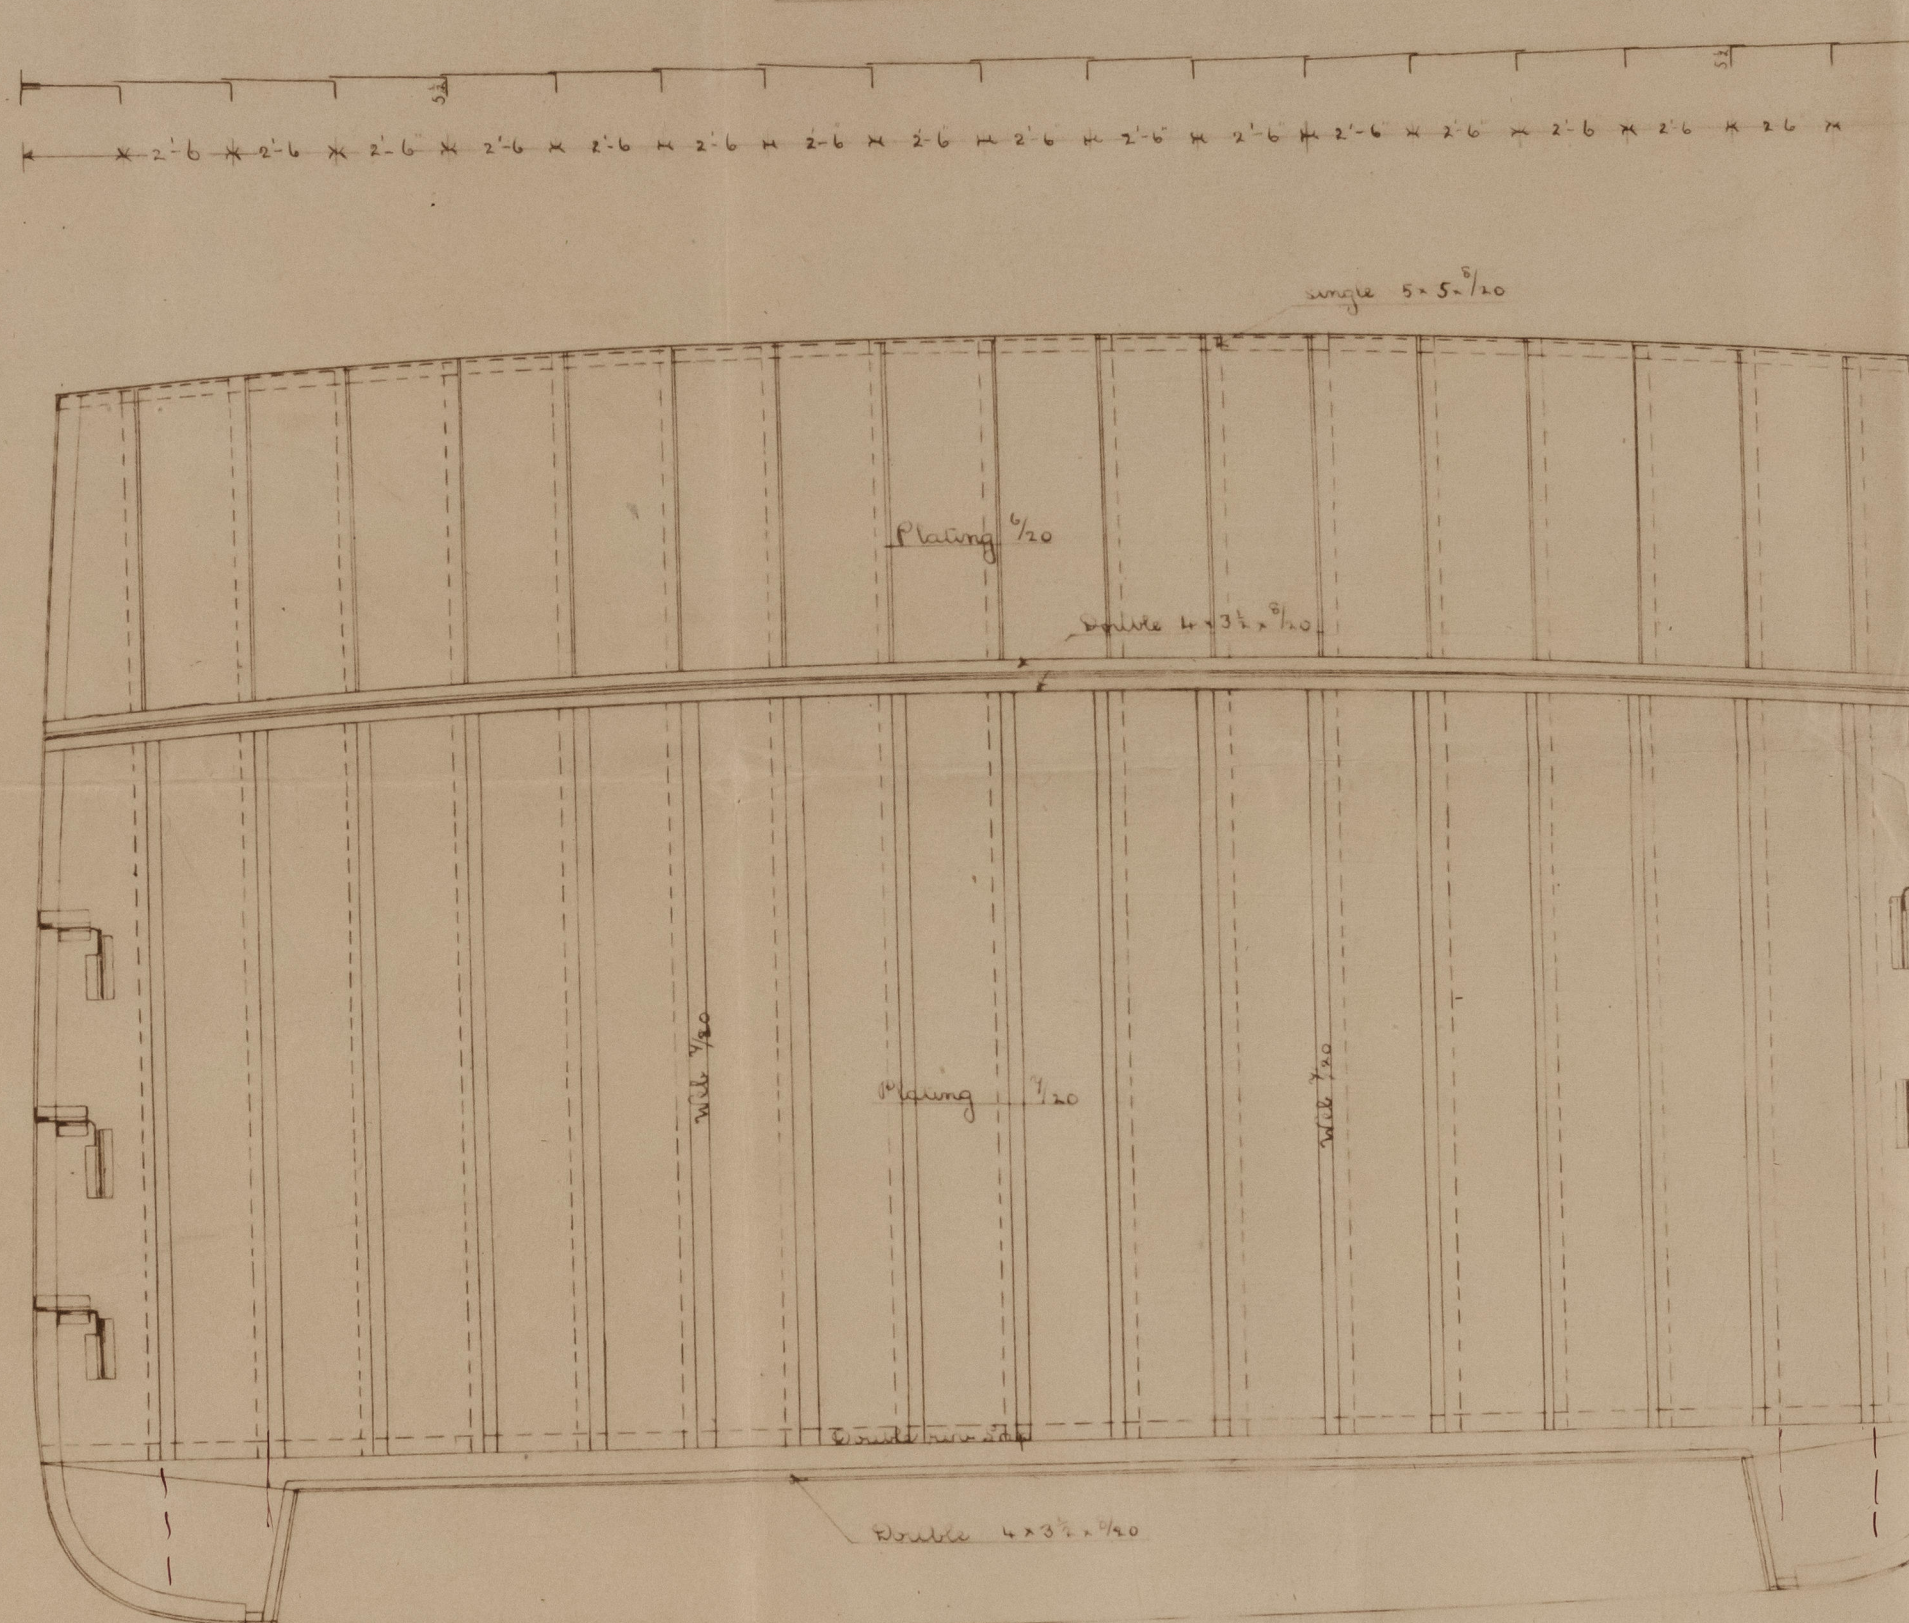

Section in Holds

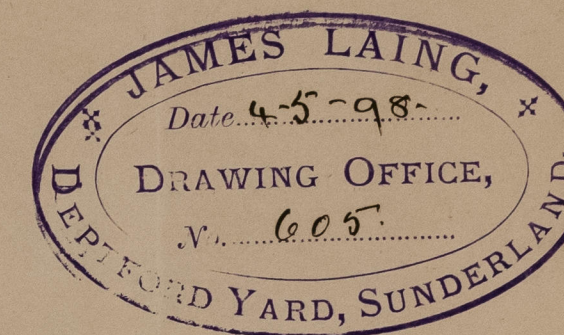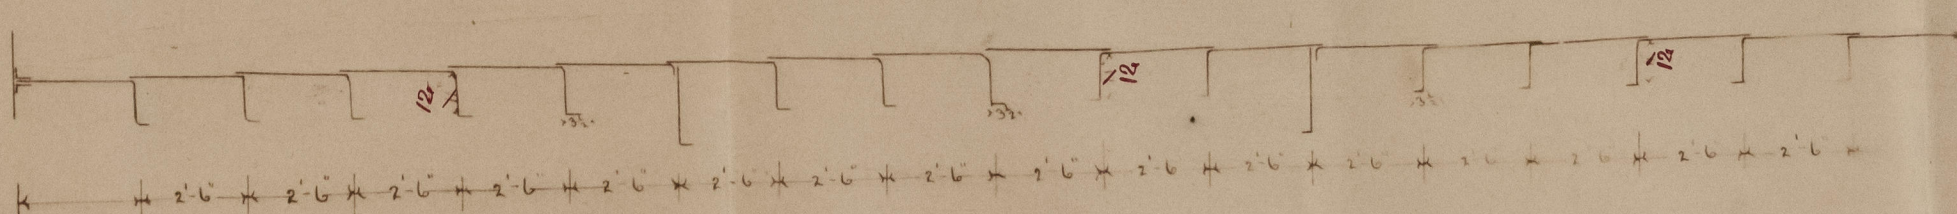


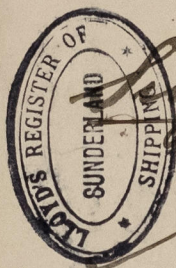

Sh. James Laing.

No. 55-7.

Bulkheads.

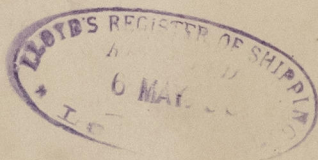

S.S. "Ville de Jamatavi"

Sunderland. No. 19575



© 2021

Lloyd's Register
Foundation

SLD1016-0181