

LOYD'S REGISTER
SHIPPING

31. 8. 96.



W. 557 29. 3. 98

S. S. N° 556.


SCALE $\frac{3}{4}$ " = 1 FT.

and W. 557 25/8/96.

appo. 29/3/98

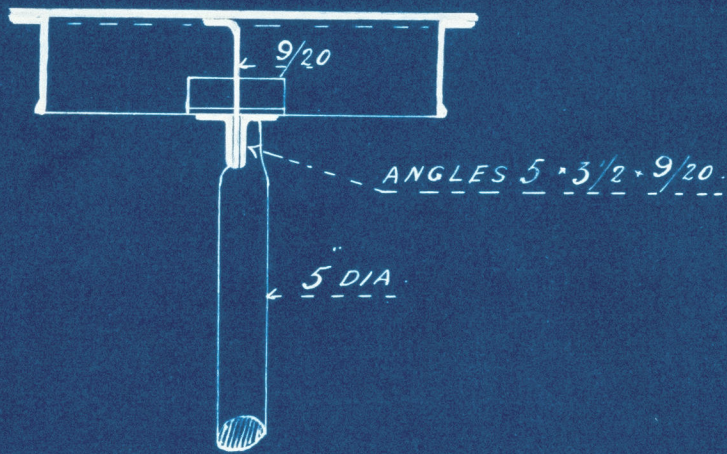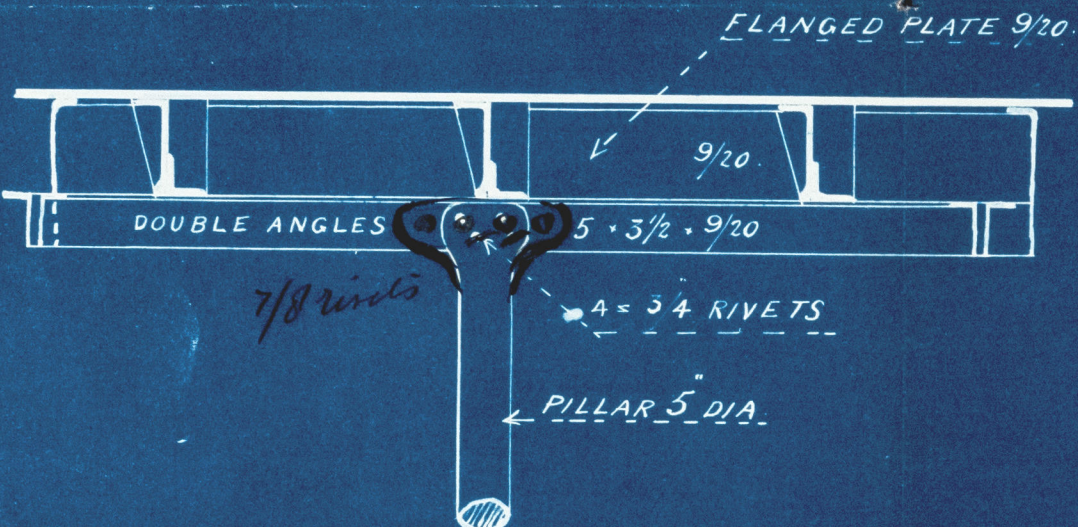

PILLARS ON EVERY 4TH FRAME.

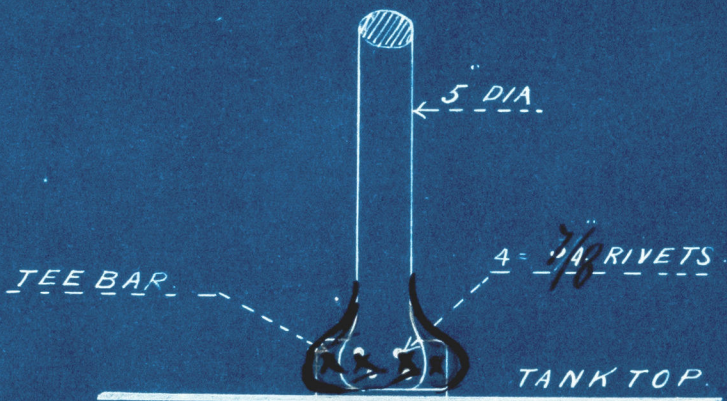

J. V. L.
31/8/96



Lloyd's Register
Foundation

James Laing
No 556
Stanchions



Also No 557

appo. 29/3/98.

S.S. "Ville de Tamatave"

Sunderland. No 19575



© 2021

Lloyd's Register
Foundation

5201016-0182