

S. S. Ville de Tamatave

Received at

Office,

189

Lloyd's Register of British and Foreign Shipping.

(Report on Vessel No. 19575 Port Sunderland.)

No. 3851A

SHIP FORGINGS OR CASTINGS.

I have to report that the undermentioned Iron or Steel Forgings or Castings, manufactured by The North Quay Forge Co. of Sunderland for the Vessel No. 554, being built by Sir James Laing of Sunderland have been inspected by me as set forth below, and found to be, so far as can be seen, sound

Mark on Forgings.

Lloyd's

No. 3851A



N.C.

W. H. Cameron

Sunderland
27/8/98

	STERN FRAME.	RUDDER FRAME.	STEM.
Material*	Scrap		Scrap
How made	Forged		Forged
Dimensions	11' x 6 1/2"		11' x 2 3/4"
Progress on Inspection	Forged & Smithed		Forged
Date when Inspected	May 4th to Aug 23/98		May 4/98

SKETCHES OF FRAMES SHOWING POSITION AND DESCRIPTION OF WELDS OF FORGINGS, OR PARTICULARS OF TESTS APPLIED TO CASTINGS.

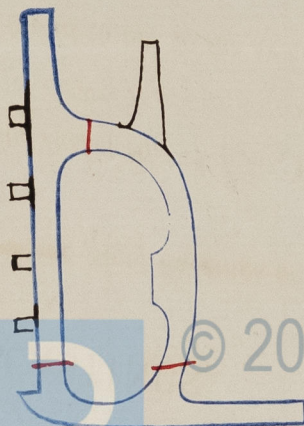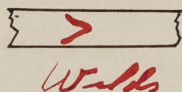

Fee (if any chargeable) £

To be paid at

* If of Iron, state whether scrap or puddled Iron.