


5-7-98.

AMENDED PROFILE OF FLOORS & KEELSONS
IN BOILER WELL

SS^s N^{os} 283 & 284

SCALE $\frac{1}{4}$ " = ONE FT

ENGINE & BOILER SPACE

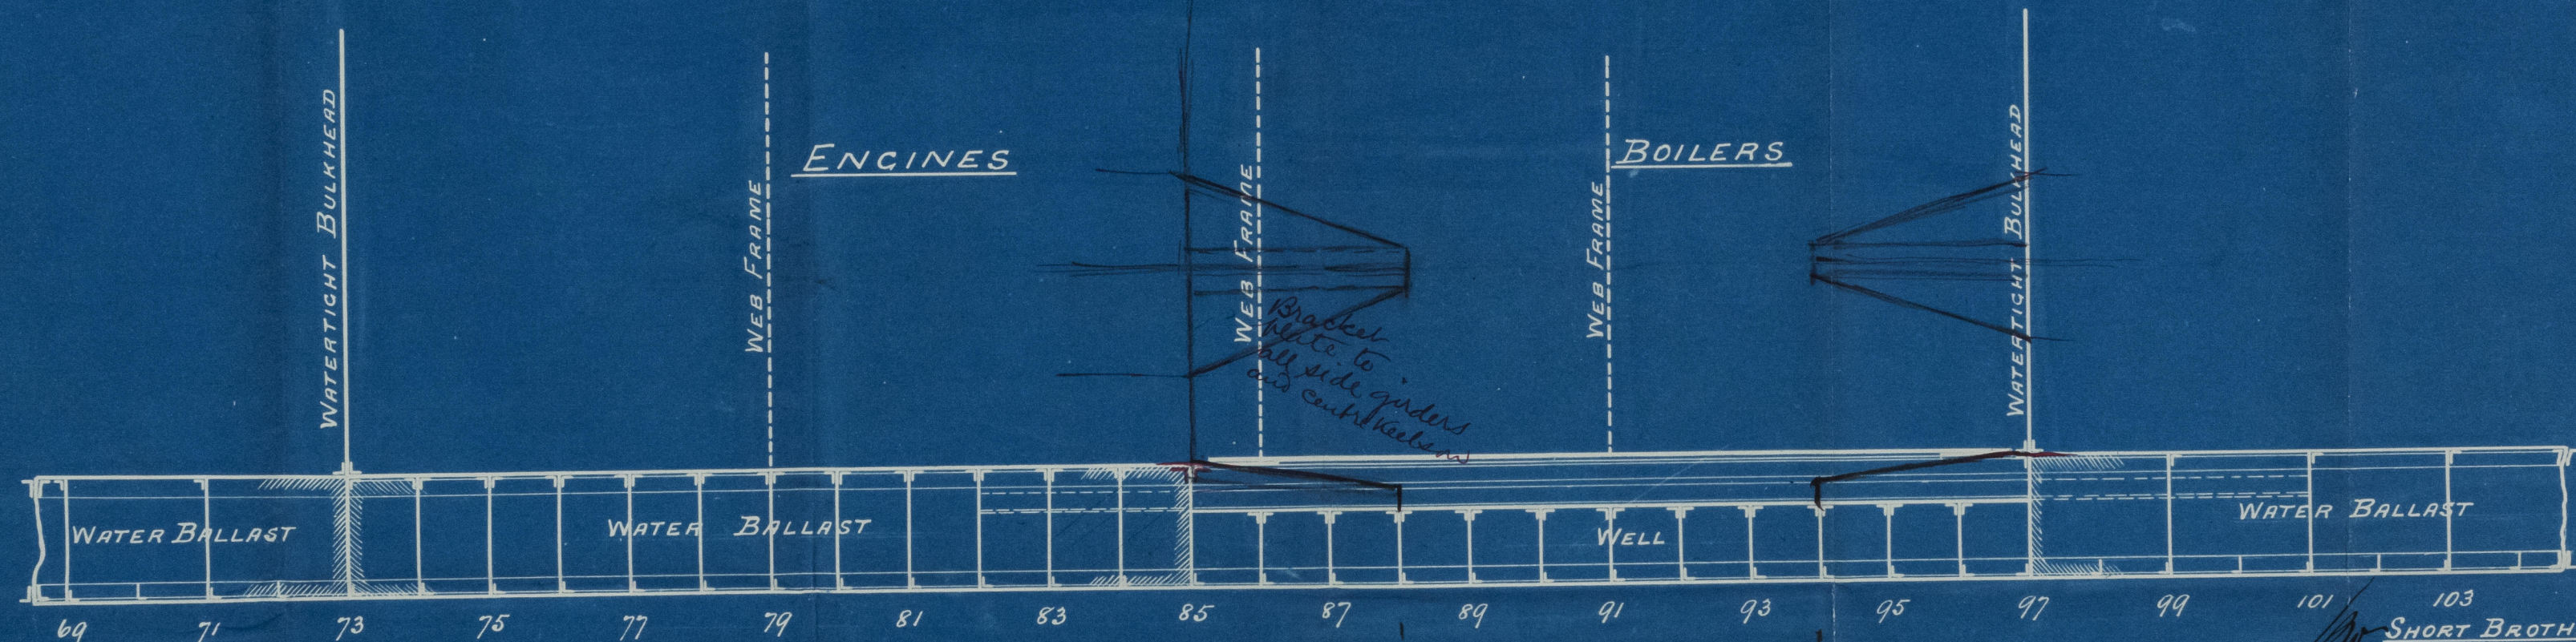

PLAN N^o

SHORT BROTHERS
SHIPBUILDERS
SUNDERLAND

Admiral 17/6/98

*J.H.L.
4/7/98*

SLD1018-0006


Messrs Short Bros.

S. S. Nos 283 & 284

Profile showing
also No. 287
ordinary floors in
Boiler Space.

9900-8101A75

S. S. "Anglo-Australian"

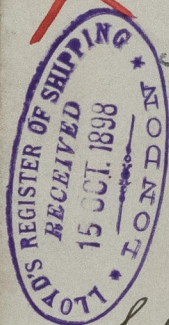

Sunderland. No. 19685

S. S. "South Australia"

Sunderland. No. 19829.

S. S. "Winchester"

Sunderland. No. 20032