

Lloyd's Register of British and Foreign Shipping.

(Report on Vessel No. 19685 Port Sunderland.)Sund
No. 3858a.

SHIP FORGINGS OR CASTINGS.

I have to report that the undermentioned Iron or Steel Forgings or Castings,
 manufactured by Mr J Ray
 of Pallion for the Vessel No. 283, being built
 by Wm & John Brothers of Sunderland
 have been inspected by me as set forth below, and found to be, so far as can be seen,
Sound.



Mark on Forgings.

Lloyd's

No. 3858a.No. 6.Wm & JohnSunderland
18/5/99

	STERN FRAME.	RUDDER FRAME.	STEM.
Material*	<u>Scrap</u>		<u>Scrap</u>
How made	<u>Forged</u>		<u>Forged</u>
Dimensions	<u>11" x 6 3/4"</u>		<u>11" x 2 7/8"</u>
Progress on Inspection	<u>Forged & Smoothed</u>		<u>Forged</u>
Date when Inspected	<u>Oct 1st to Dec 17/98</u>		<u>Nov 5/98</u>

SKETCHES OF FRAMES SHOWING POSITION AND DESCRIPTION OF WELDS OF FORGINGS, OR PARTICULARS OF
 TESTS APPLIED TO CASTINGS.

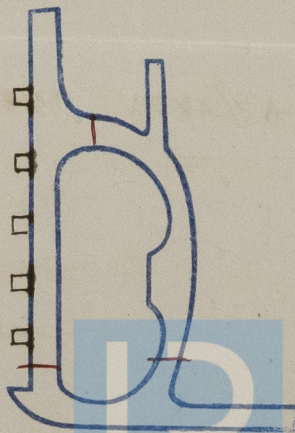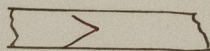

Fee (if any chargeable) £

To be paid at