


— SKETCH SHEWING PROPOSED LENGTHENING OF HATCHES —  
*S/S "NORMAN" ~~was~~ S.S. ALBERT DUMOIS —*  
 SCALE  $\frac{1}{8}$ " = ONE FOOT





*Profile of S/s "Allport-Dumois"*  
*showing alteration in hatch.*

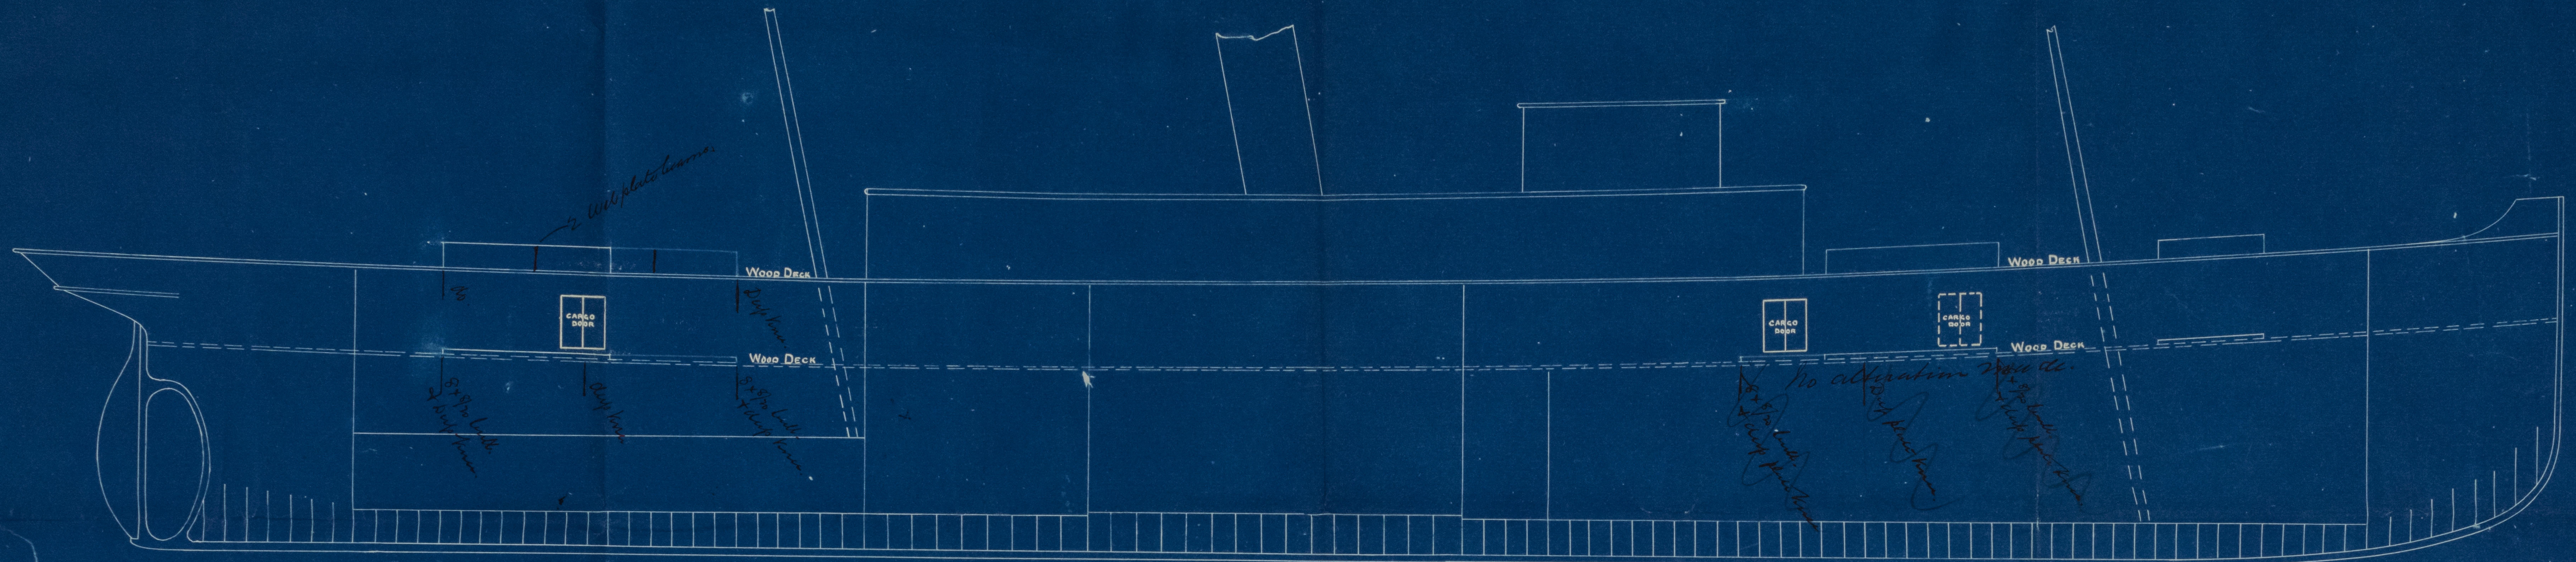

© 2021

Lloyd's Register  
Foundation

0720-810175