

BRIDGE DECK.

NOTE: - NO KNEES TO BRIDGE OR BEAMS WHERE PARTIAL BULKHEADS ARE FITTED

not do

6220-810175

© 2021
Lloyd's Register
Foundation

NOTE:- ALL PLATES TO BE PUNCHED FOR WOODWORK WHERE REQUIRED.

Pillars to every beam at middle line, and at quarter breadth to alternate beams. and under house to Surveyors satisfaction

To be kept Vertically Glass.

through beam

$10-1 - 0 \frac{3}{x} + 20$
 $\frac{1307}{140}$
 CLEAR FOR SHIPMENT OF BOILERS
 10-9
 Turned here

Cont
Sheet


P. 11

3 + 9/20 BULB

8

16. © 2023

6220-810175

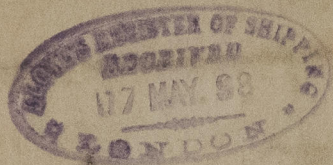

Sunderland S. B. Co.

No 199

Bridge Dock plan

Wilcannia

Supplement of No 196

© 2021
SLD 19156

Lloyd's Register
Foundation
SLD1018-0229