

No.



Enclose to Messrs
Lloyd's Surveyors


Date, Feb 1/99

SLD 1018-0230 2 1/2

ELEVATION & SECTIONS. N^o 199 ^S/₅

SCALE $\frac{1}{2}$ " = 1 FOOT.

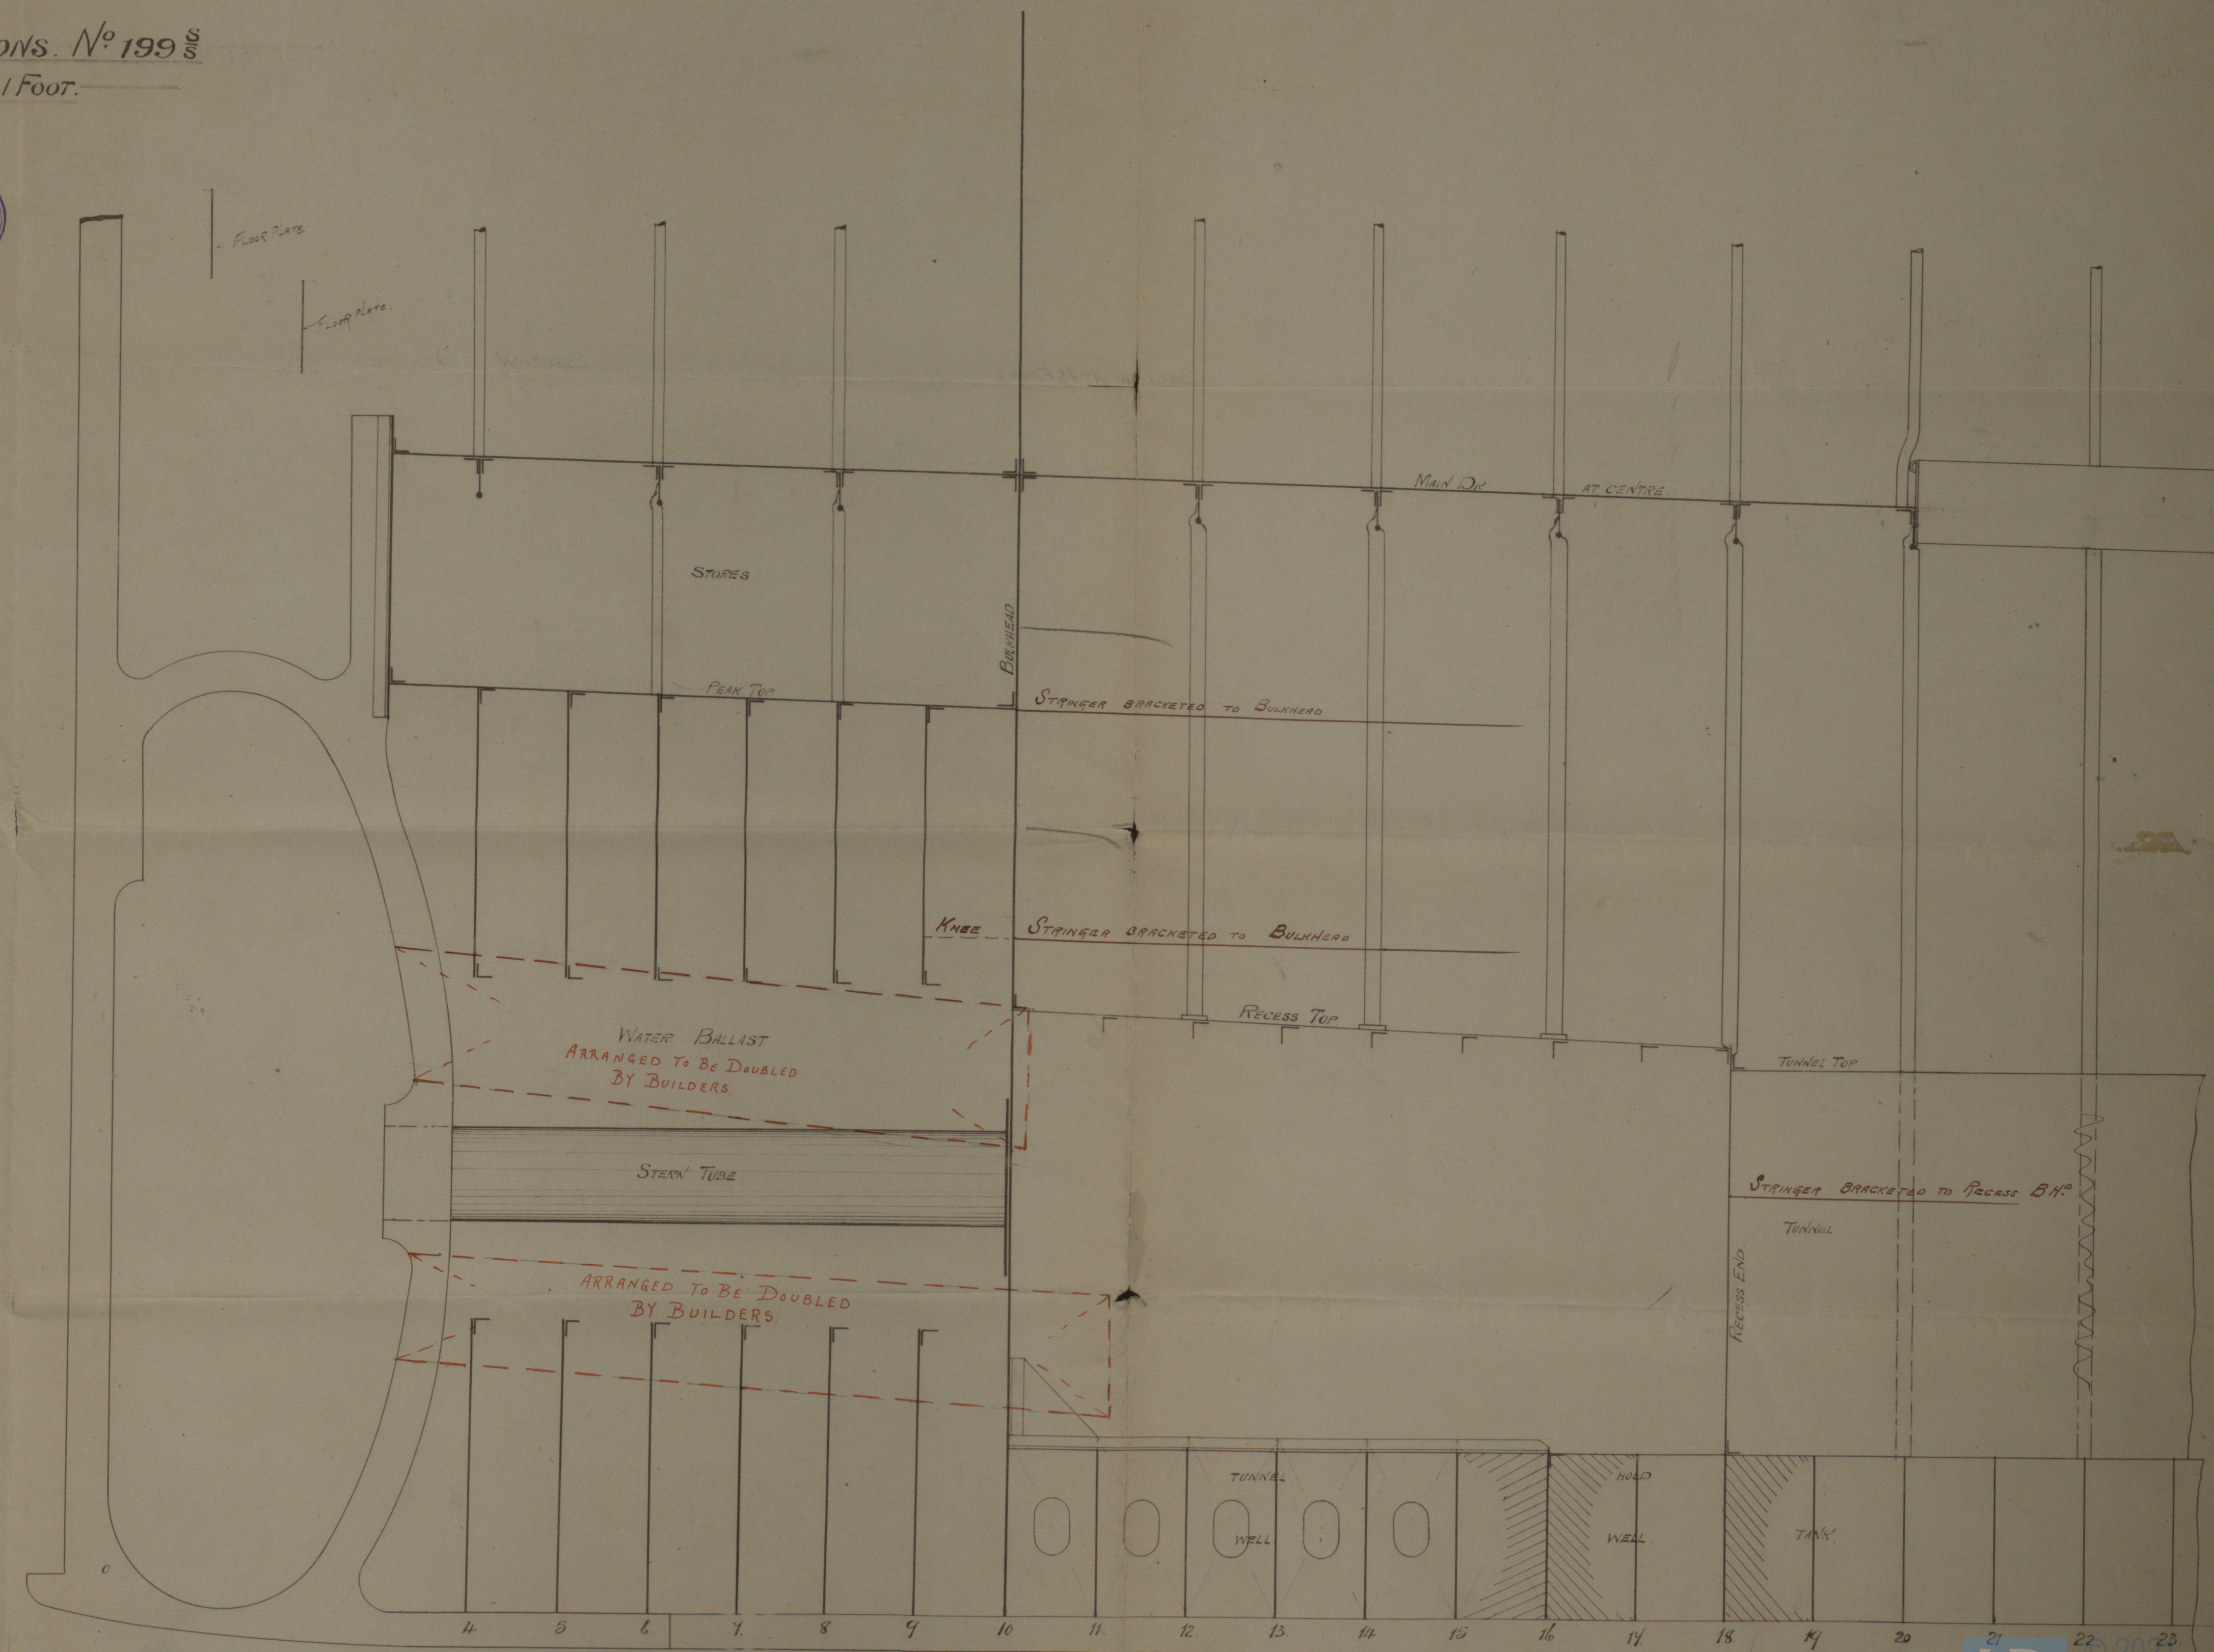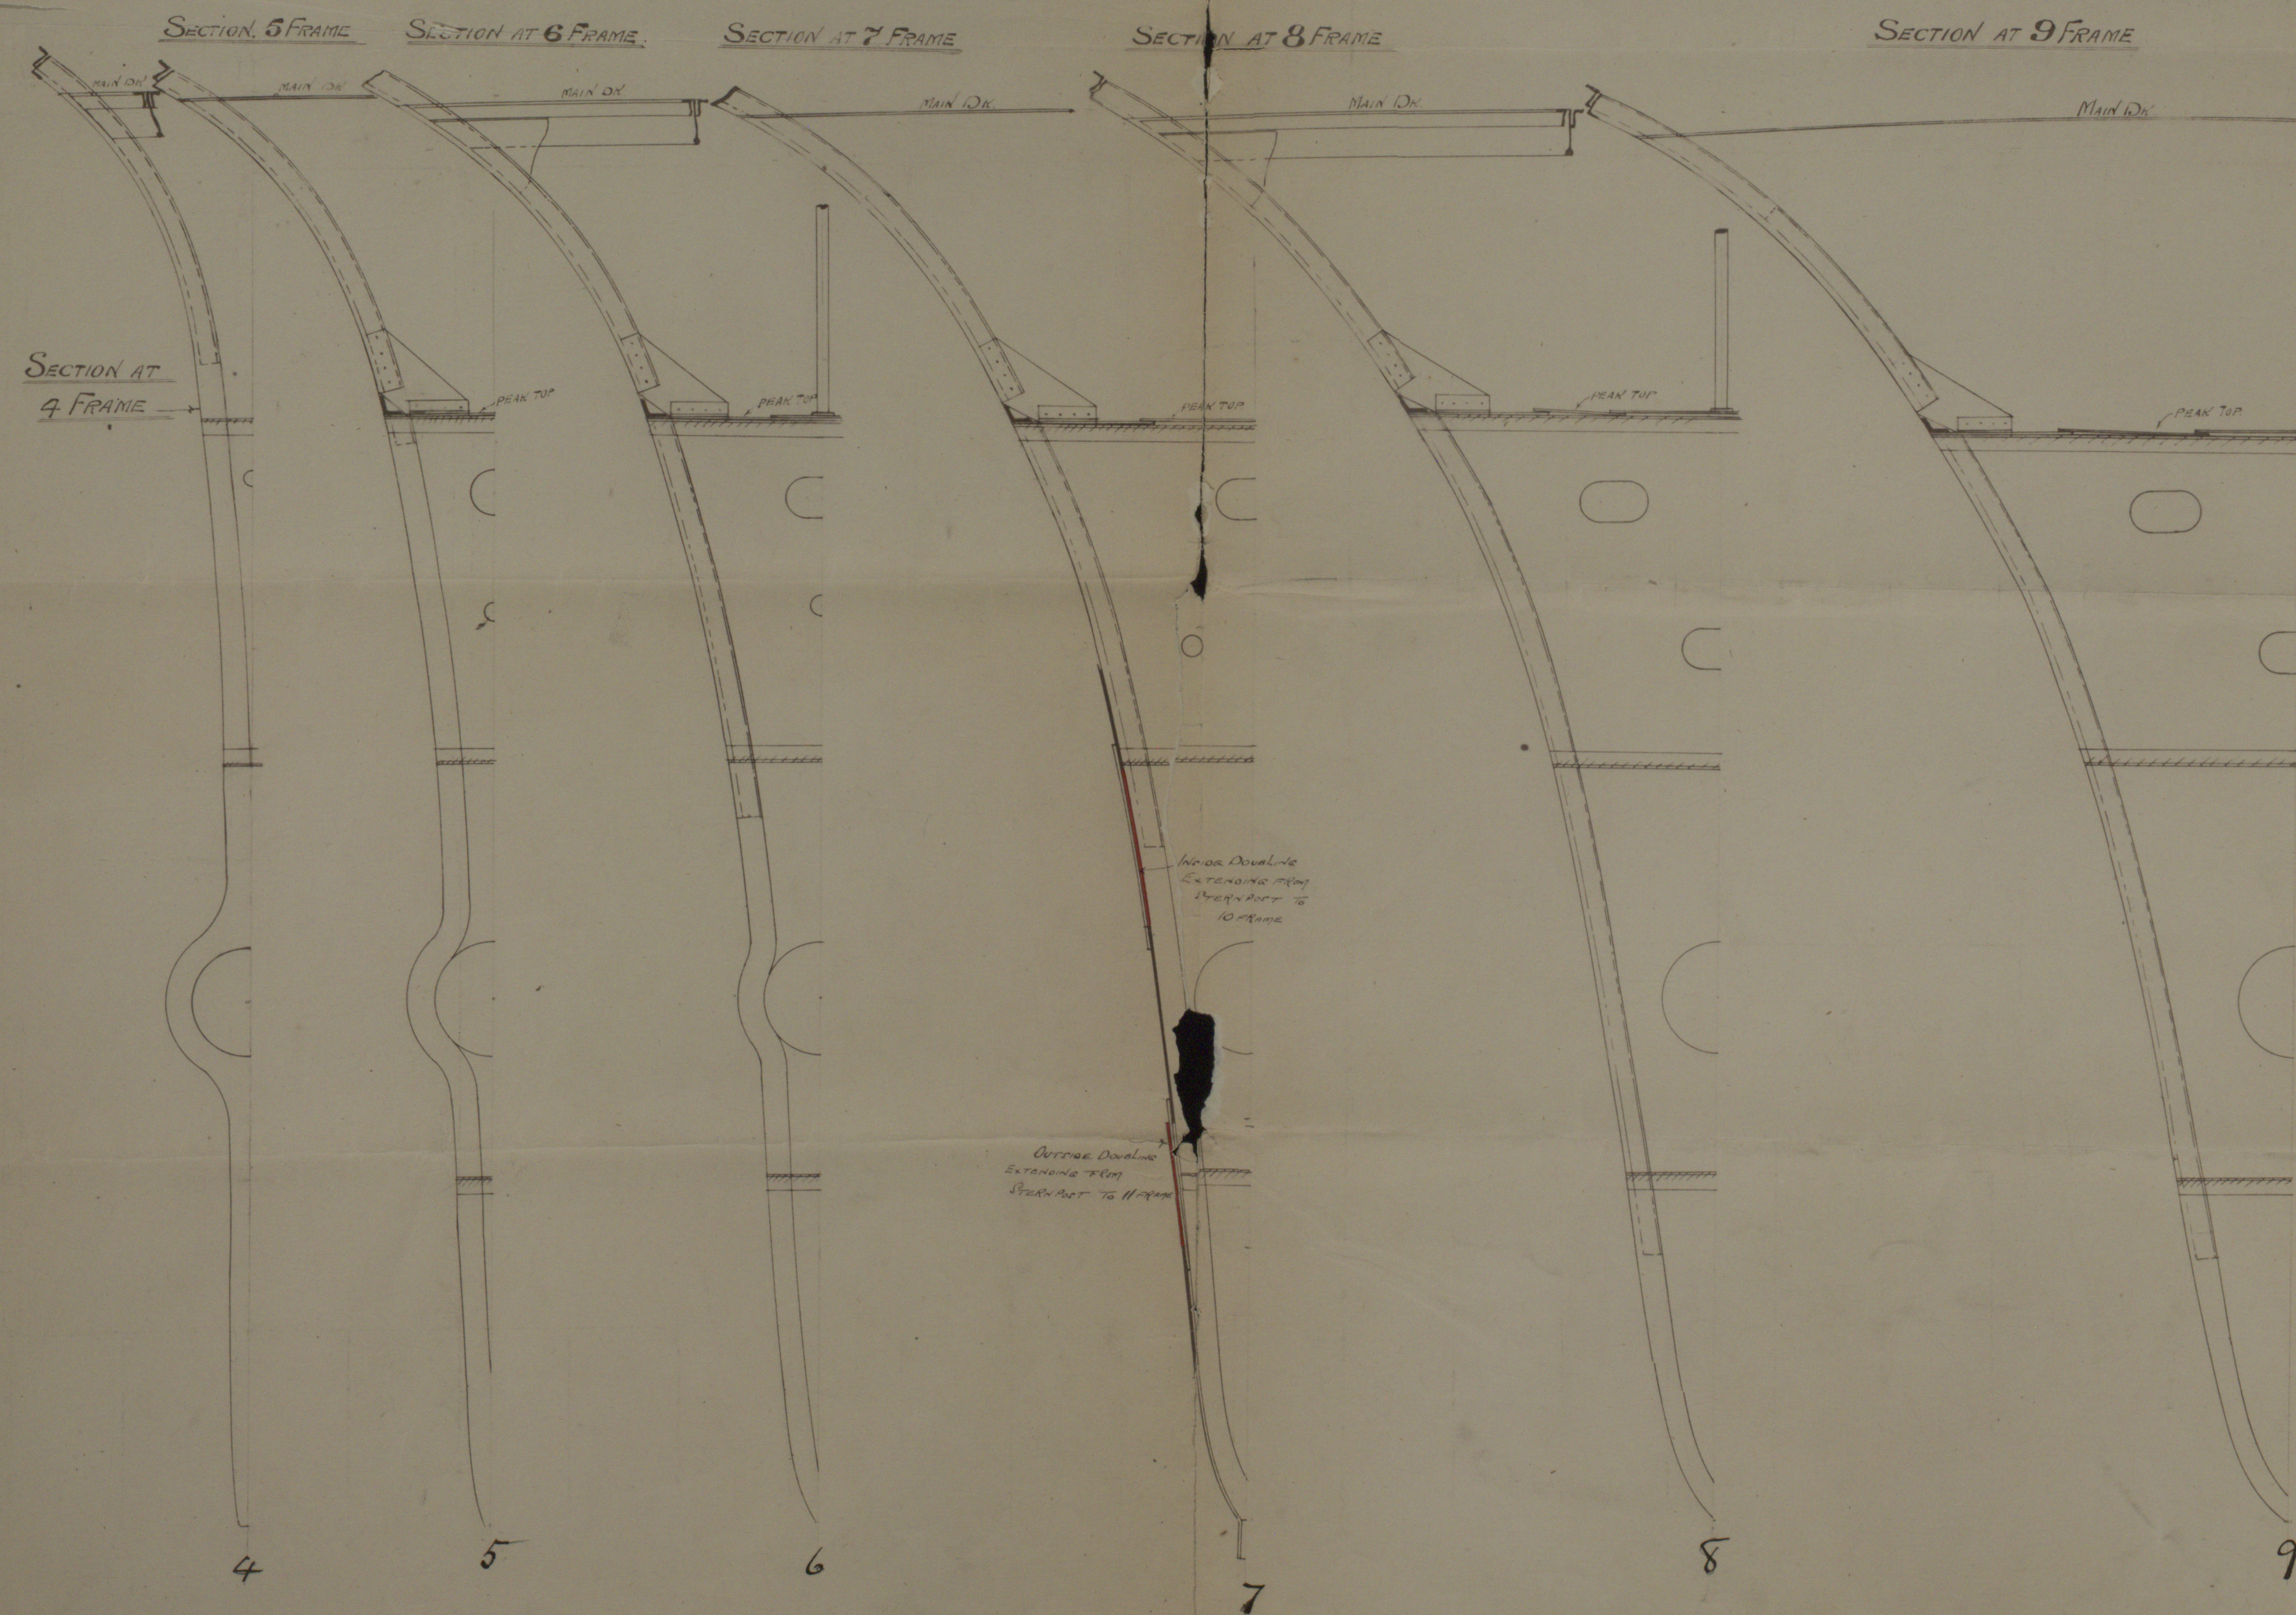

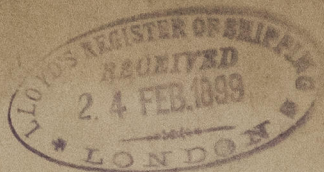

S.S. Wilcamia
Slid S.R.C. No 199

From London to
"Wakool" & "Warrung"

Trailing etc in After peak.

To be placed with
1st Entry -



SLD1018 - 0230 1/2



© 2021

Lloyd's Register
Foundation