
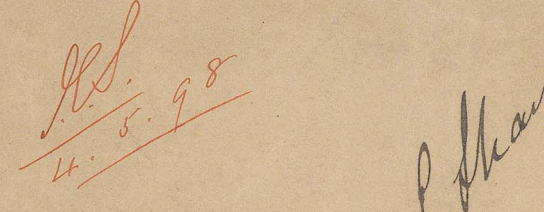


BALLAST PIPE ARRANGEMENT.
N^o 196 §
 SCALE $\frac{1}{4}$ " = 1 FOOT.

NOTE:- { ROTARY PUMP FITTED IN ENGINE ROOM. *left not to exceed 24 feet.*
NO SLUICE VALVES.
UNDER DK. TONNAGE 4202.

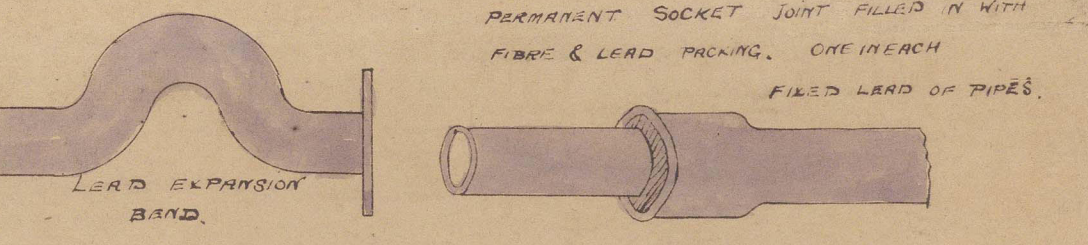



William L. Harris

© 2014

Lloyd's Register Foundation

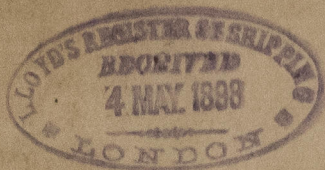

Sunderland S.B.C.
No 196

Pumping plan

Lloyds Pipe Plan
No 196

received May 4th 88

% Watkool. H.L. 19431

—S.S. "Wilcannia"—

Sunderland No 19756



© 2021

Lloyd's Register
SLD1018-0238
Foundation