



SECTION AT 14 FRAME

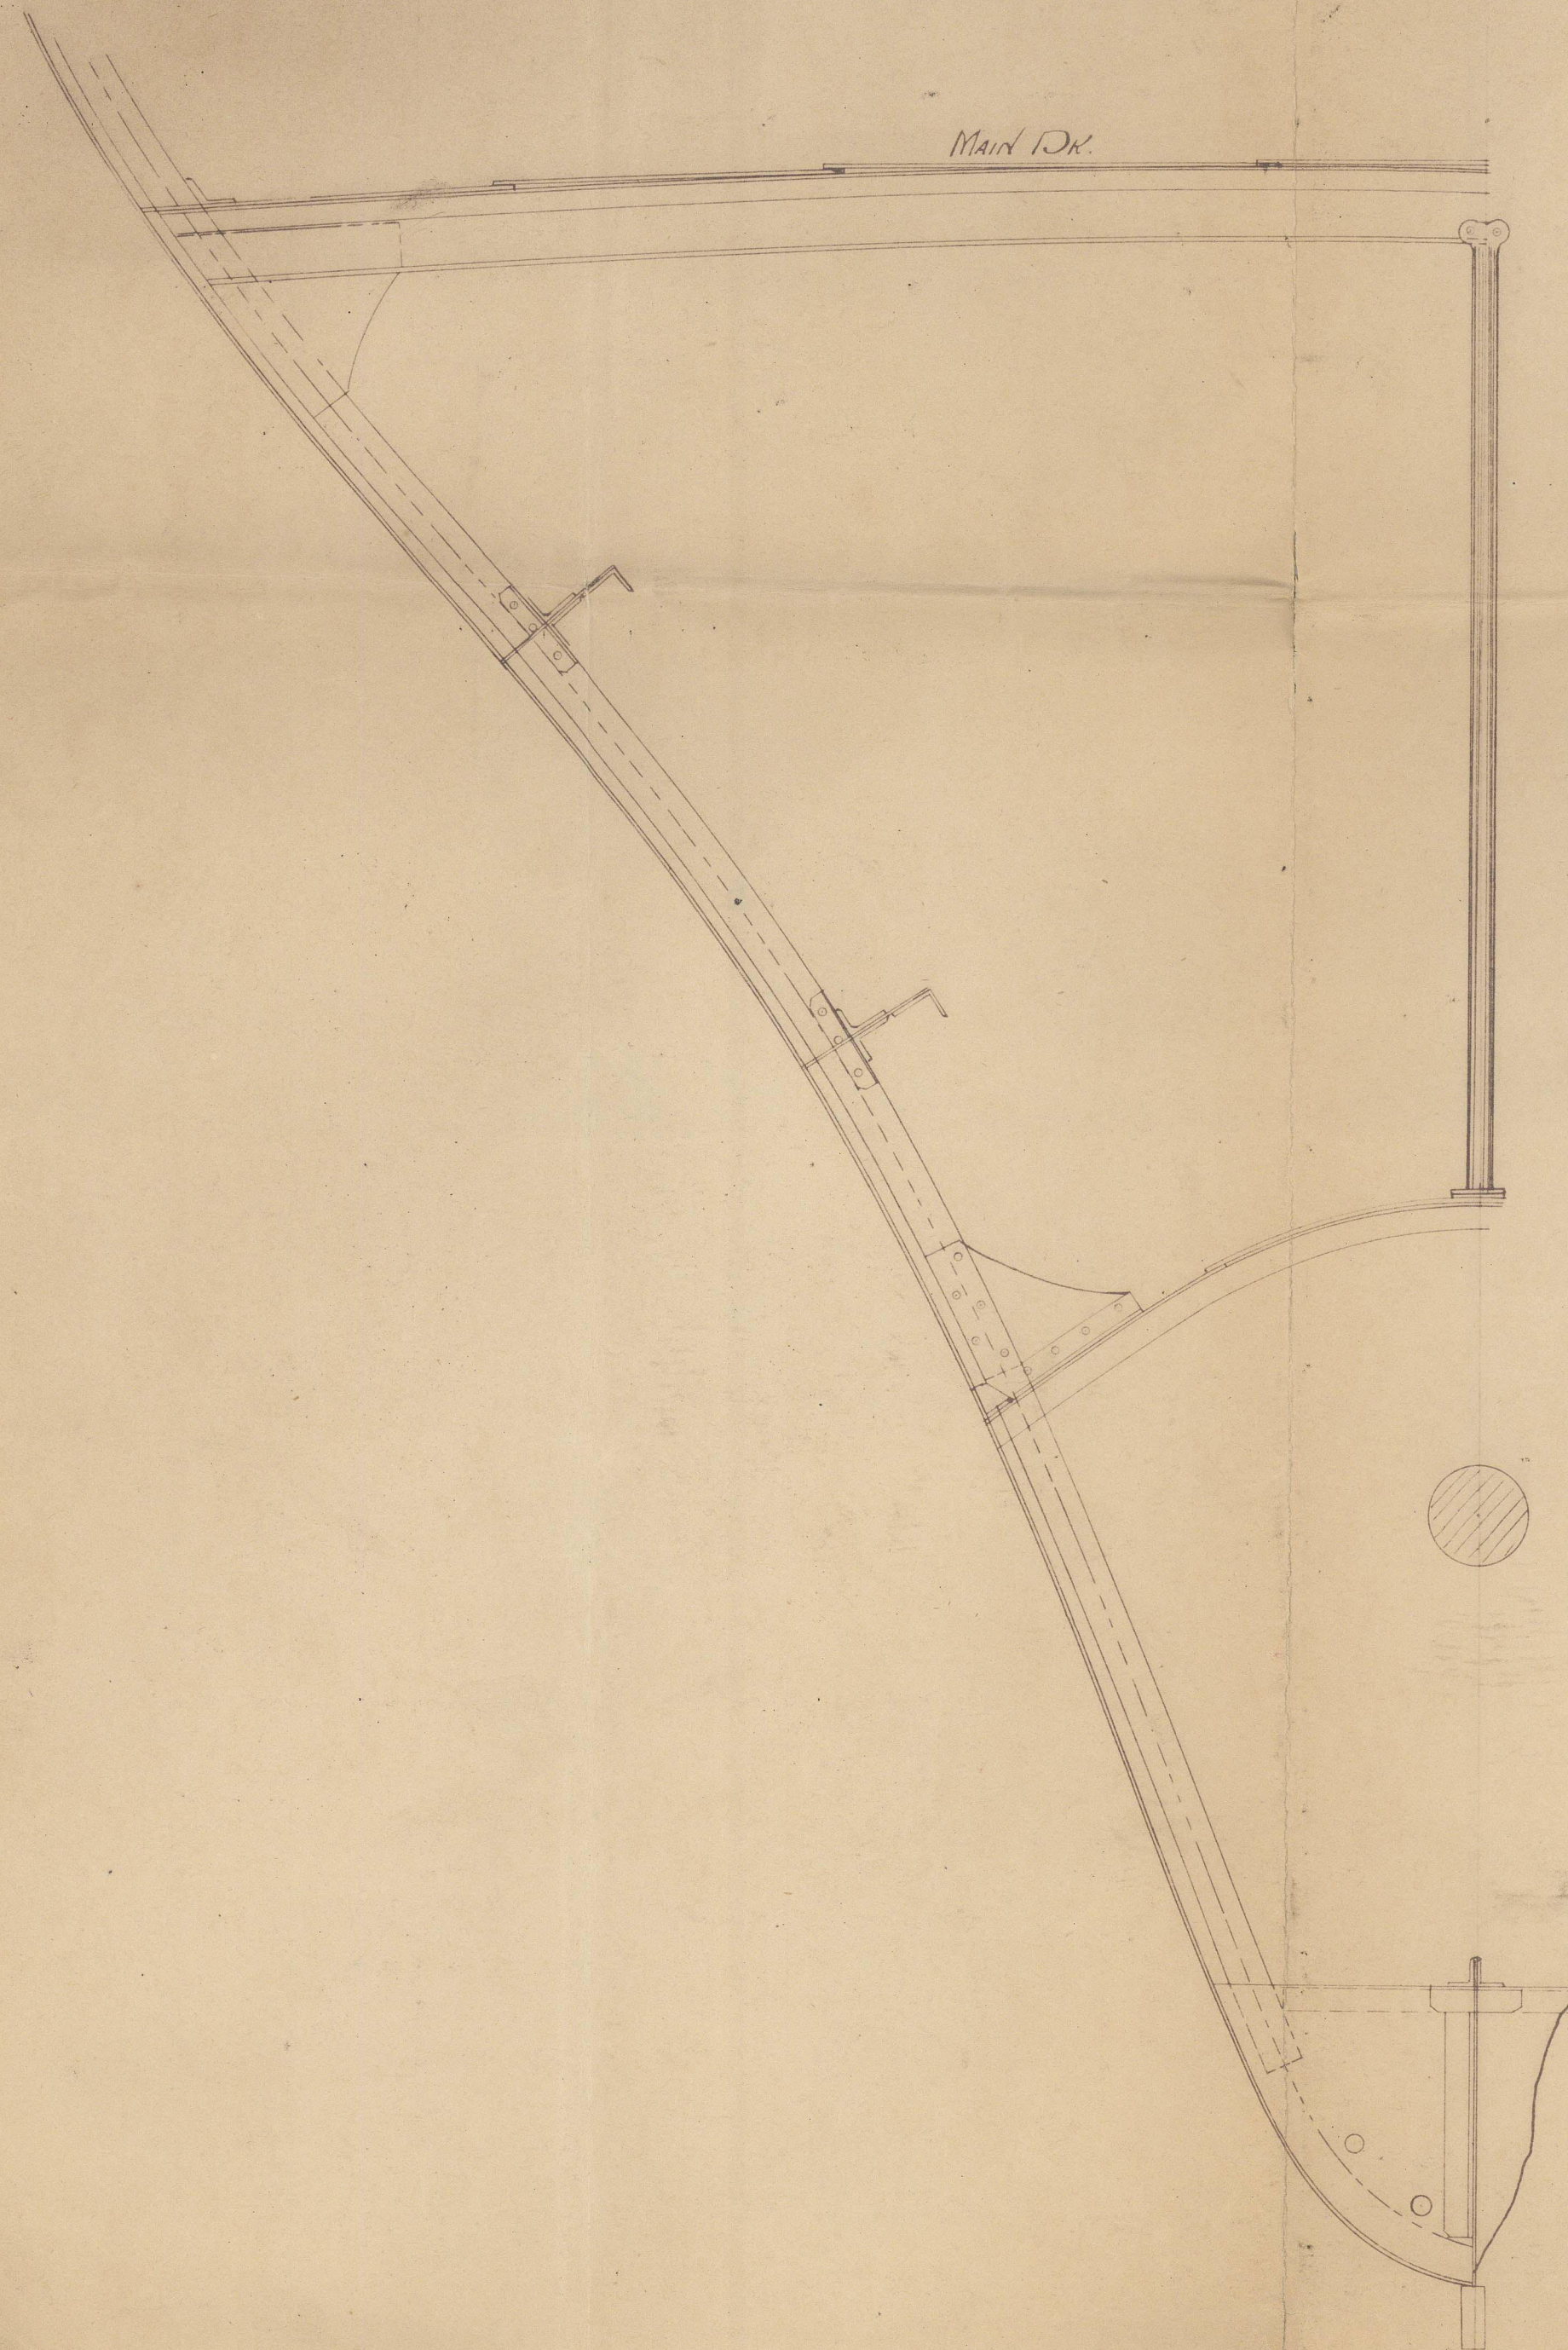

SECTION AT 18 FRAME LOOKING AFT

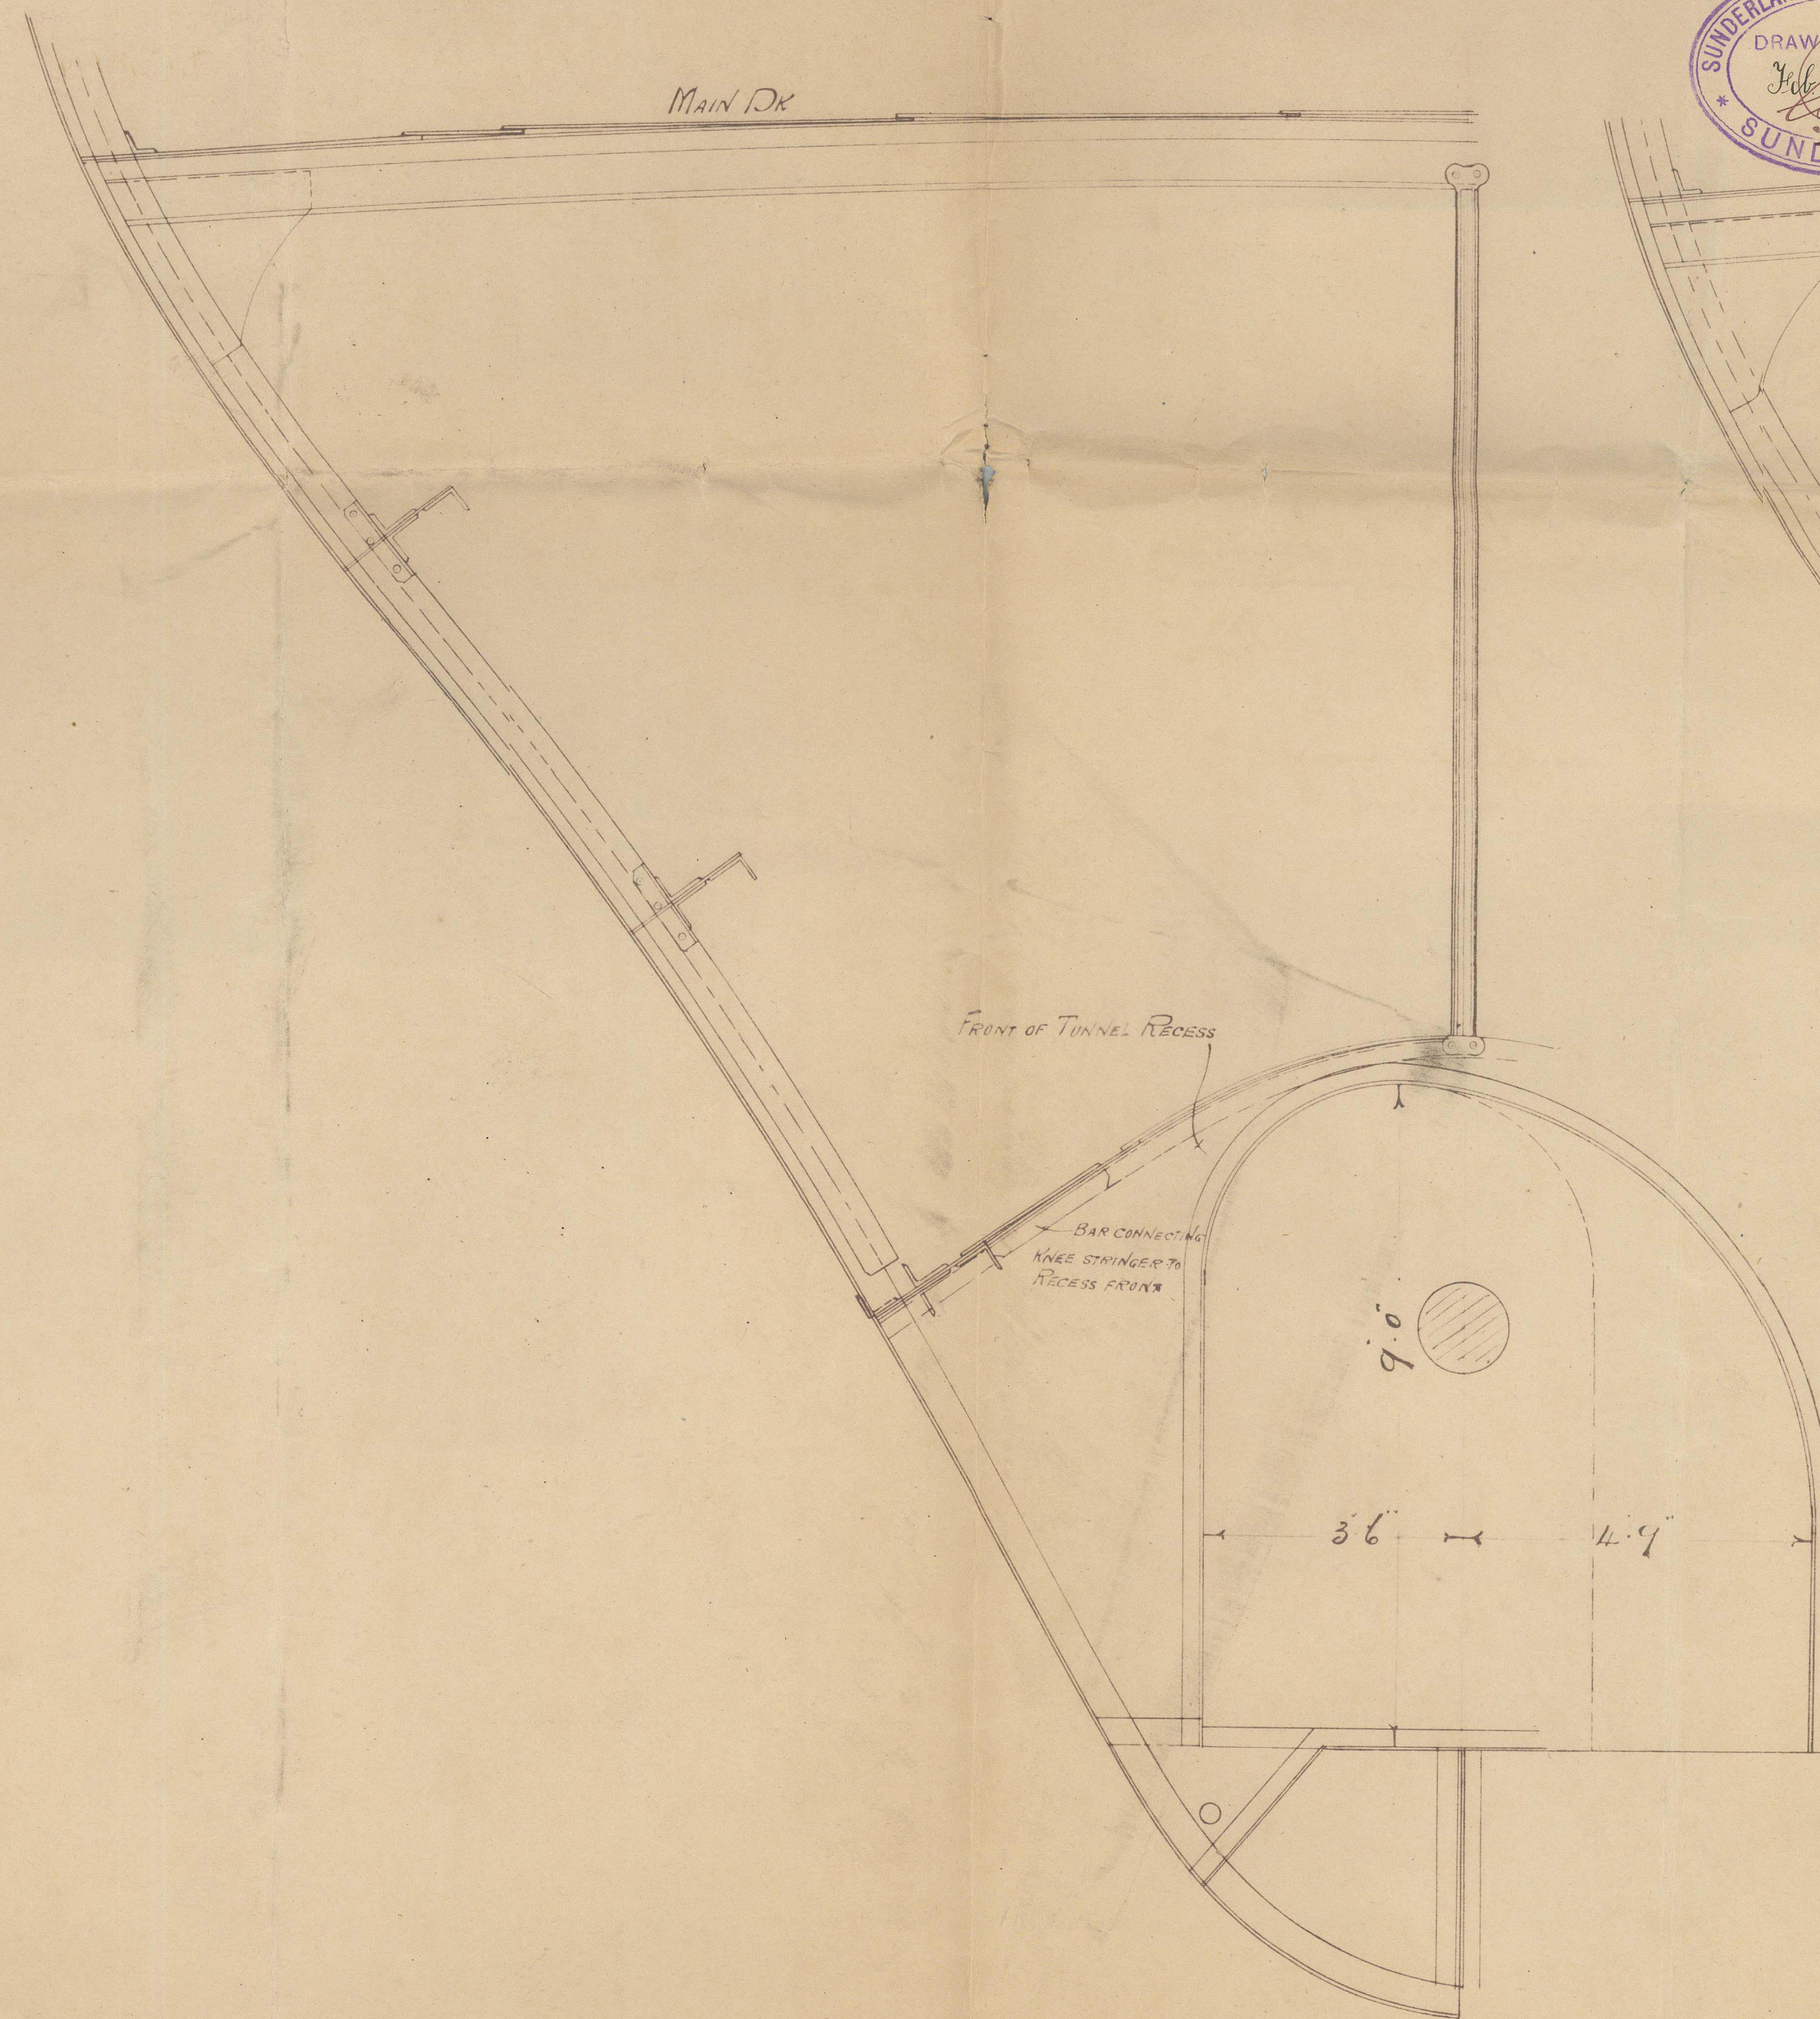


N^o 199 ^S/_S

SCALE $\frac{1}{2}$ " = 1 FOOT.



SECTION AT 22 FRAME

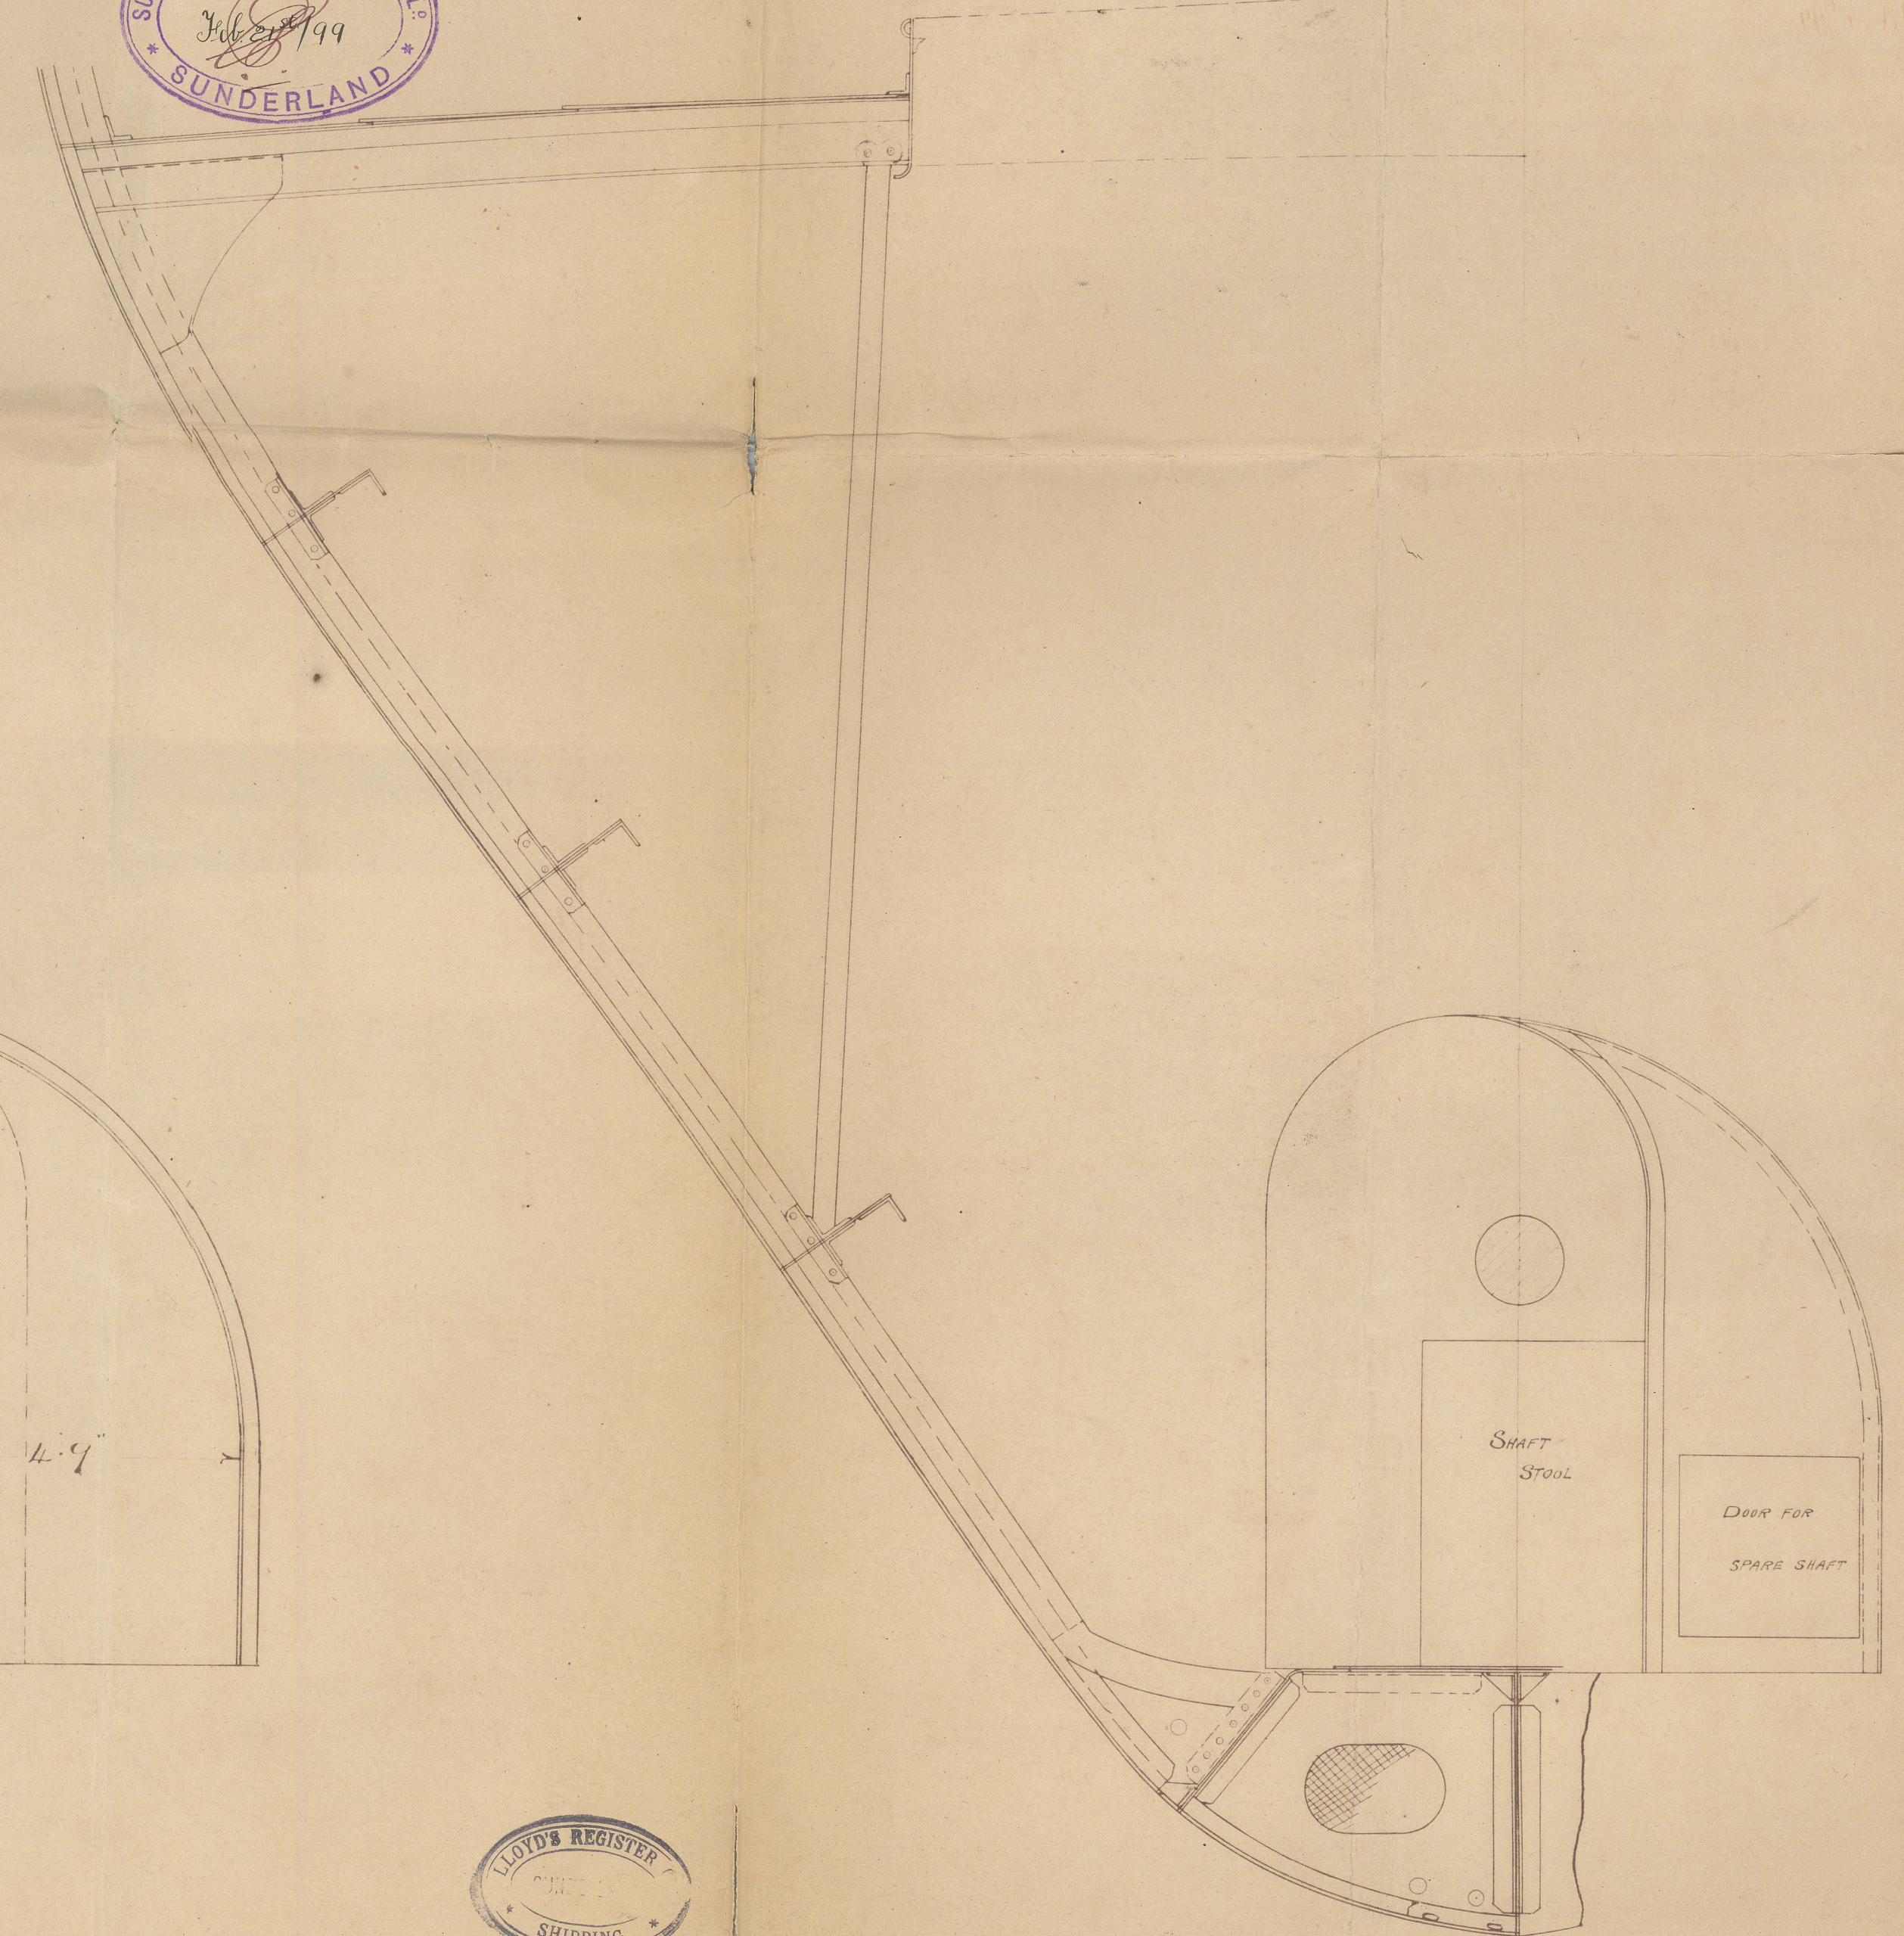

No.

© 2021

Enclose to

Messrs Lloyds Surveyors

Date, Feb. 21st/99.

SLD1018-0240 2/2

SS Wilcamia

Sunderland S.P.C.

No 199. Built 1899


Nearby, Sister vessel to

Wakool & Manning,

After forming

Lohe placed with

1st Entry when reported

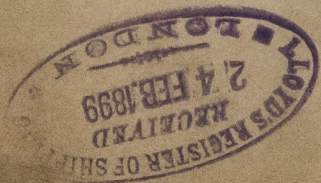

2021

Lloyd's Register
Foundation

2/0420-810175