
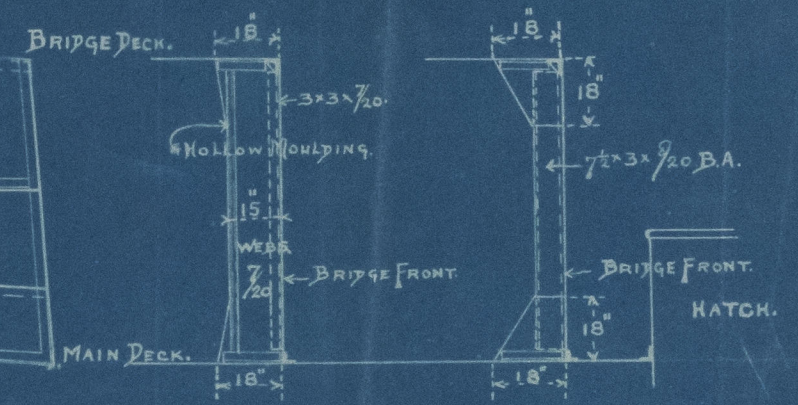


28. 10. 99

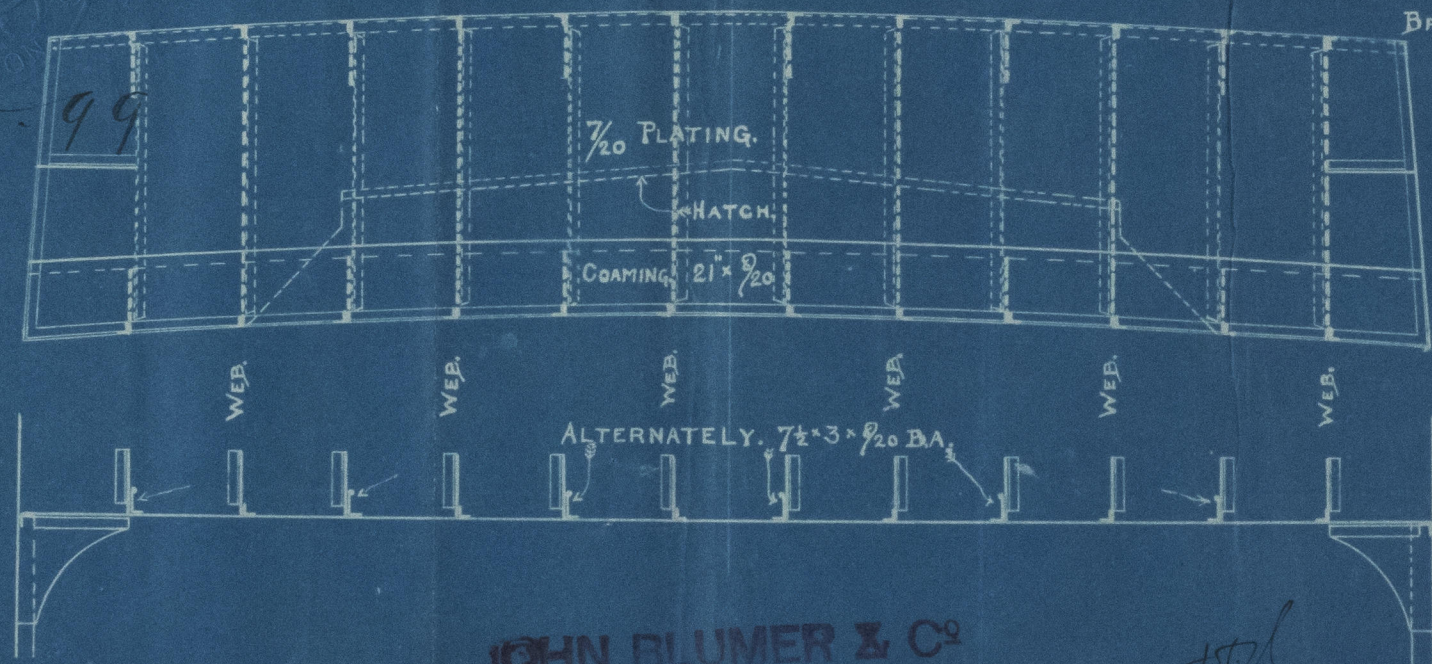

BRIDGE FRONT STIFFENING.

JOHN BLUMER & CO
SHIPBUILDERS,
SUNDERLAND

Oct. 26th 1899

28/10/99

S.S.Nº 152-3.

R



SL 1010-0230

J. BLUMER & CO. —

S. S. No 152-3

—BRIDGE FRONT 842—

S. S. "Hawthwood"

Sunderland. No 19931



© 2021

Lloyd's Register
Foundation

SLD1020-0230

