


Mr. 28.3.99

PUMPING PLAN. S.S. 152 & 3. **UNDER DECK TONNAGE 950 TONS**

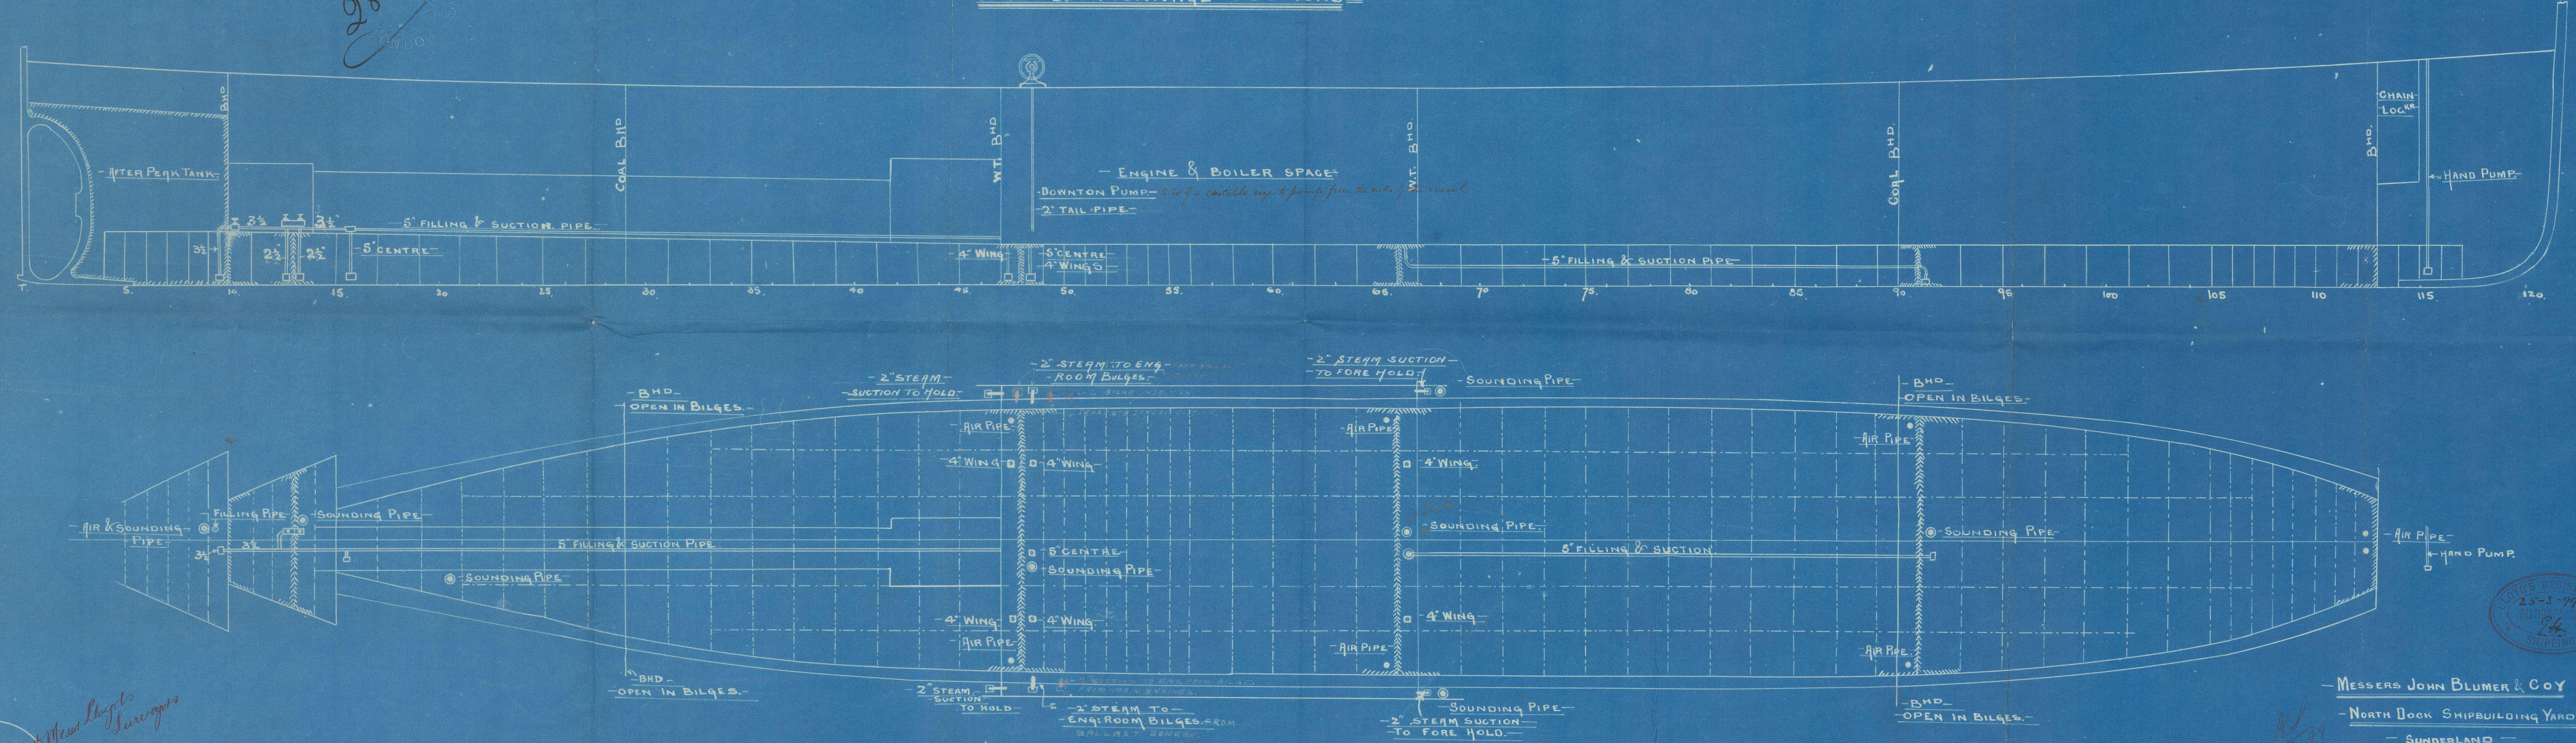

Enclosure to Messrs Lloyd's Surveyors

Messrs JOHN BLUMER & COY
 NORTH DOCK SHIPBUILDING YARD
 SUNDERLAND

March 18th 1899
893.25





J. BLUMER & CO

S. S. N^o 152-3

Pumping plant

S. S. "Hawkwood"

Sunderland. N^o 19931.

S. S. "Monkwood"

Sunderland. N^o 20070



© 2021

Lloyd's Register
Foundation