

"S. S. Hawkewood"

For the information of Surveyors and the Committee only.

Received at

Office.

186.

## Lloyd's Register of British and Foreign Shipping.

*Sund*(Report on Vessel No. *19931* Port *Sunderland*.)No. *4035.a*

## SHIP FORGINGS OR CASTINGS.

I have to report that the undermentioned Iron or Steel Forgings or Castings,  
manufactured by *The Sunderland Forge Co.*

of *Pallion* for the Vessel No. *152*, being built  
by *Messrs J Blumer & Co.* of *Sunderland*

have been inspected by me as set forth below, and found to be, so far as can be seen,

*sound*

The words FORGINGS or CASTINGS, IRON or STEEL, should be struck out as may be required.


Mark on Forgings.

Lloyd's

No. *4035.a**No. 6**North Carron**Sunderland 14/6/99.*

	STERN FRAME.	RUDDER FRAME.	STEM.
Material*	<i>Scrap</i>	<i>Scrap</i>	<i>Scrap</i>
How made	<i>Forged</i>	<i>Forged</i>	<i>Forged</i>
Dimensions	<i>8" x 4 3/4"</i>	<i>5 3/4" x 3"</i>	<i>7 1/2" x 2 3/8"</i>
Progress on Inspection	<i>Forged &amp; Smithed</i>	<i>Forged &amp; Smithed</i>	<i>Forged</i>
Date when Inspected	<i>Jan'y 12<sup>th</sup> to Feb'y 25/99</i>	<i>April 8<sup>th</sup> to 28/99</i>	<i>July 3/99</i>

SKETCHES OF FRAMES SHOWING POSITION AND DESCRIPTION OF WELDS OF FORGINGS, OR PARTICULARS OF TESTS APPLIED TO CASTINGS.

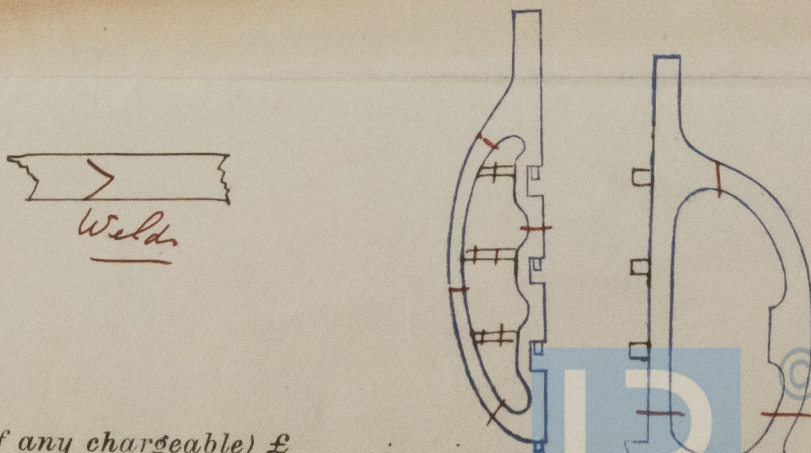

Fee (if any chargeable) £

To be paid at