

S. S. "Monkwood"

Lloyd's Register of British and Foreign Shipping.

Sund

(Report on Vessel No. 20070 Port Sunderland.)

No. 4036.a.

SHIP FORGINGS OR CASTINGS.

The words FORGINGS or CASTINGS, IRON or STEEL, should be struck out as may be required.

I have to report that the undermentioned Iron or ~~Steel~~ Forgings or Castings, manufactured by The Sunderland Forge Co. of Palton for the Vessel No. 153, being built by John Blumer & Co. of Sunderland have been inspected by me as set forth below, and found to be, so far as can be seen, sound.

Mark on Forgings.

Lloyd's

No. 4036.a



No. 6.

W. H. Cameron

*Sunderland
16/1/00*

	STERN FRAME.	RUDDER FRAME.	STEM.
Material*	<i>Scrap</i>	<i>Scrap</i>	<i>Scrap</i>
How made	<i>Forged</i>	<i>Forged</i>	<i>Forged</i>
Dimensions	<i>8" x 4 3/4"</i>	<i>5 3/4" - 3"</i>	
Progress on Inspection	<i>Forged & Smithed</i>	<i>Forged & Smithed</i>	<i>Forged</i>
Date when Inspected	<i>April 8th to June 17/99</i>	<i>Nov 8th to Dec 21/99</i>	<i>June 7/99</i>

SKETCHES OF FRAMES SHOWING POSITION AND DESCRIPTION OF WELDS OF FORGINGS, OR PARTICULARS OF TESTS APPLIED TO CASTINGS.

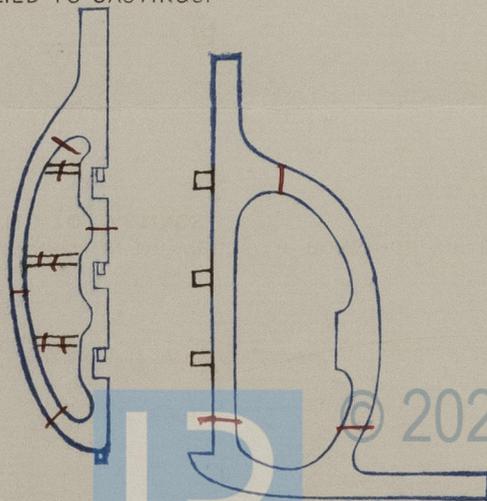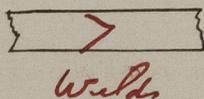

Fee (if any chargeable) £ : :

To be paid at

