S.S. No 457. & No 458 approved.

29.3.06
No. 458) 5.10.06
22.10.06
10.1.07

NOTE: BRACKETS UNDER WIDE STRINGER WHERE MARKED THUS X TO BE CONNECTED TO BULB ANGLE ON FACE OF STRINGER

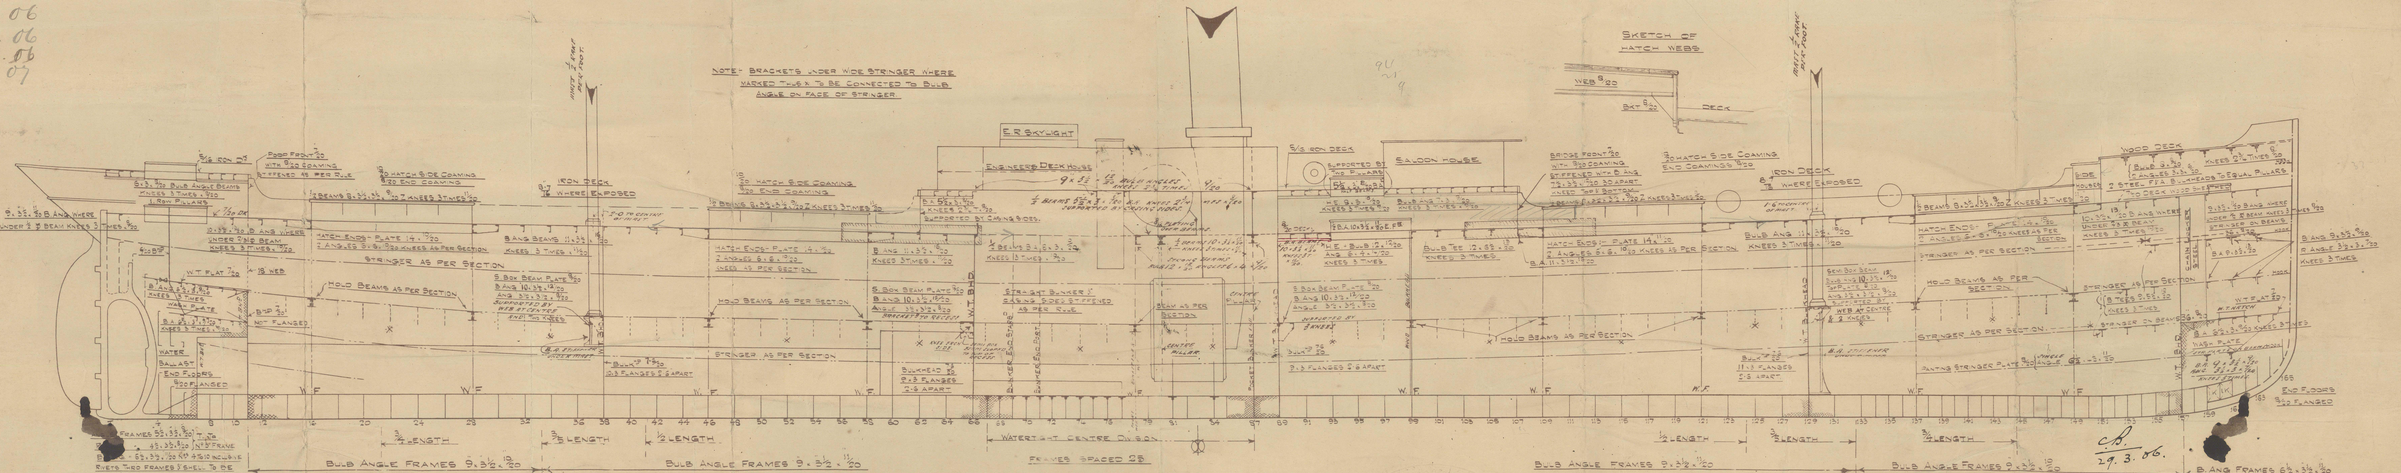

SKETCH OF HATCH WEBS

3620
457
22.8.06
AEM

29.3.06.

© 2021 Lloyd's Register Foundation

PROFILE

S. S. N° 457.

S/s. "Arnell" (457) & N° 458

Std F.E. Rpt. No 23428.

(458) s.s. Brinkburn'

Std. FE. 24065'

SLD1028-0134

© 2021 Lloyd's Register Foundation