


N^o 150.

151

N^o 151
Compo S. build^d by W Pile
Rev 9/7/66
Rev

Plate 30" x 9 1/16"

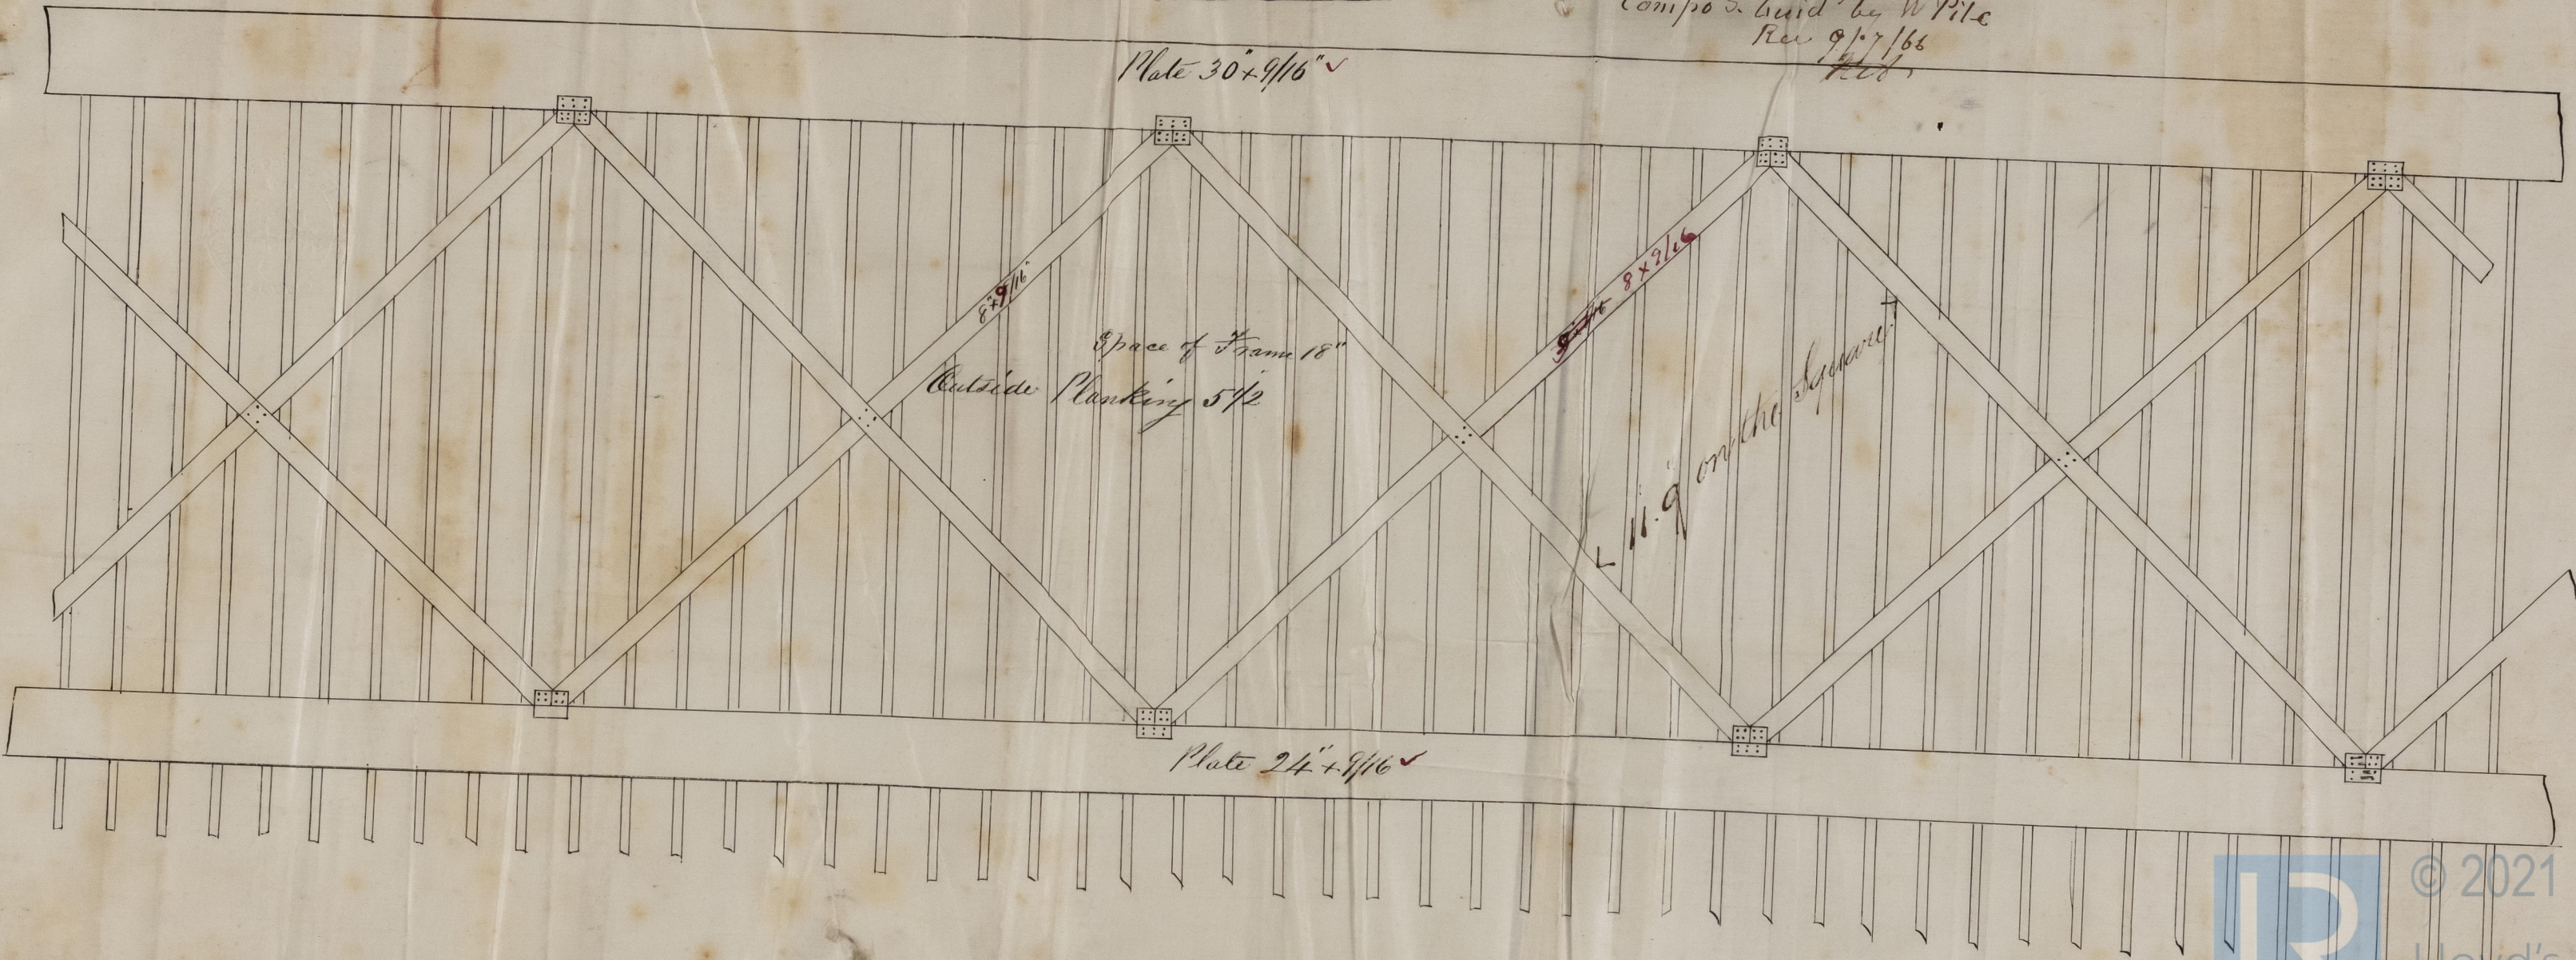

© 2021
Lloyd's Register
Foundation
9-7-66
519937-0114