


Midship Section of C. S. 152.

M. J. being builder

Per 29/1/69

"Collingrove" M

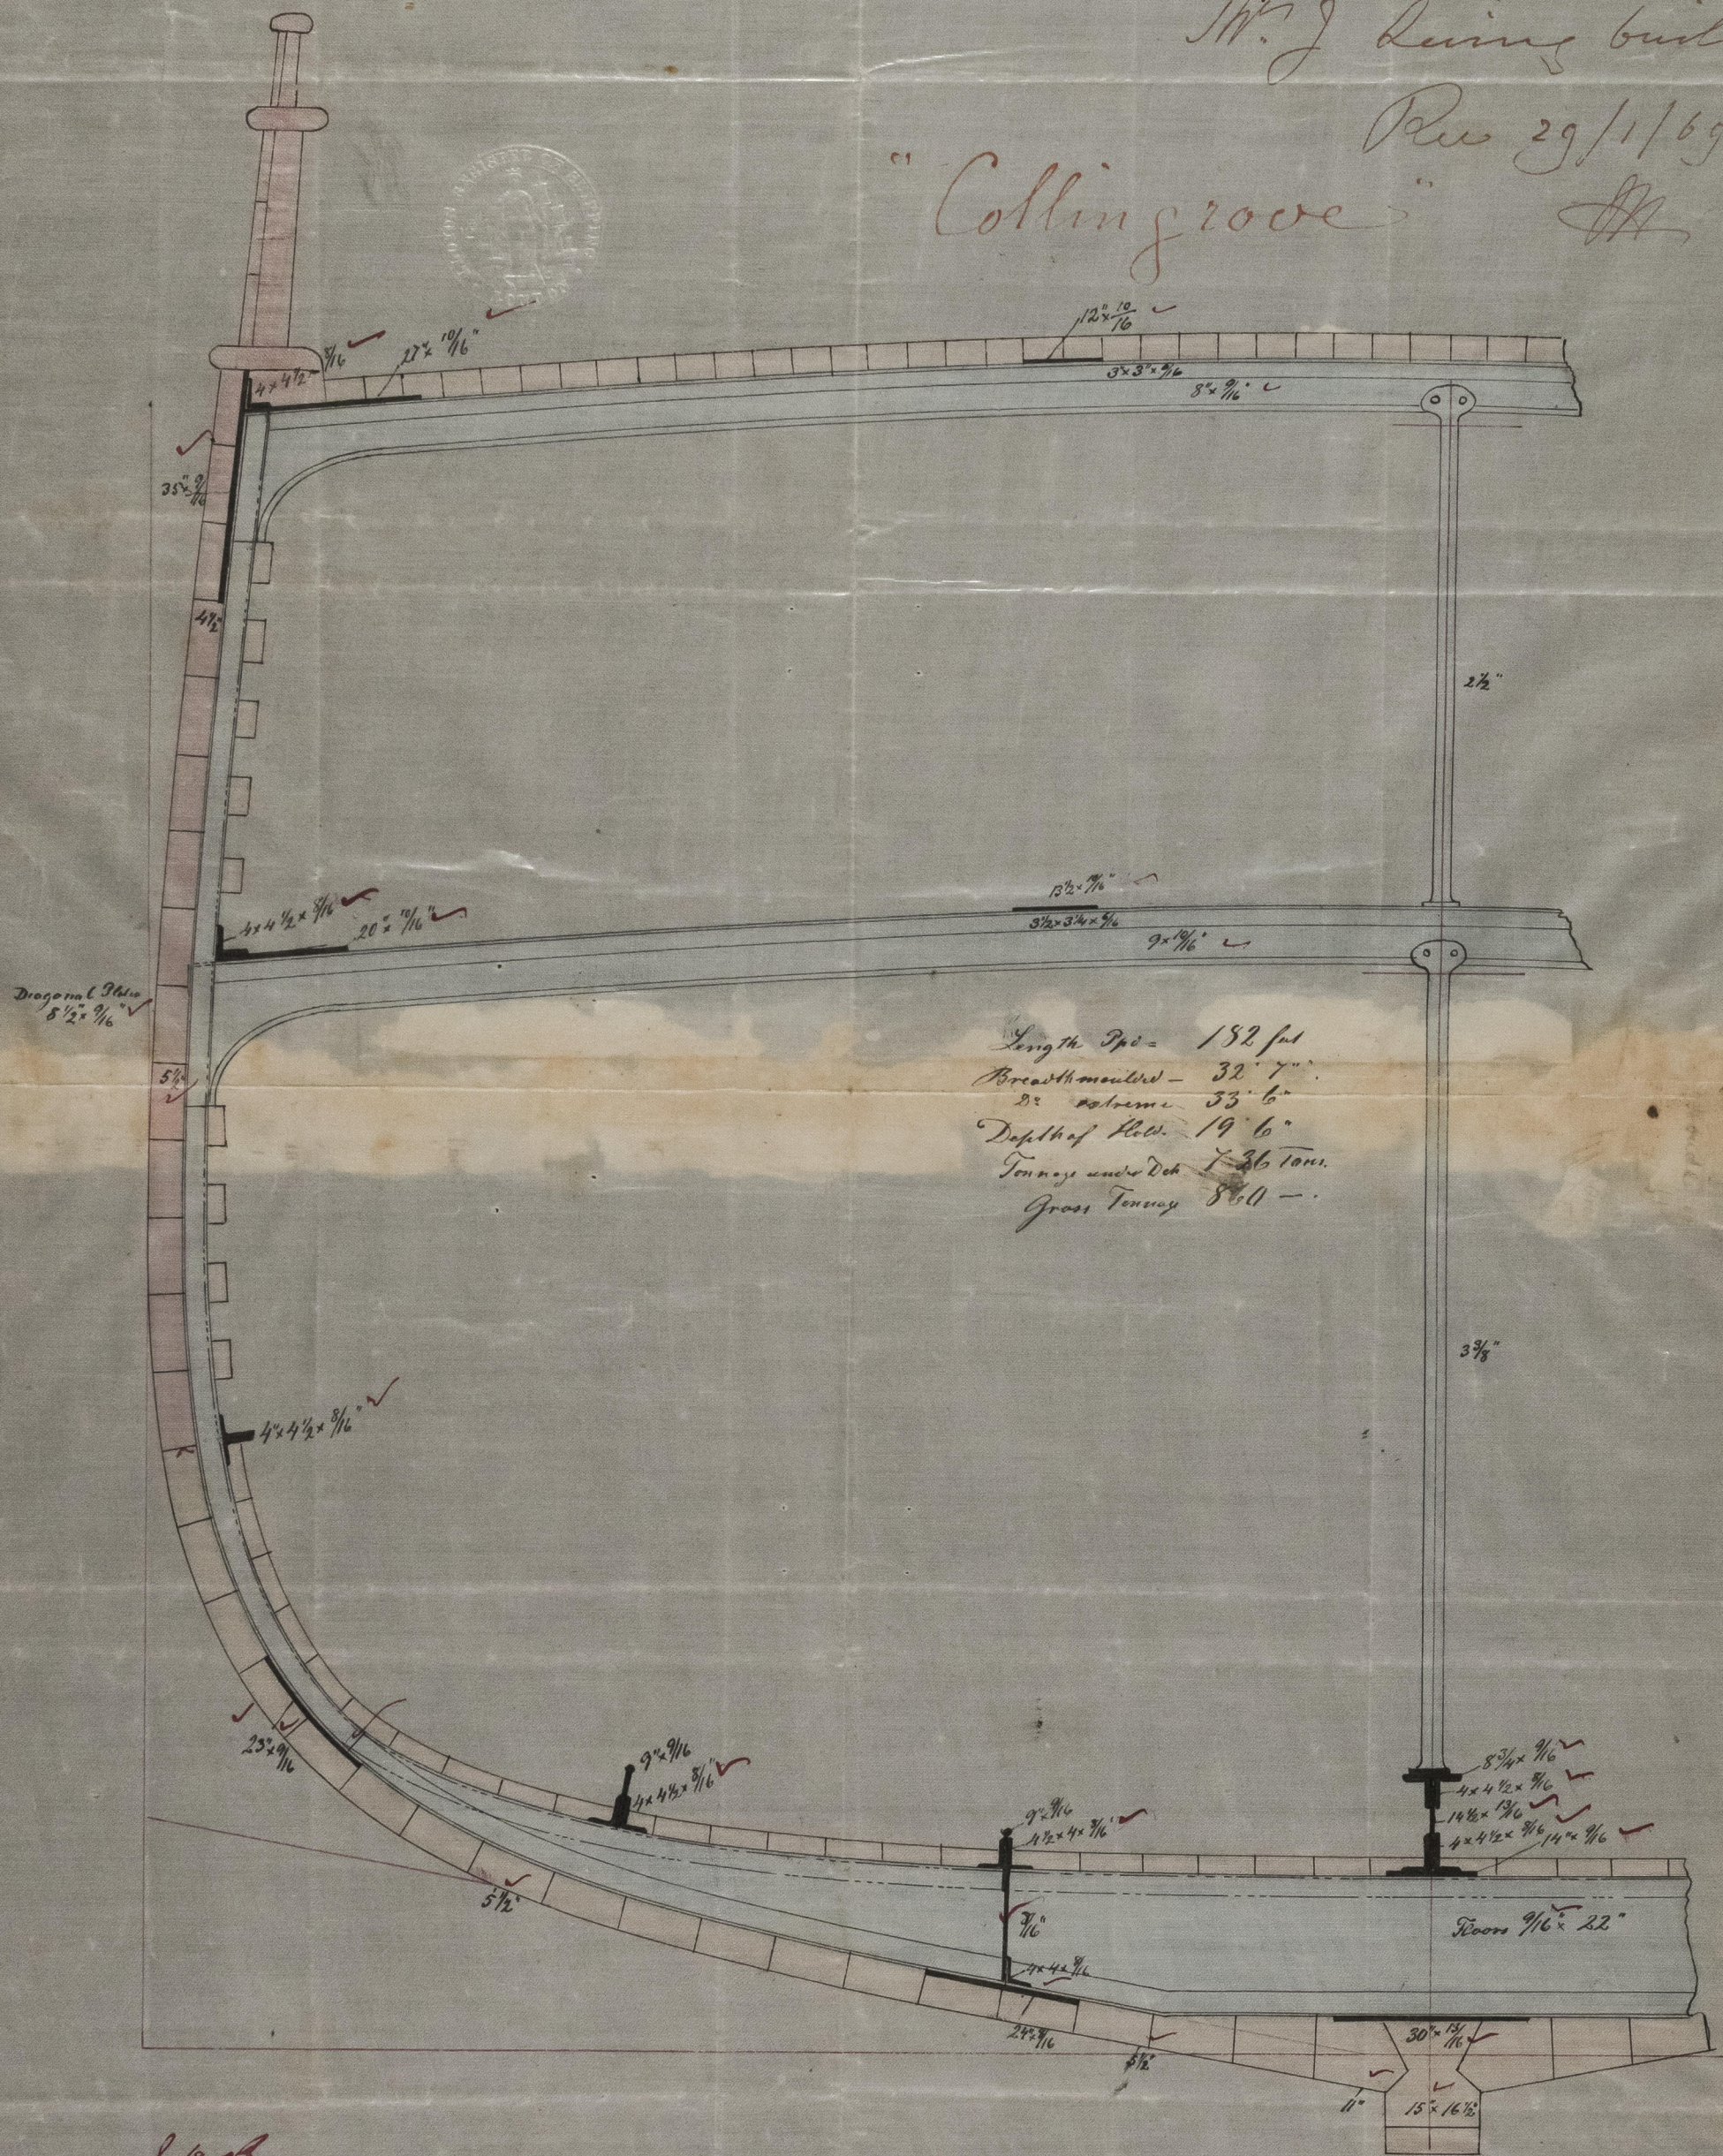

1898
30.1.69



© 2021

Lloyd's Register
Foundation