


MOUNSEY : FOSTER,  
IRON SHIP BUILDERS  
SOUTH DOCK.  
SUNDERLAND

B<sup>16</sup><sub>6</sub> "Kingdom of Sweden"

Rec<sup>d</sup>: 25<sup>th</sup> Sept  
 1874. J. M.

SCALE  $\frac{1}{2}$  INCH = 1 FOOT

Rev 26/9/74

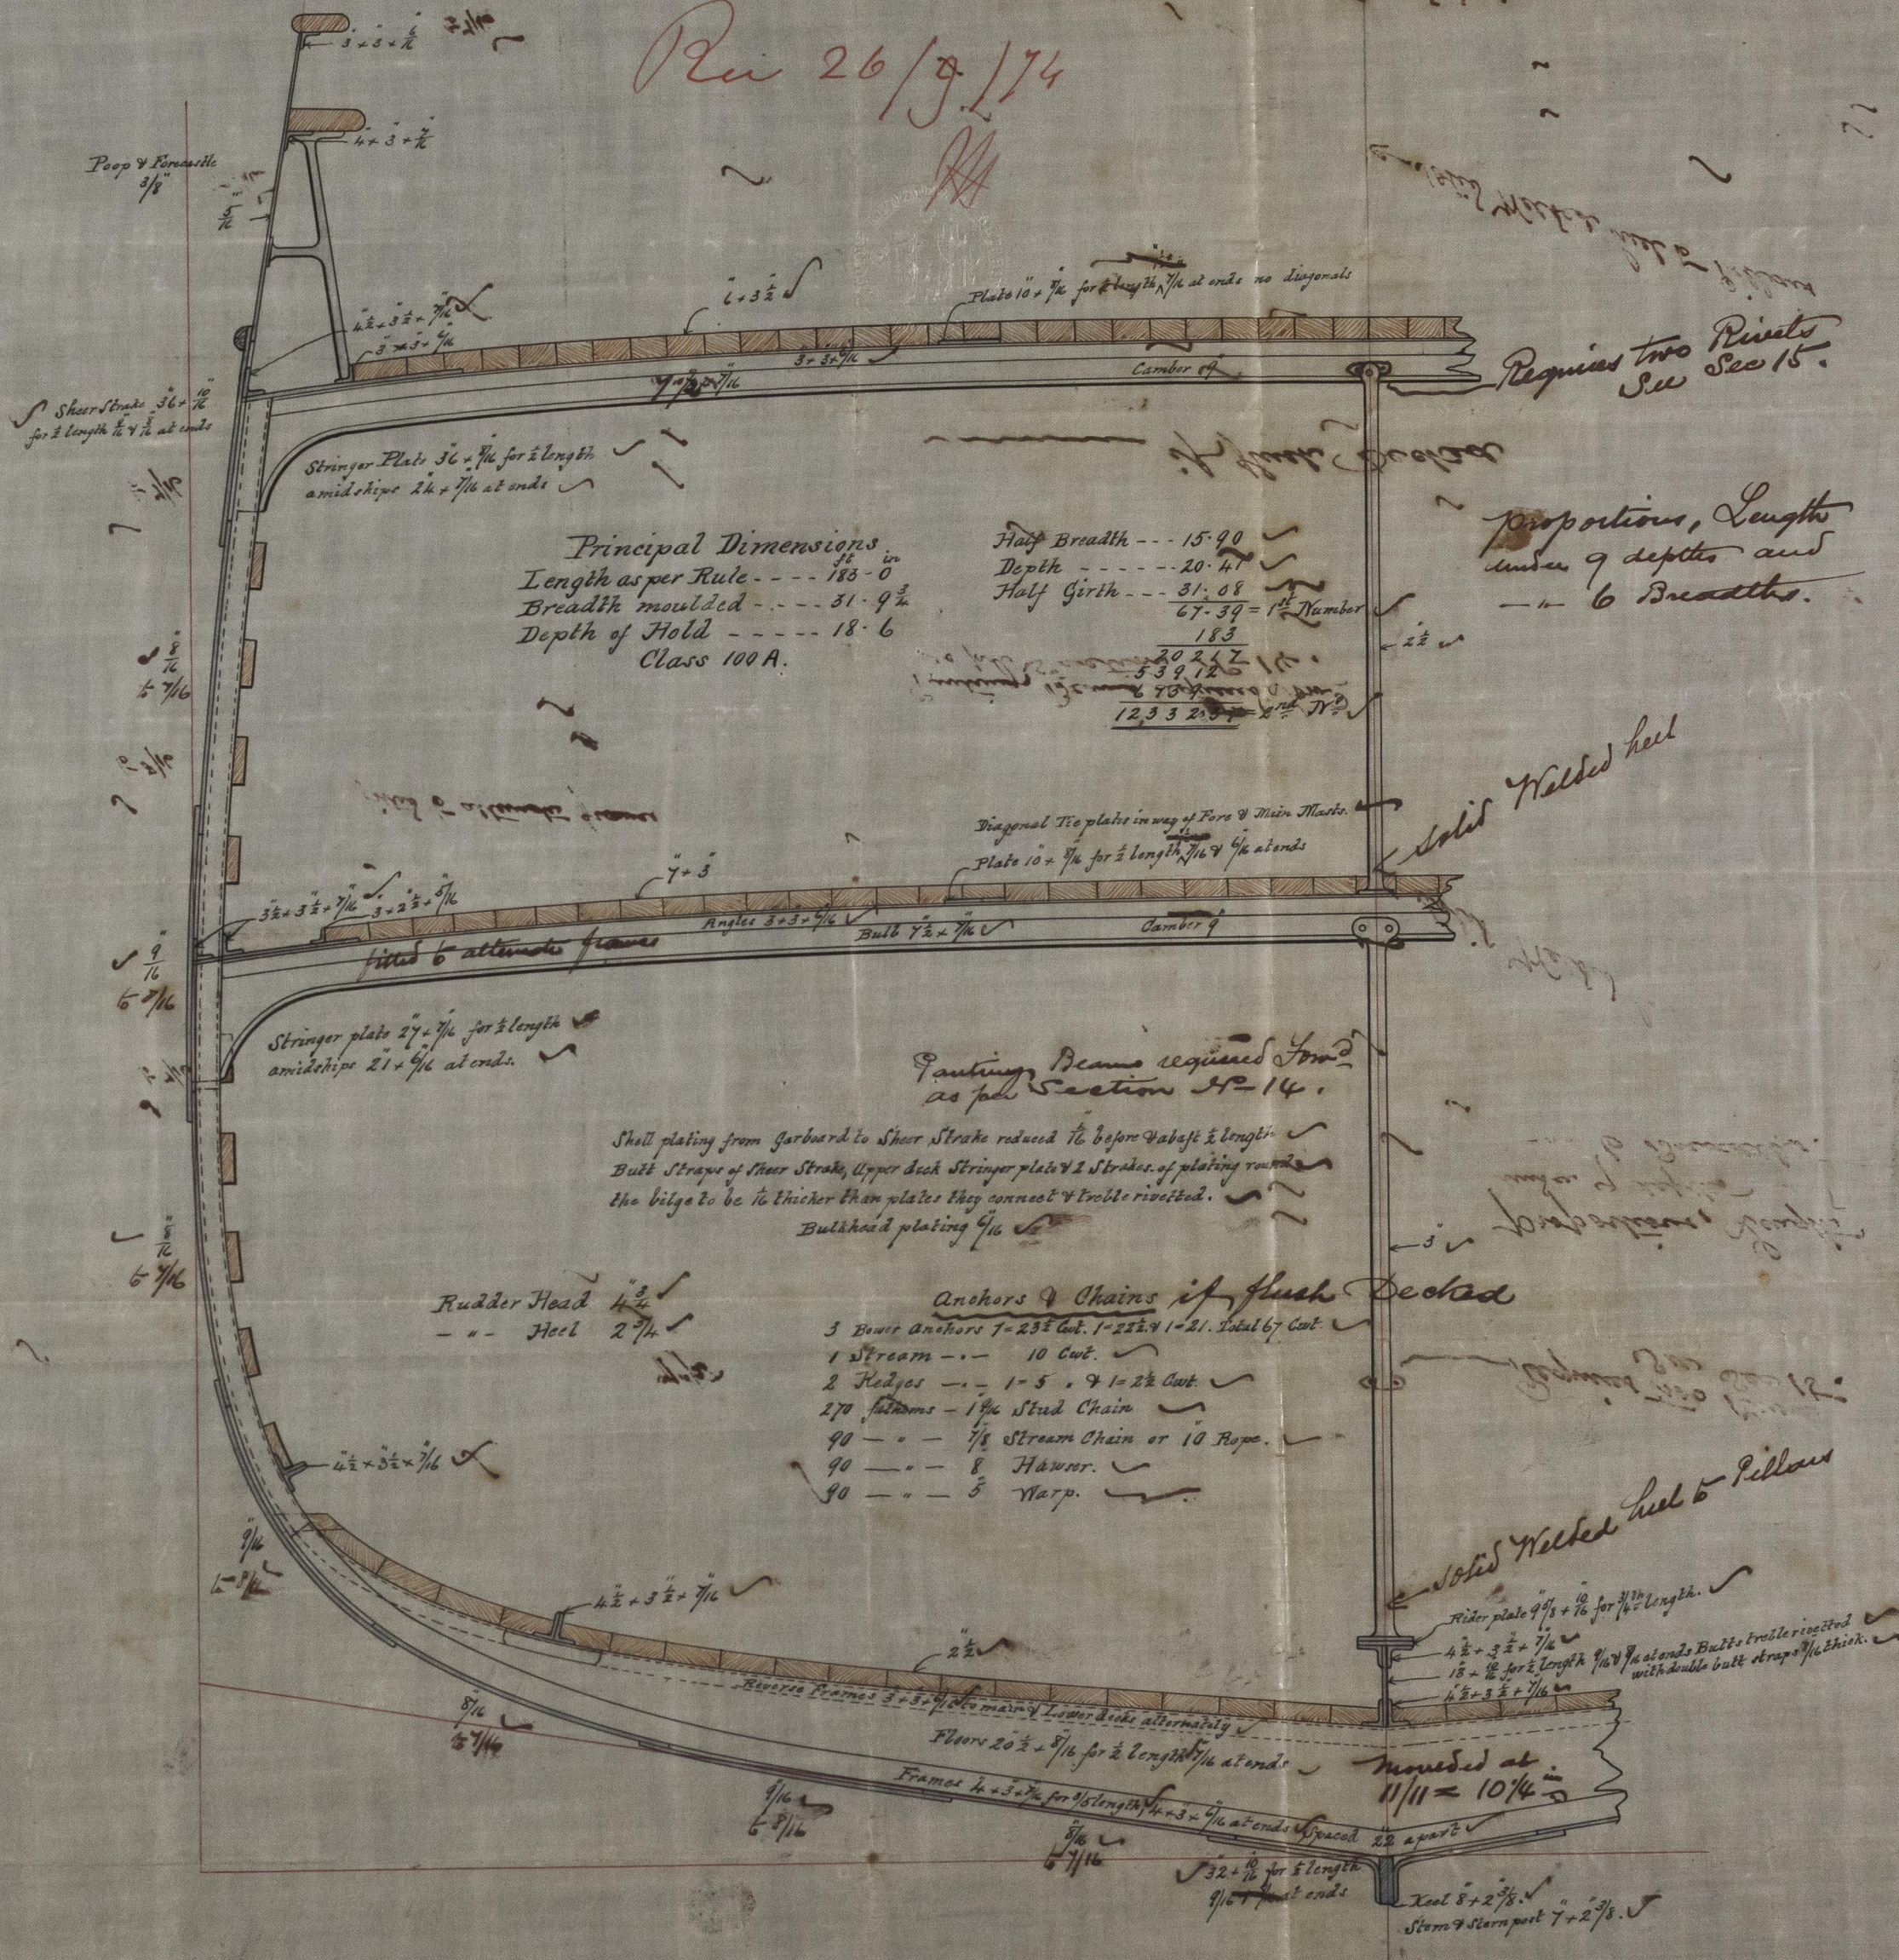

Sr. to Surveyors  
26.9.74

26/9/74

T. C.  
174  
R

© 2021

Lloyd's Register  
Foundation  
SLD438-0487