


Ship "Torrens" Report No 11249.

Scale 1/8 of an inch equals 1 foot -

Fore & Main Mast 86 feet long Fore mast reduced to 84, Main Mast to 85.

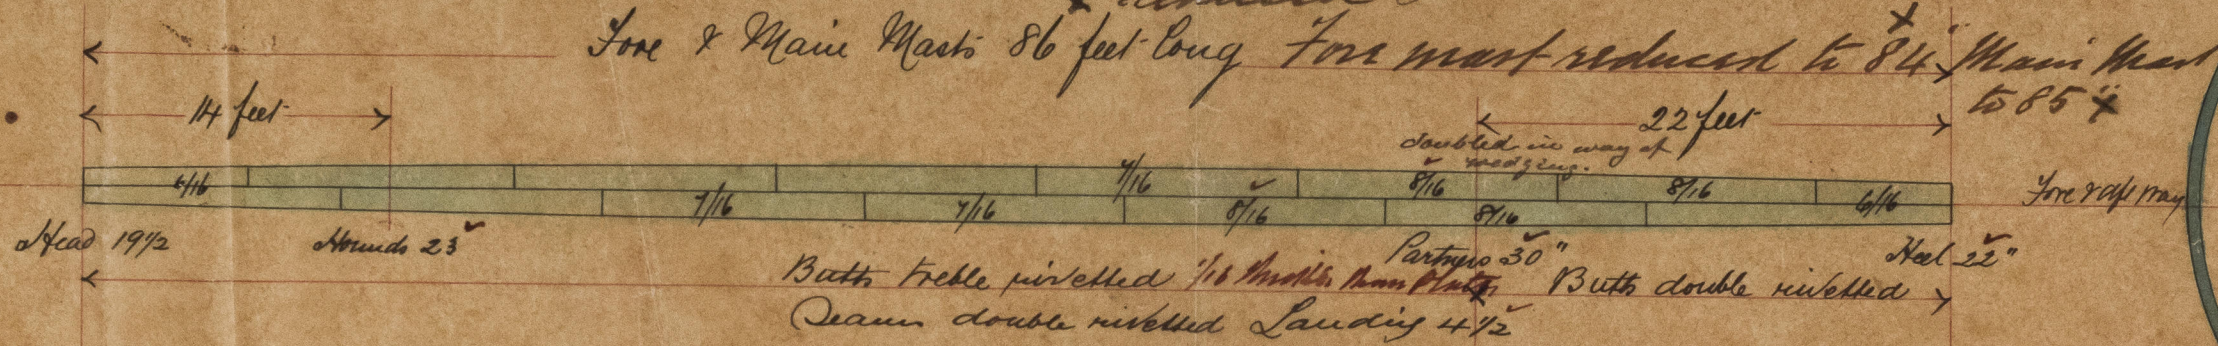

Section of Fore & Main
Mast at Partners

30 inches diameter

Scale $1\frac{1}{2}$ equals 1 foot-

Recd

Section of Bowditch.

24 inches diameter

• Scale $1\frac{1}{2} = 1$ foot.

Bowripit 40 ft - Corp

20 feet 9 inches $\frac{1}{2}$ X

Cap 17 1/2"

Bed 24 ¹⁷⁶

Steel 22"

Diaphragm plate

Mixer Mass 20 ft long

Maizen to 78' 6"

11 feet

27 fr.

Head $1\frac{1}{4}$

Novendo 173/4

Partners 22 1/2

Neel 163/4

Partum 22 1/2
Seams double knitted Landing 3 3/4

Size of Whizzer tract approved

One & Main Lower Yards 22 ft Long
32 feet.

82 feet

Edw 10"

Centre 20"

Ends 10"

Two plates in the wound. ^{Center 20"} Seam single rivetted. Butto Keble rivetted.

Fore & Main Topsail Yards 69'-0" long

Ends 8 1/2

Centre 14" -

Ends 8 1/2

Caenus single rivelled Landing 2 1/4 Butts table rivelled

Section of Fore & Main
Top sail Yards
at Centre

14 inch diameter

Scale $1\frac{1}{2}$ - 1 foot