

Jan 9th
1875

Midship Section of No 211

Composite ^{iron} sailing vessel.

220' x 37' x 21'6"

Classed at Lloyd's.


Scale: 1/2 inch = 1 foot.

Under 1200 Tons.

2 years 9. Metal
14 du Wood
16 A.

Ship 'Forever' Report No 11.249

Poop & Topgallant Forecasts

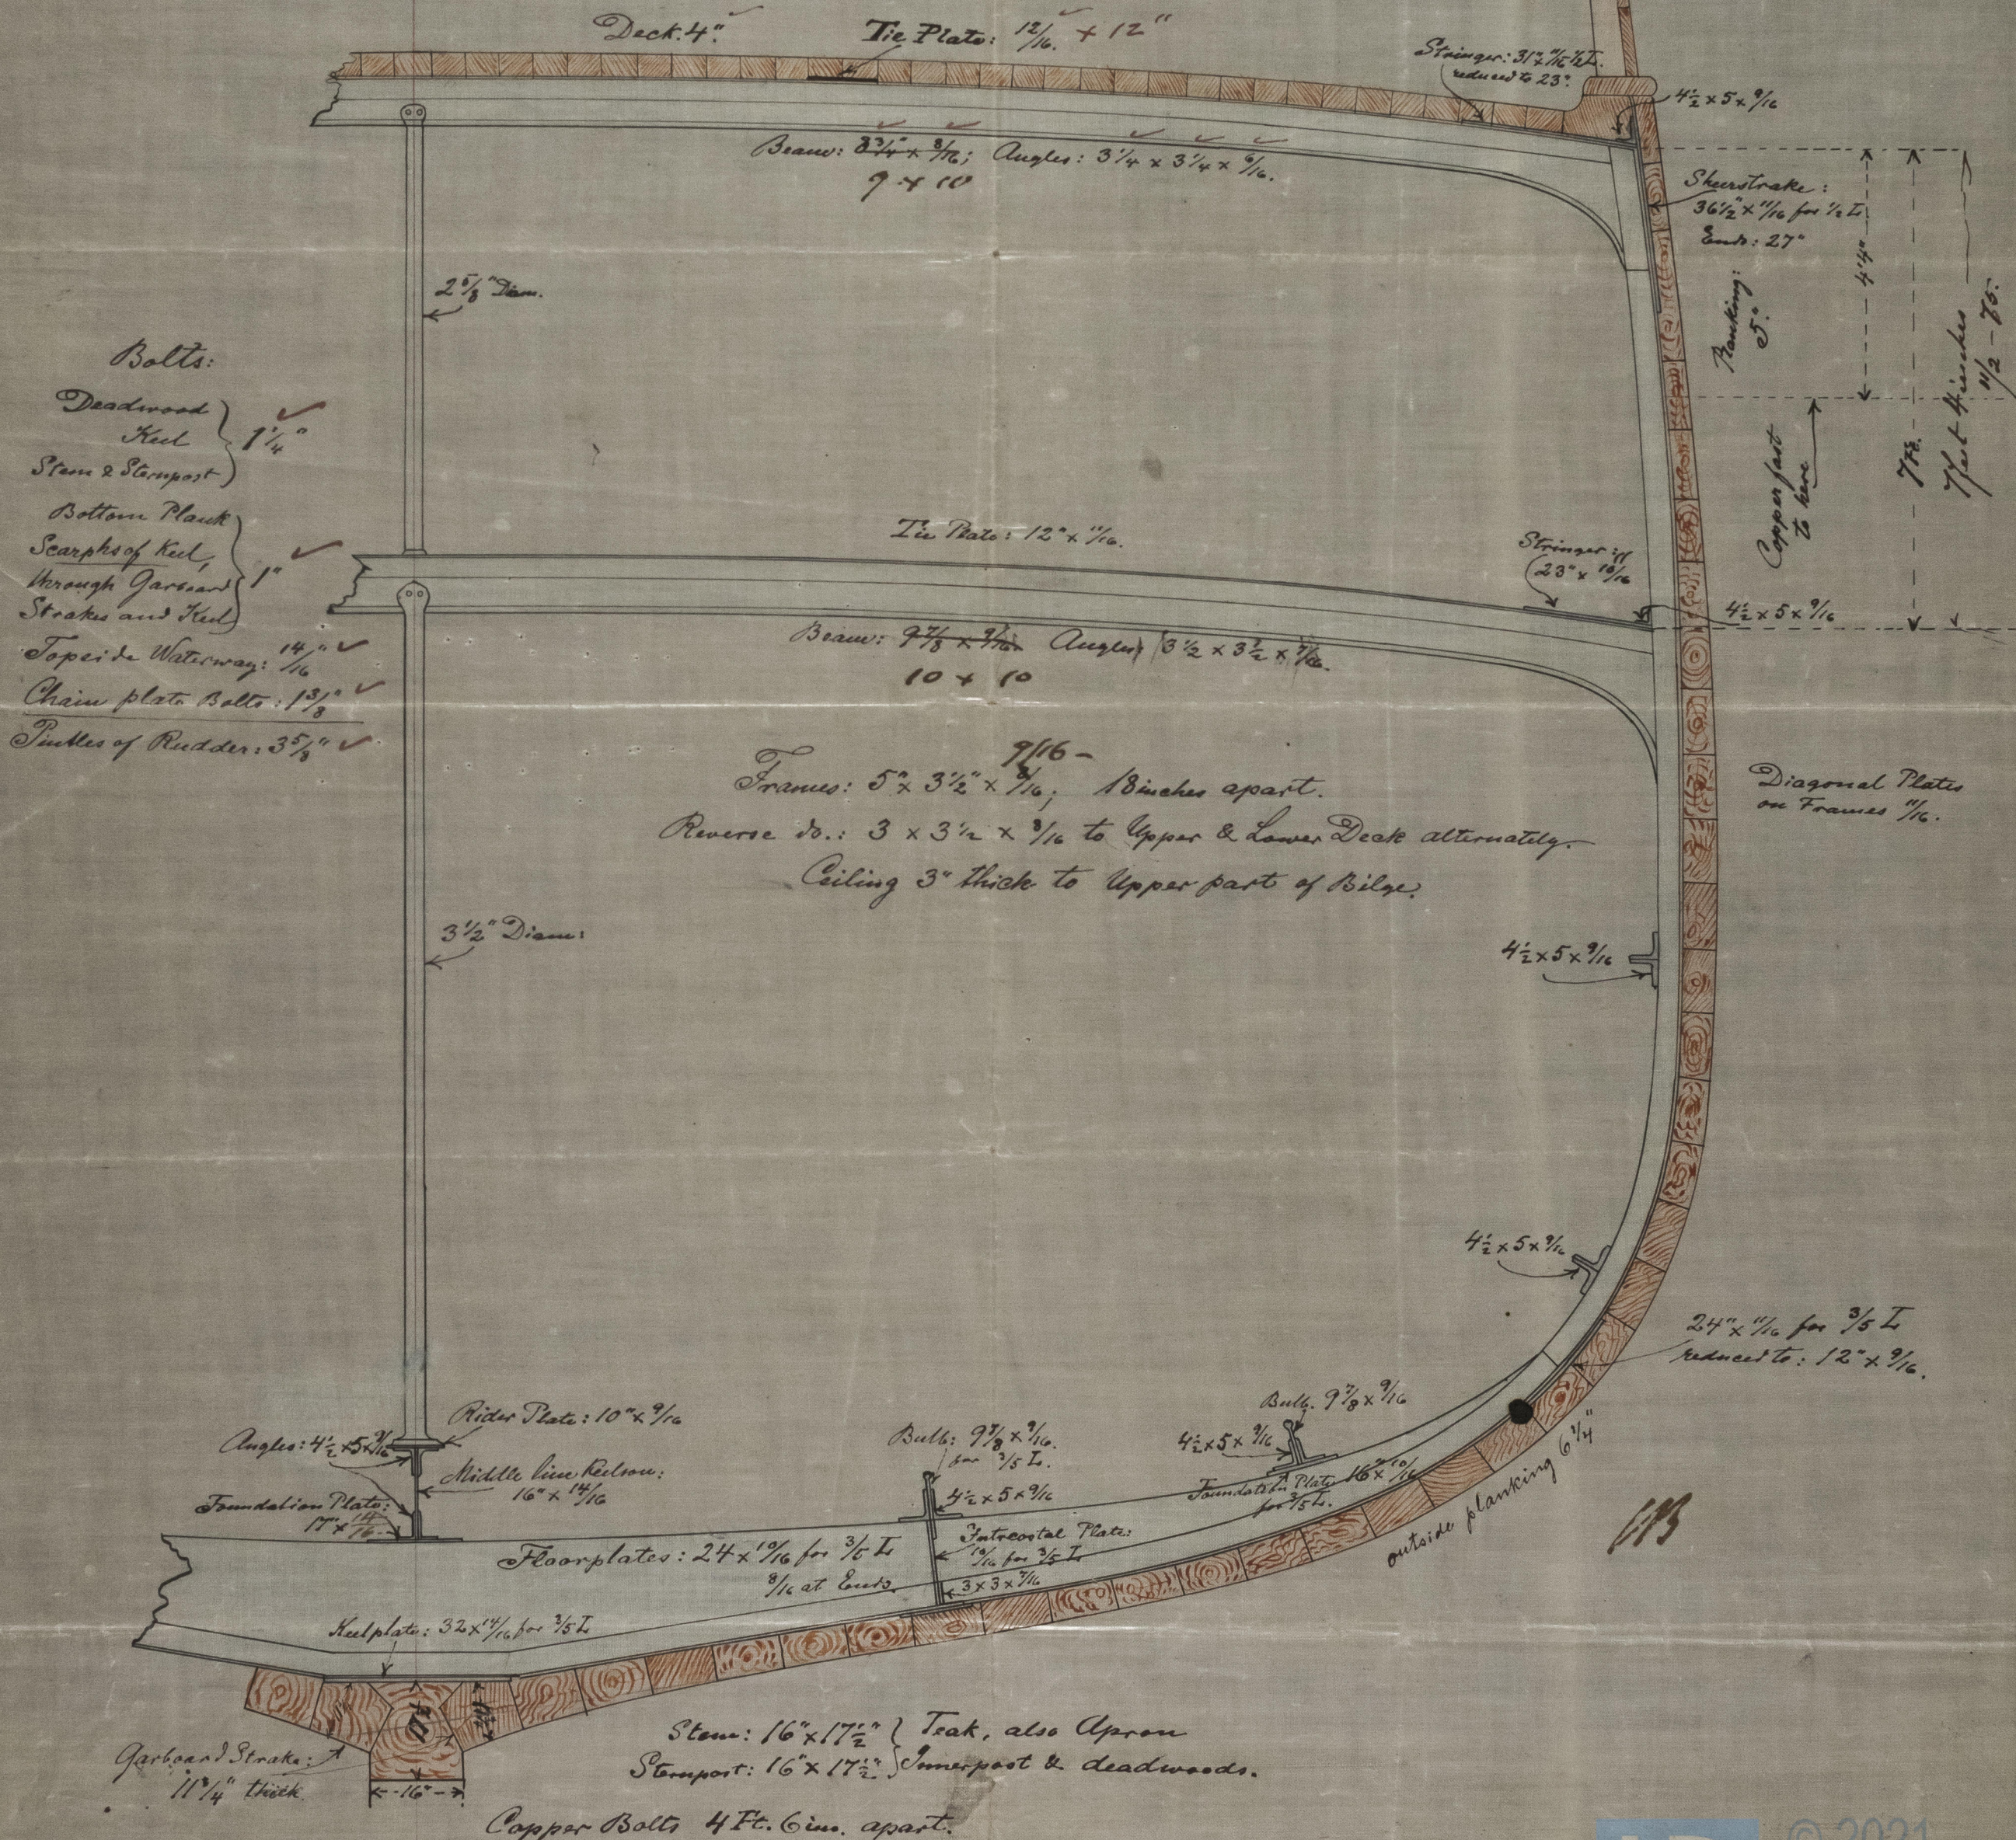

© 2021

Lloyd's Register
Foundation

Cop: 11/2-1875

SLD938-0537








SLD938-0537

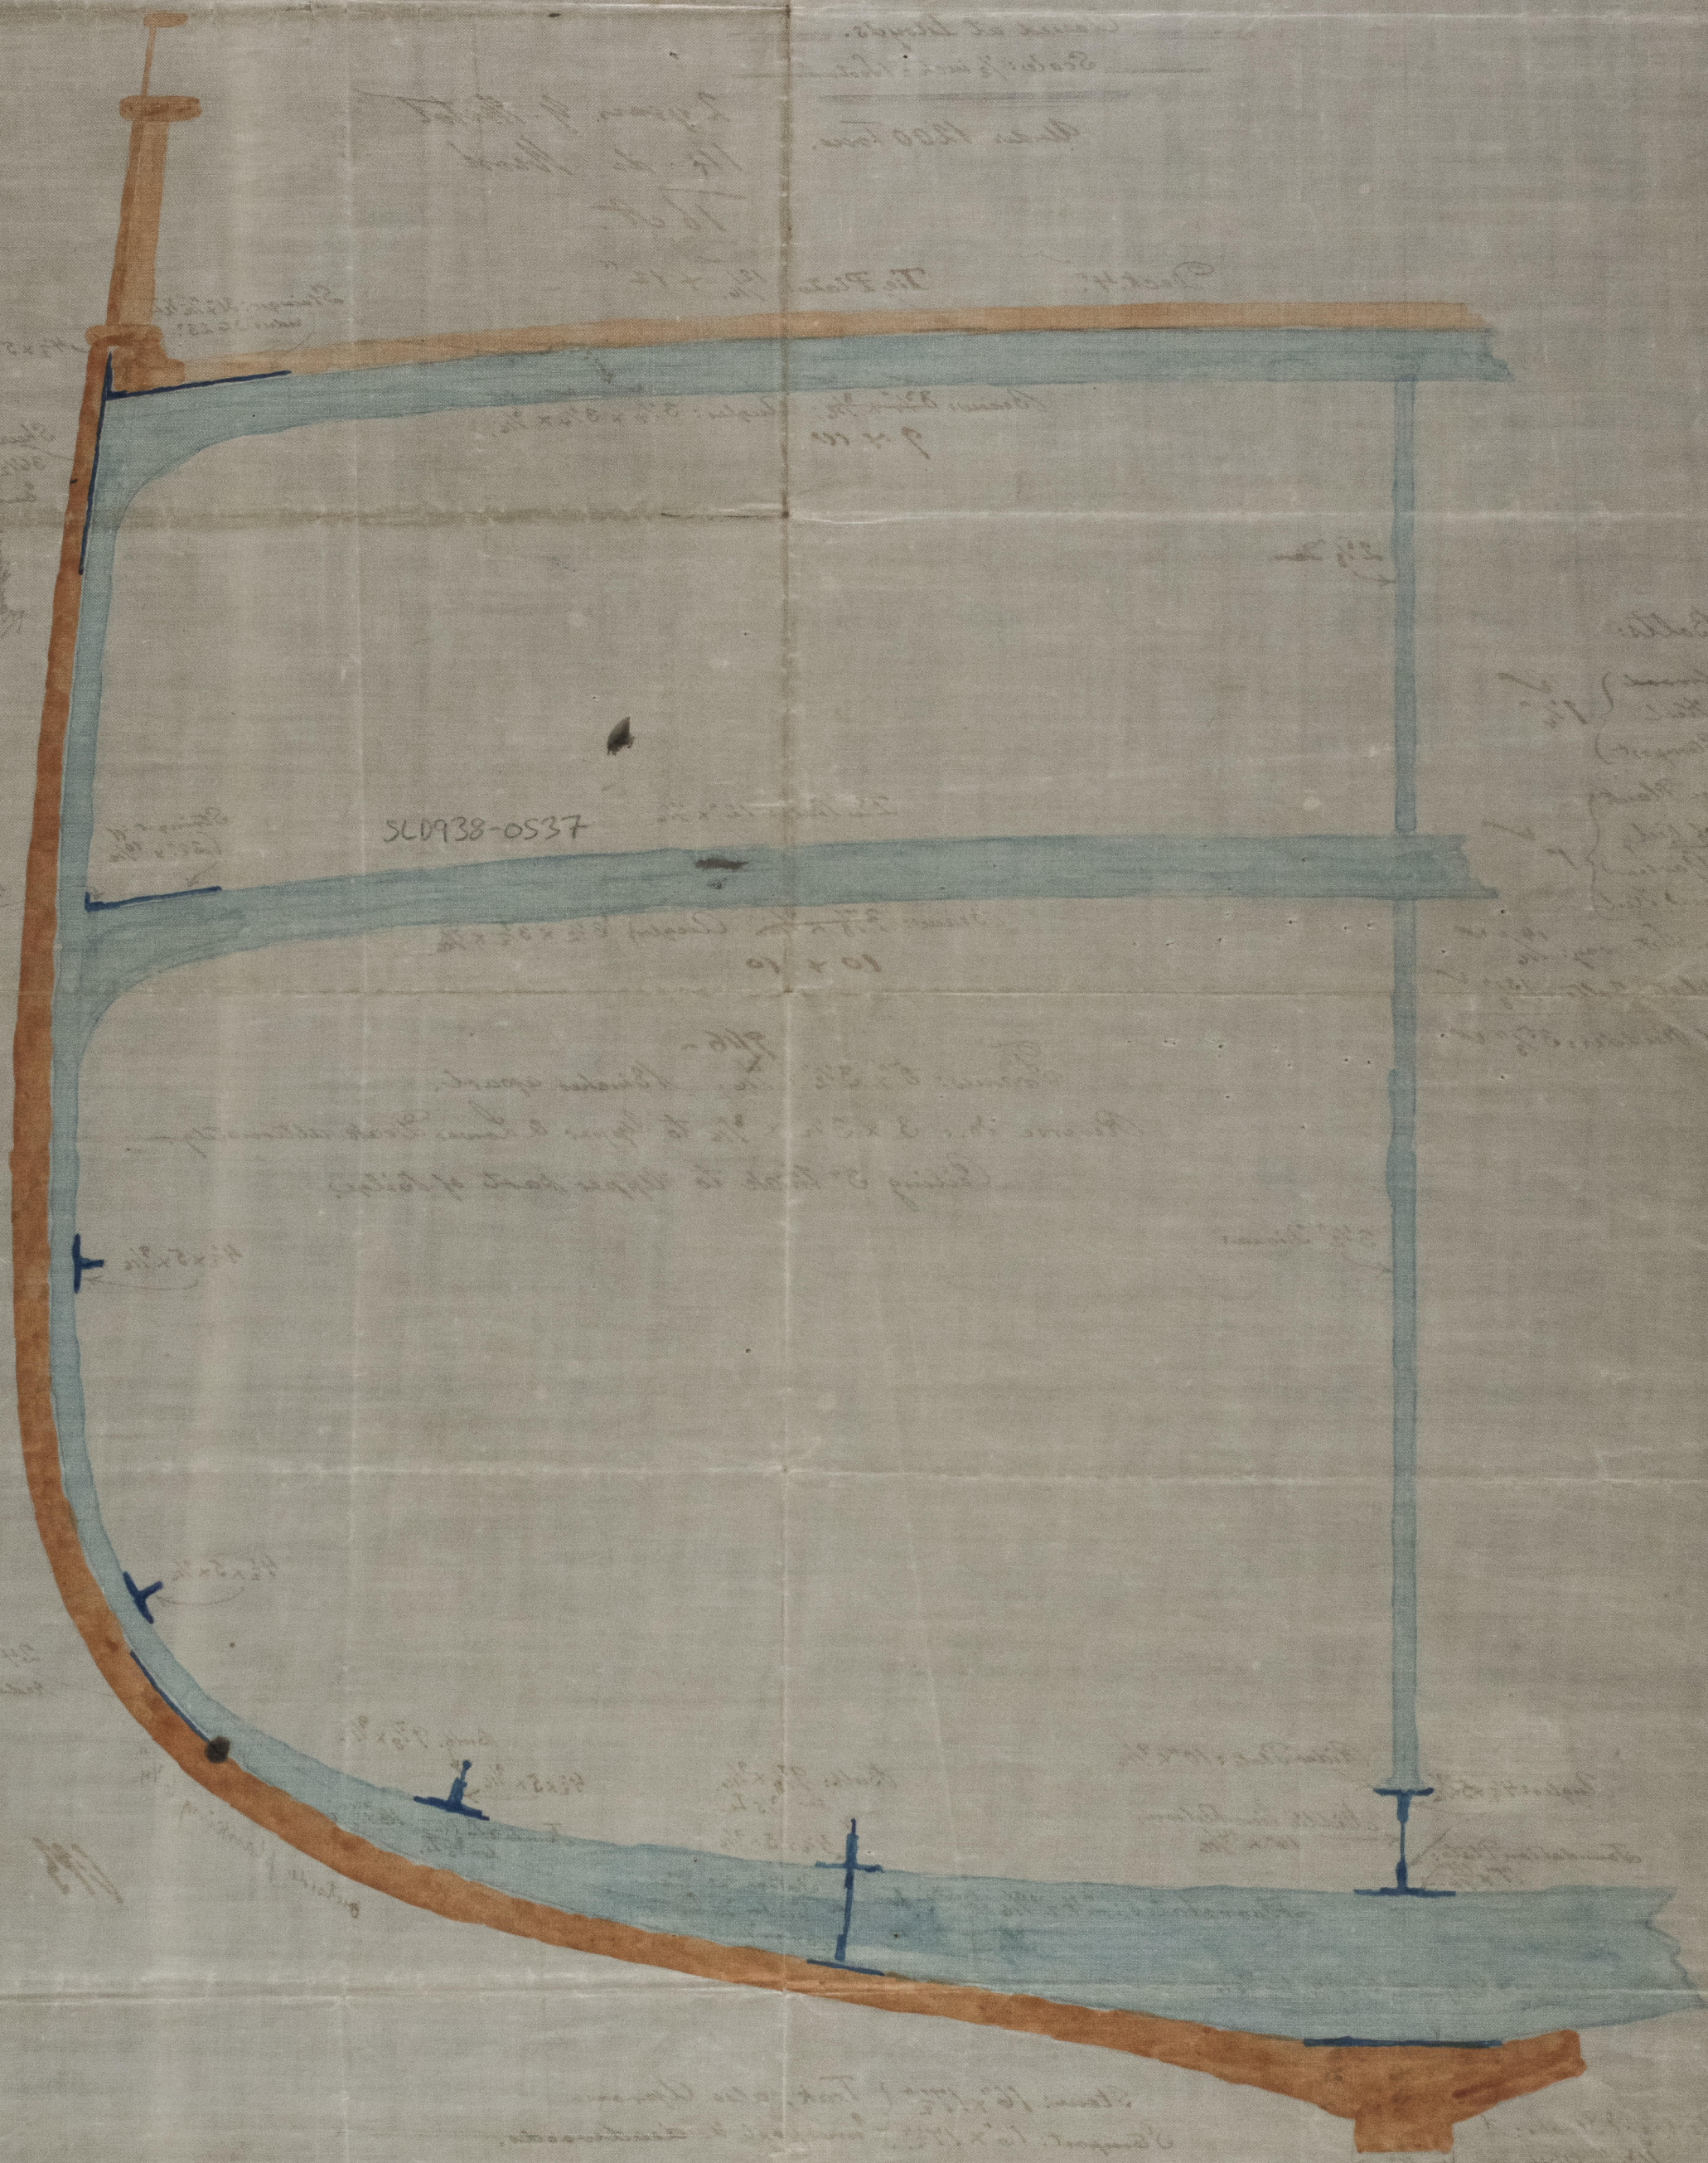

© 2021
Lloyd's Register
Foundation