




Howse Elizabeth Allen Sunderland report N° 12,665 April 26th 1881

S. S. N° 114

Sketch of Centre Longitudinal Bulkhead

Scale $\frac{1}{2}$ " = 1 Foot

5/16 letter 29 Apr 1881

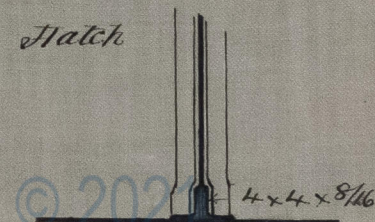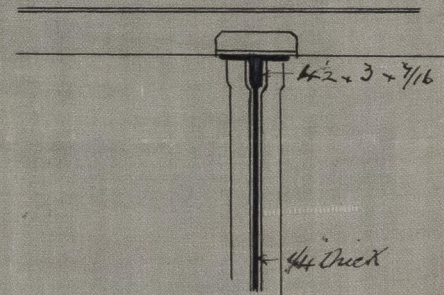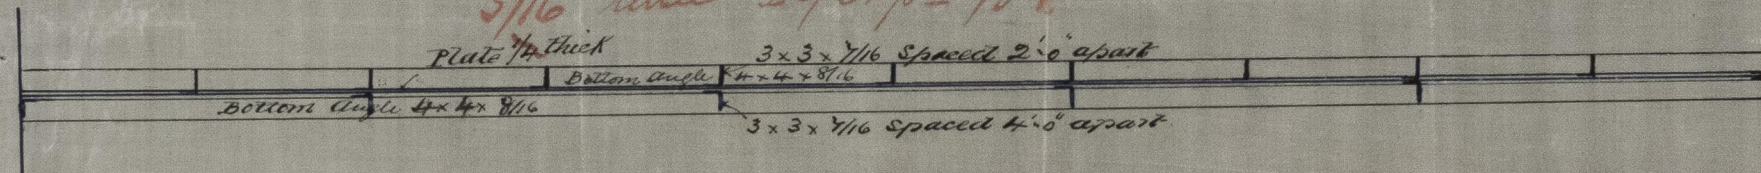


© 2021 Lloyd's Register Foundation

SLD940-0013

29/4/81

Howe & Edwards, 111, 112, 113,1000

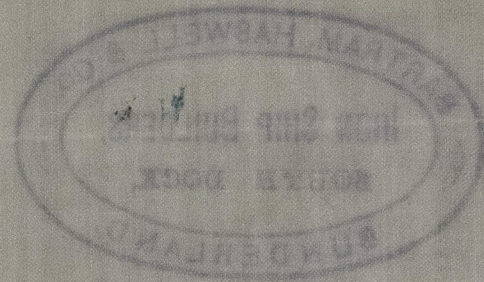

© 2021

Lloyd's Register
Foundation

SLB940-0013