


Scale $\frac{1}{8}" = 1 \text{ Foot.}$

REPAIRERS
SUNDERLAND

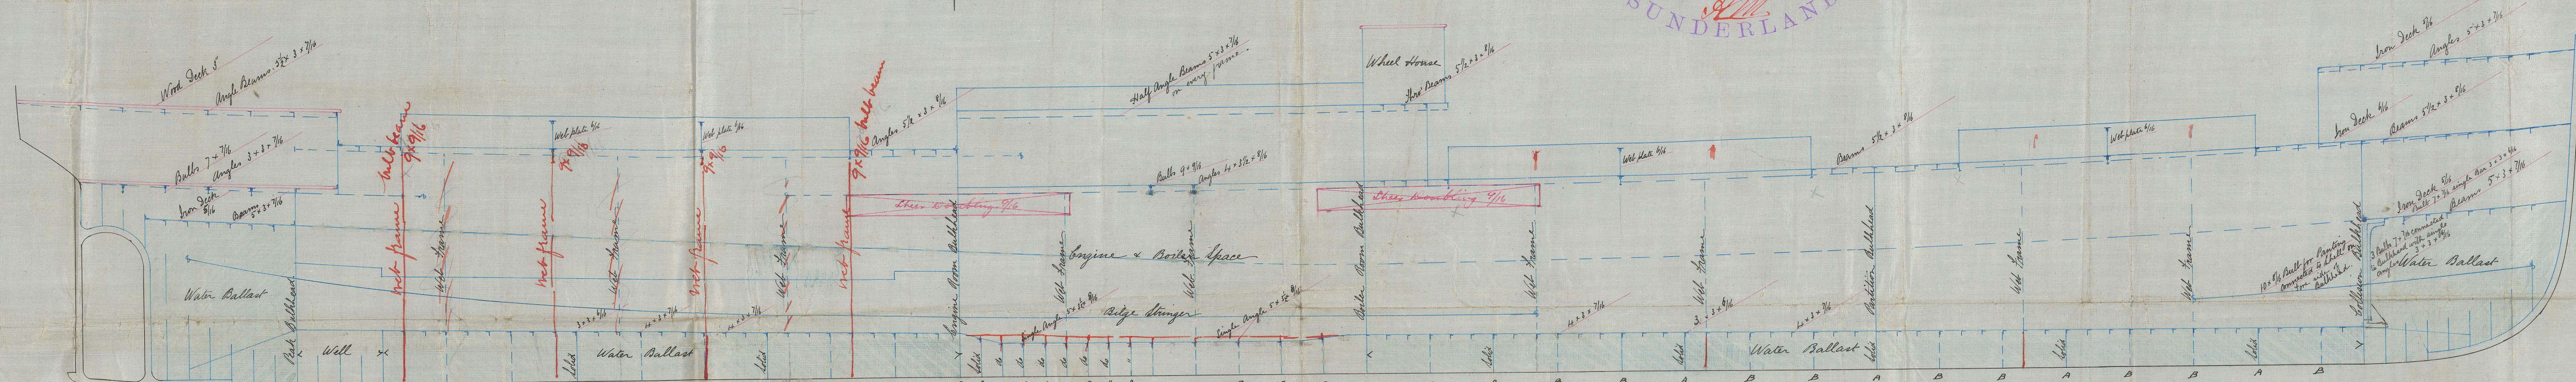

Solid floors marked A.

Extra Brackets for Boiler Heating
as required.

Bracket floors marked B

18. M J. P. L.
11/11/80 11/10/80