


SCREW STEAMER

Nº 164

JOSEPH L. THOMPSON & SONS
IRON SHIPBUILDERS,
(NORTH SANDS),
SUNDERLAND
METAL PIPES

Iron sp. Dorset Sunderland report N^o 12681

M
11.1.81

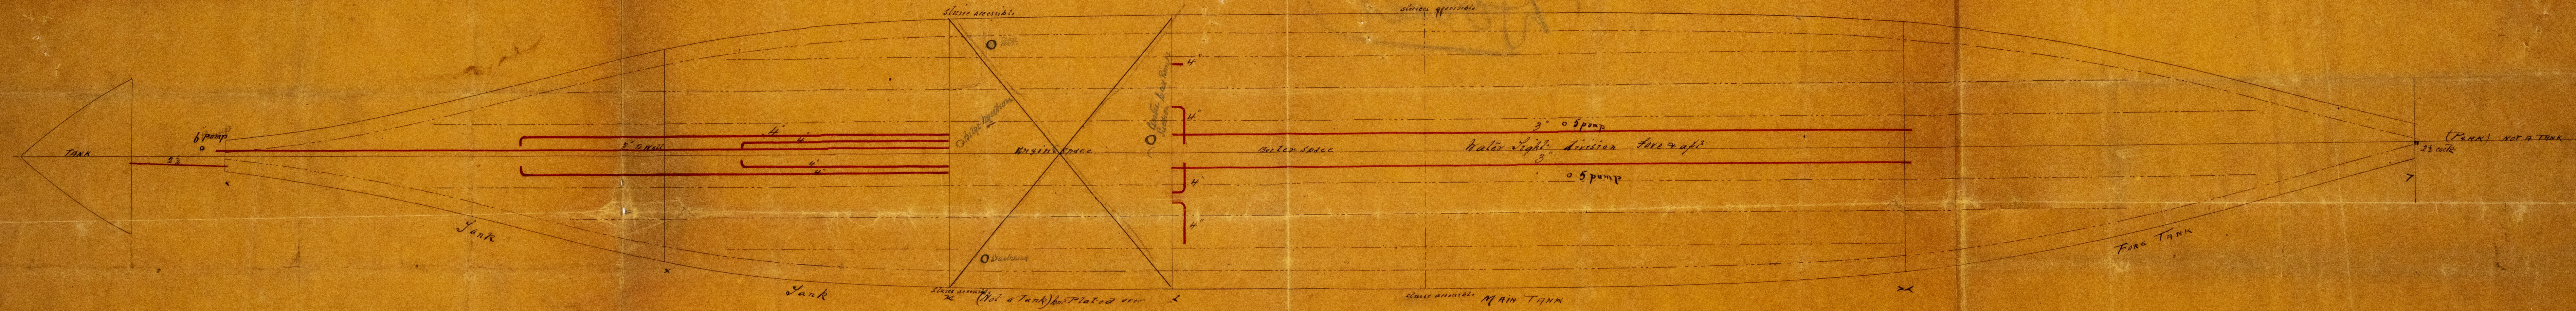

STILLER

Handwritten text, possibly a signature or name, written in cursive.

Direct



© 2021

Lloyd's Register
Foundation

303940-0087