


Ltr to Sld 14/4/81  
 Jm  
 14/4/81

SCREW STEAMER.  
No. 63

Iron & Godalming Sunderland report no. 12.401.

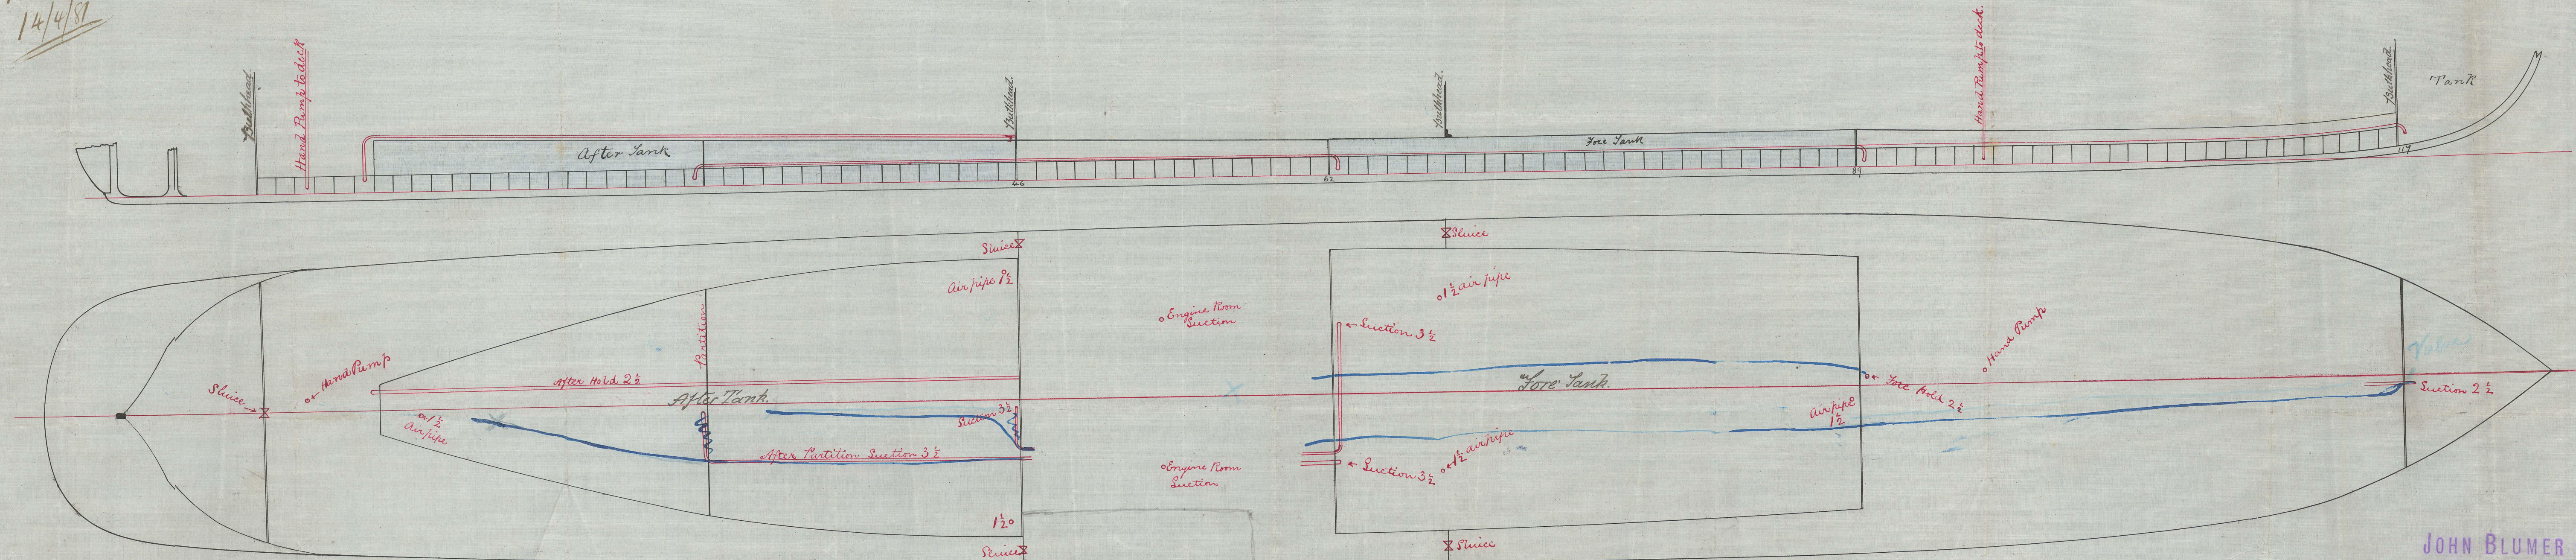

JOHN BLUMER & CO.  
IRON SHIPBUILDERS,  
(NORTH DOCK)

SUNDERLAND

April 11<sup>th</sup> 1881

Lloyd's Register  
Foundation