


Iron & Godalming Sunderland report No 12, 401

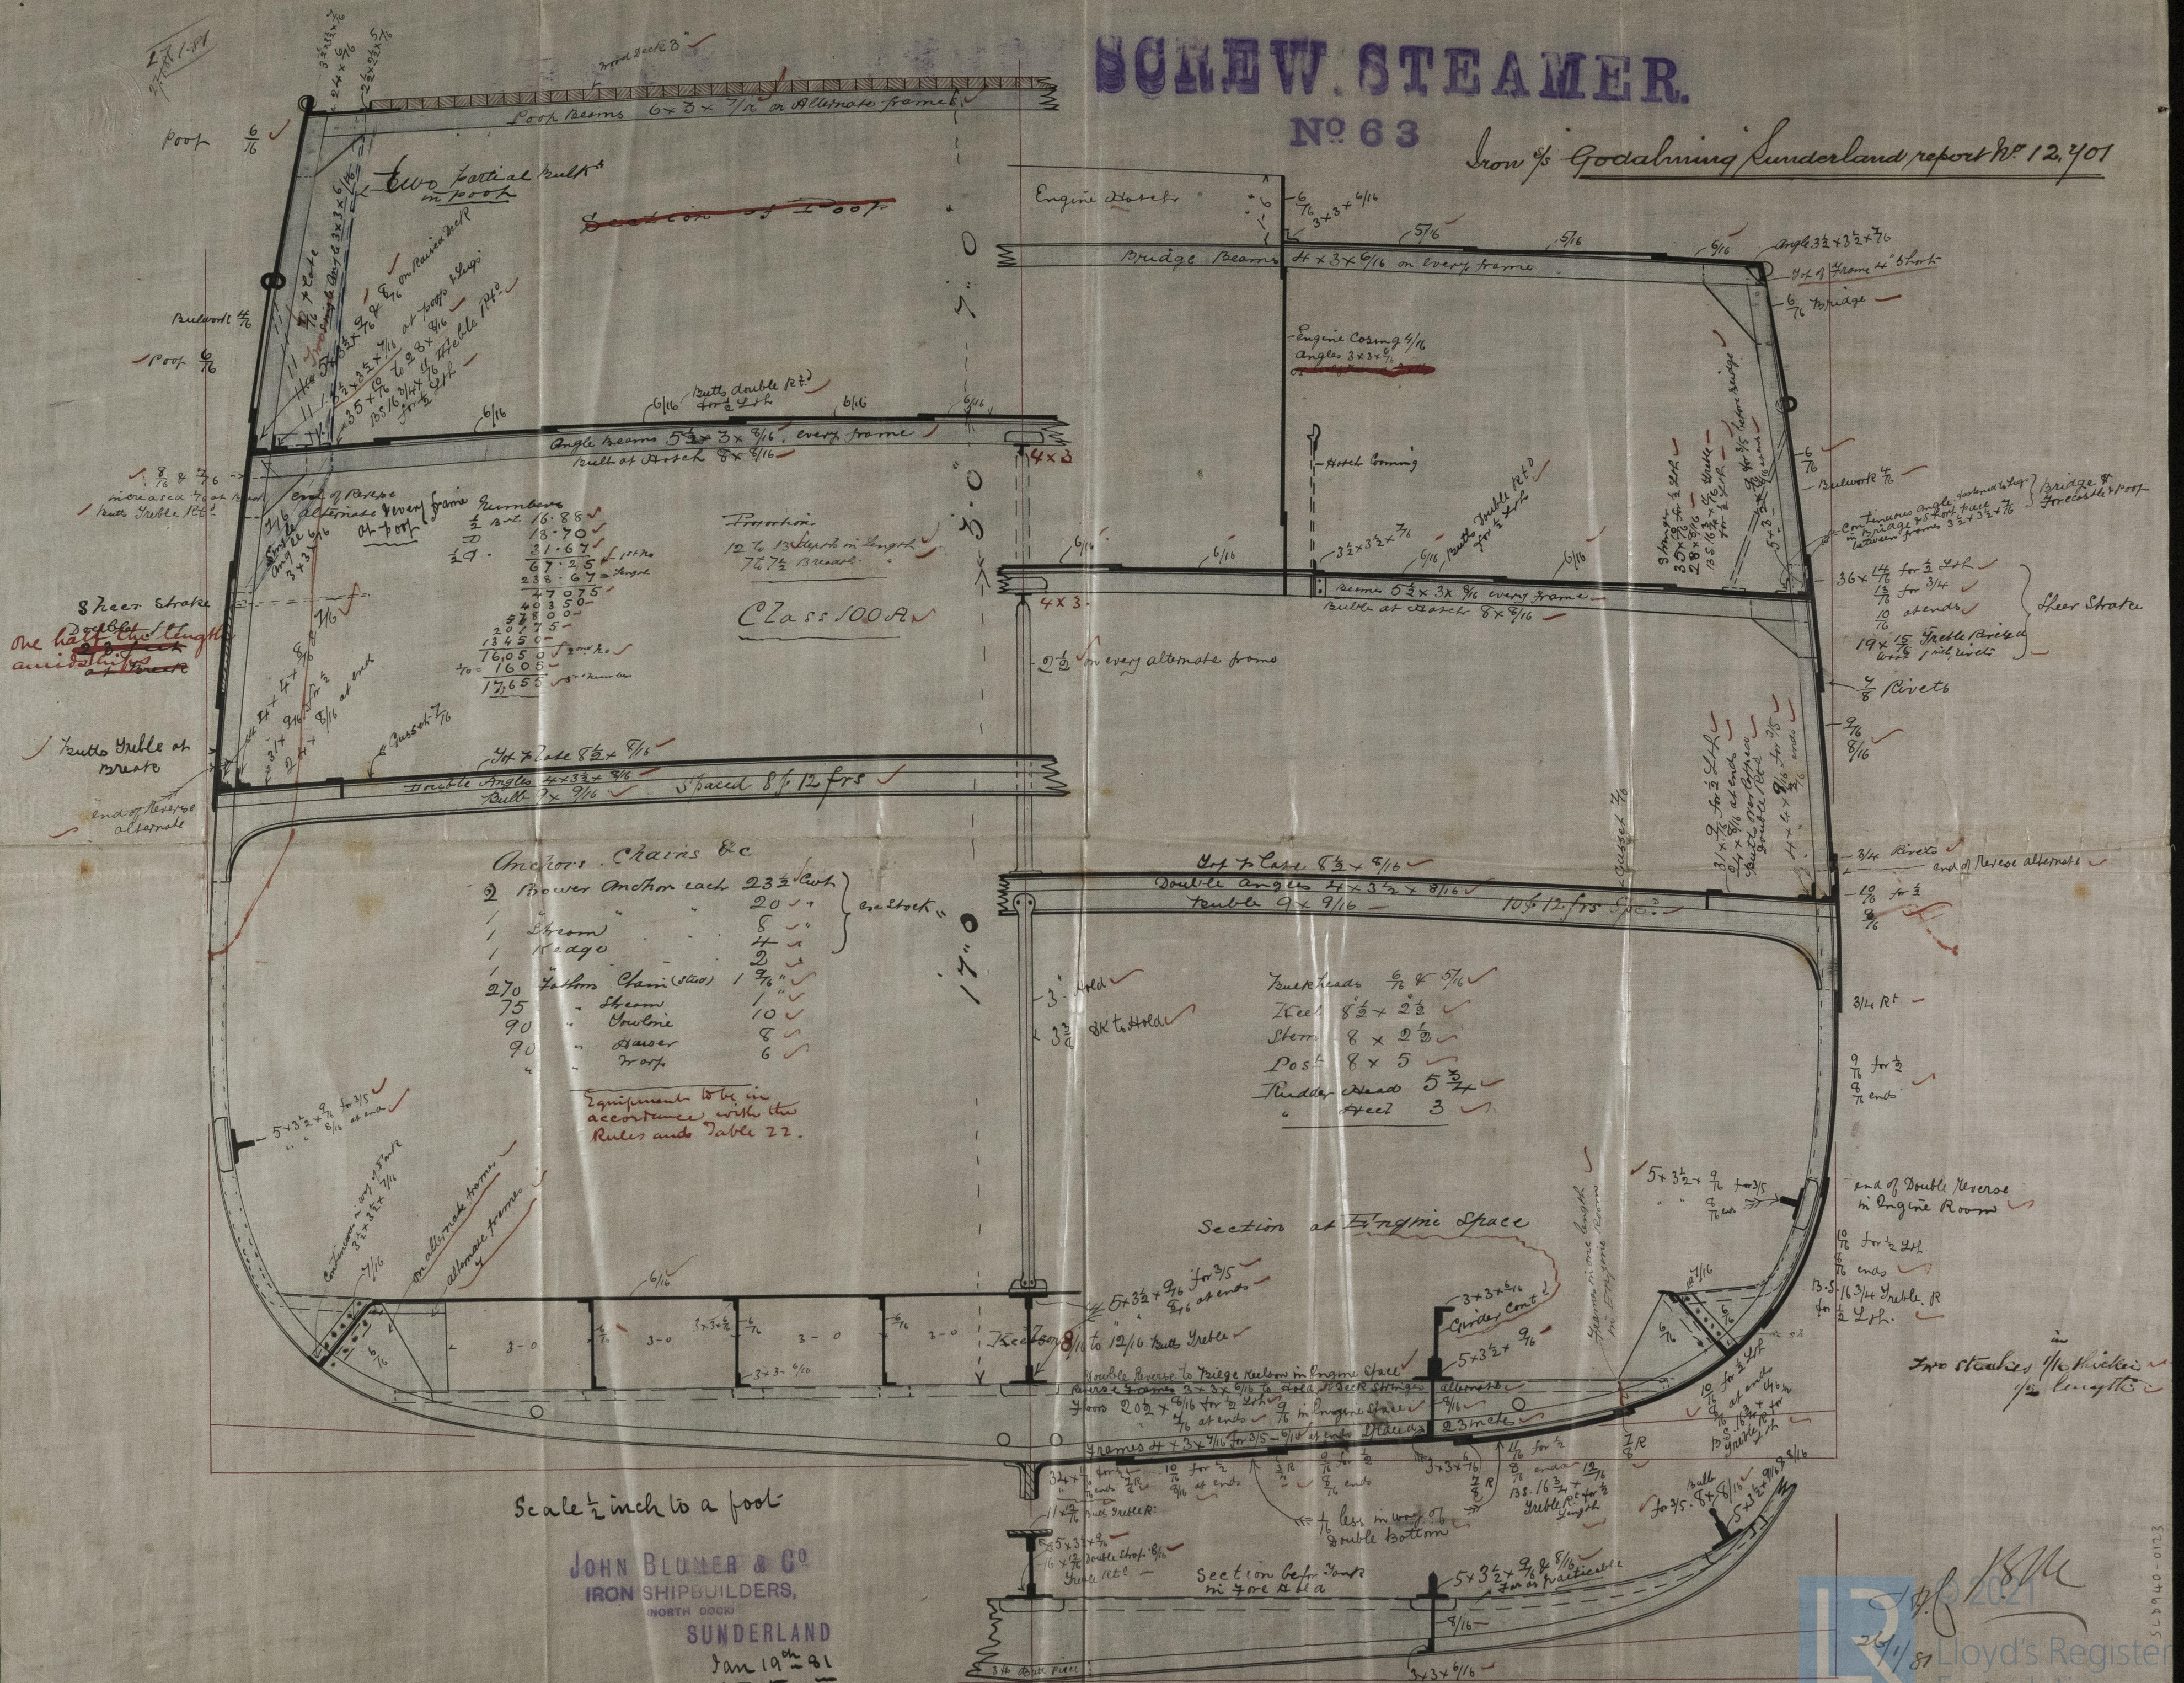

JOHN BLUMER & CO
IRON SHIPBUILDERS,
(NORTH DOCK)
SUNDERLAND
Jan 19th - 91