


Iron s/s 'Ada' Sld. report No 12430

ROBERT THOMPSON & SONS
IRON SHIP BUILDERS
FEB 16 81
SUNDERLAND

ROBERT THOMPSON & SONS
IRON SHIP BUILDERS
FEB 16 81
SUNDERLAND

GENERAL PLAN S.S. No 113


Scale $\frac{1}{8}$ = 1 FOOT

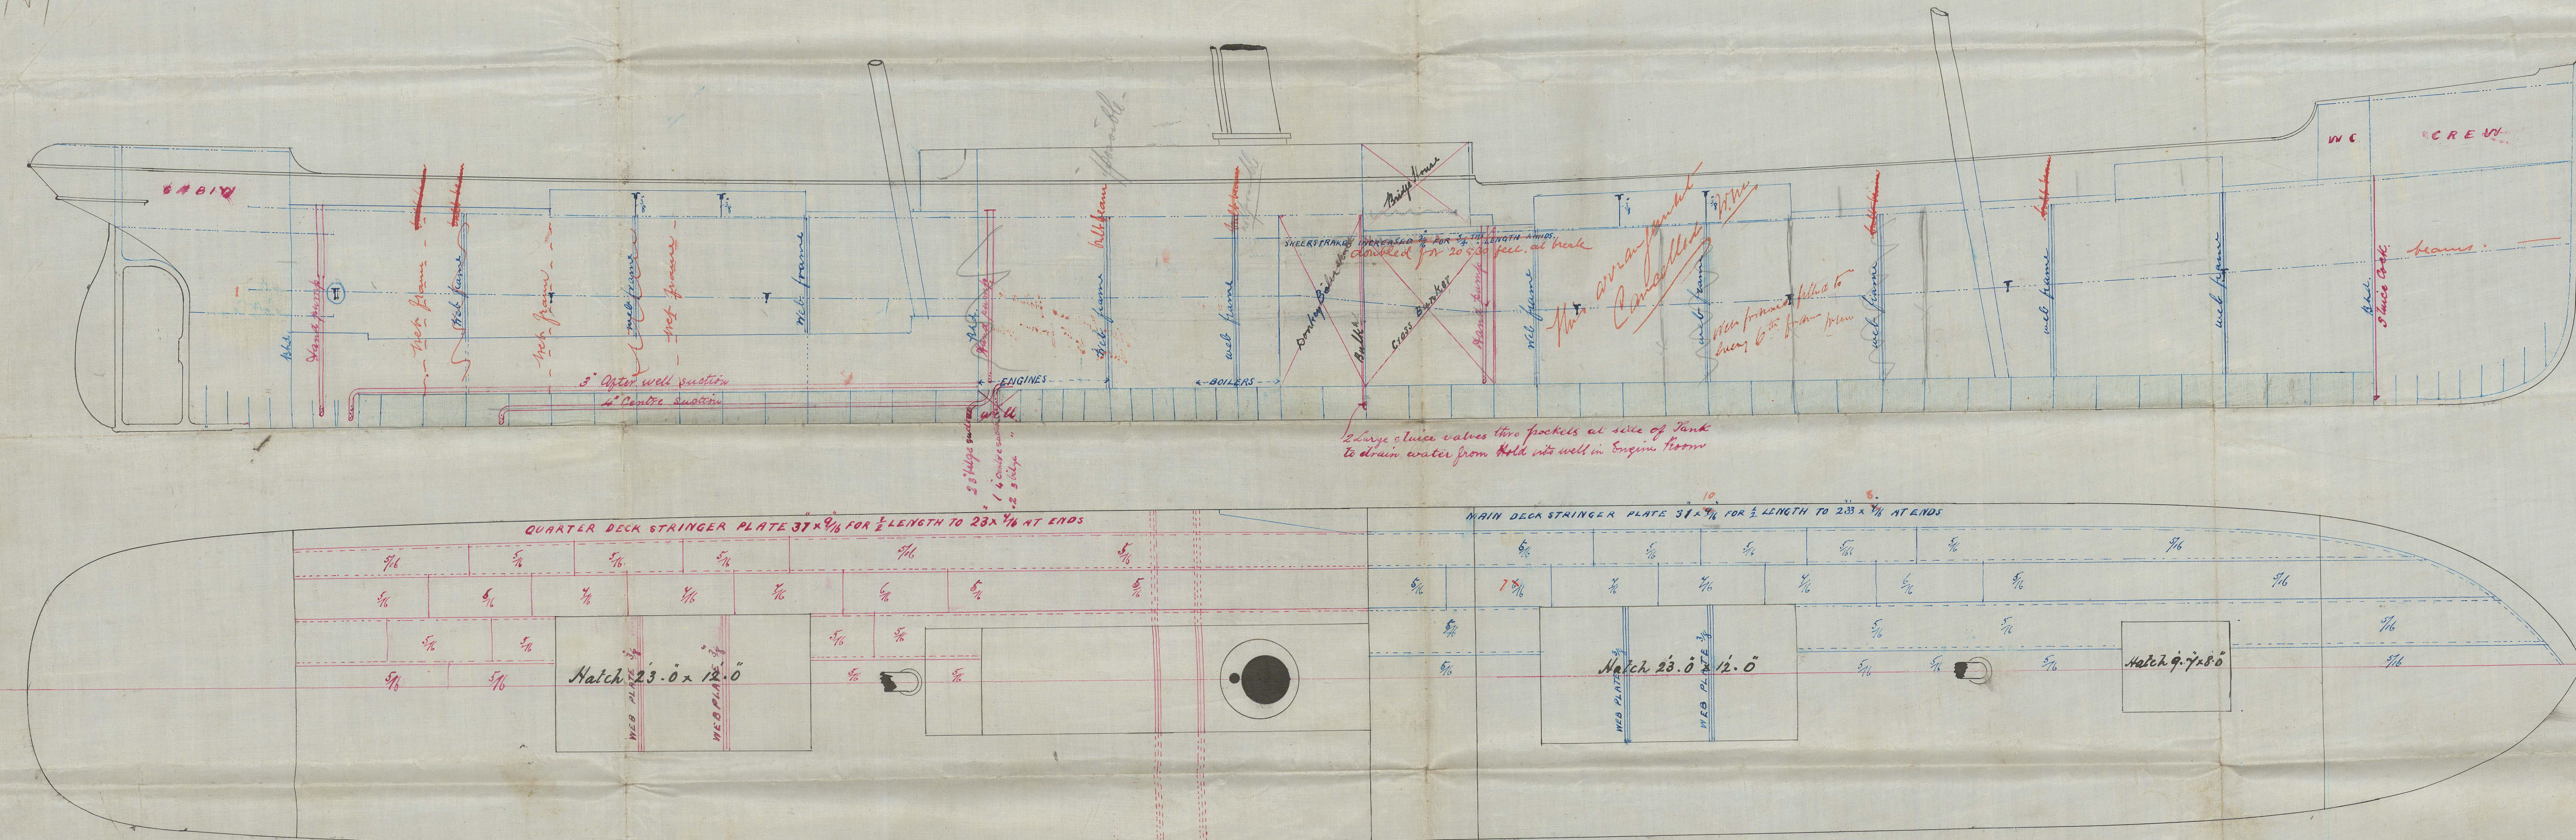


"Ada" Sund 12730.



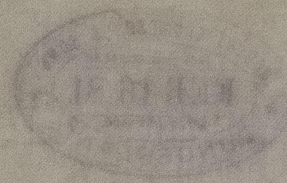

21/11/19

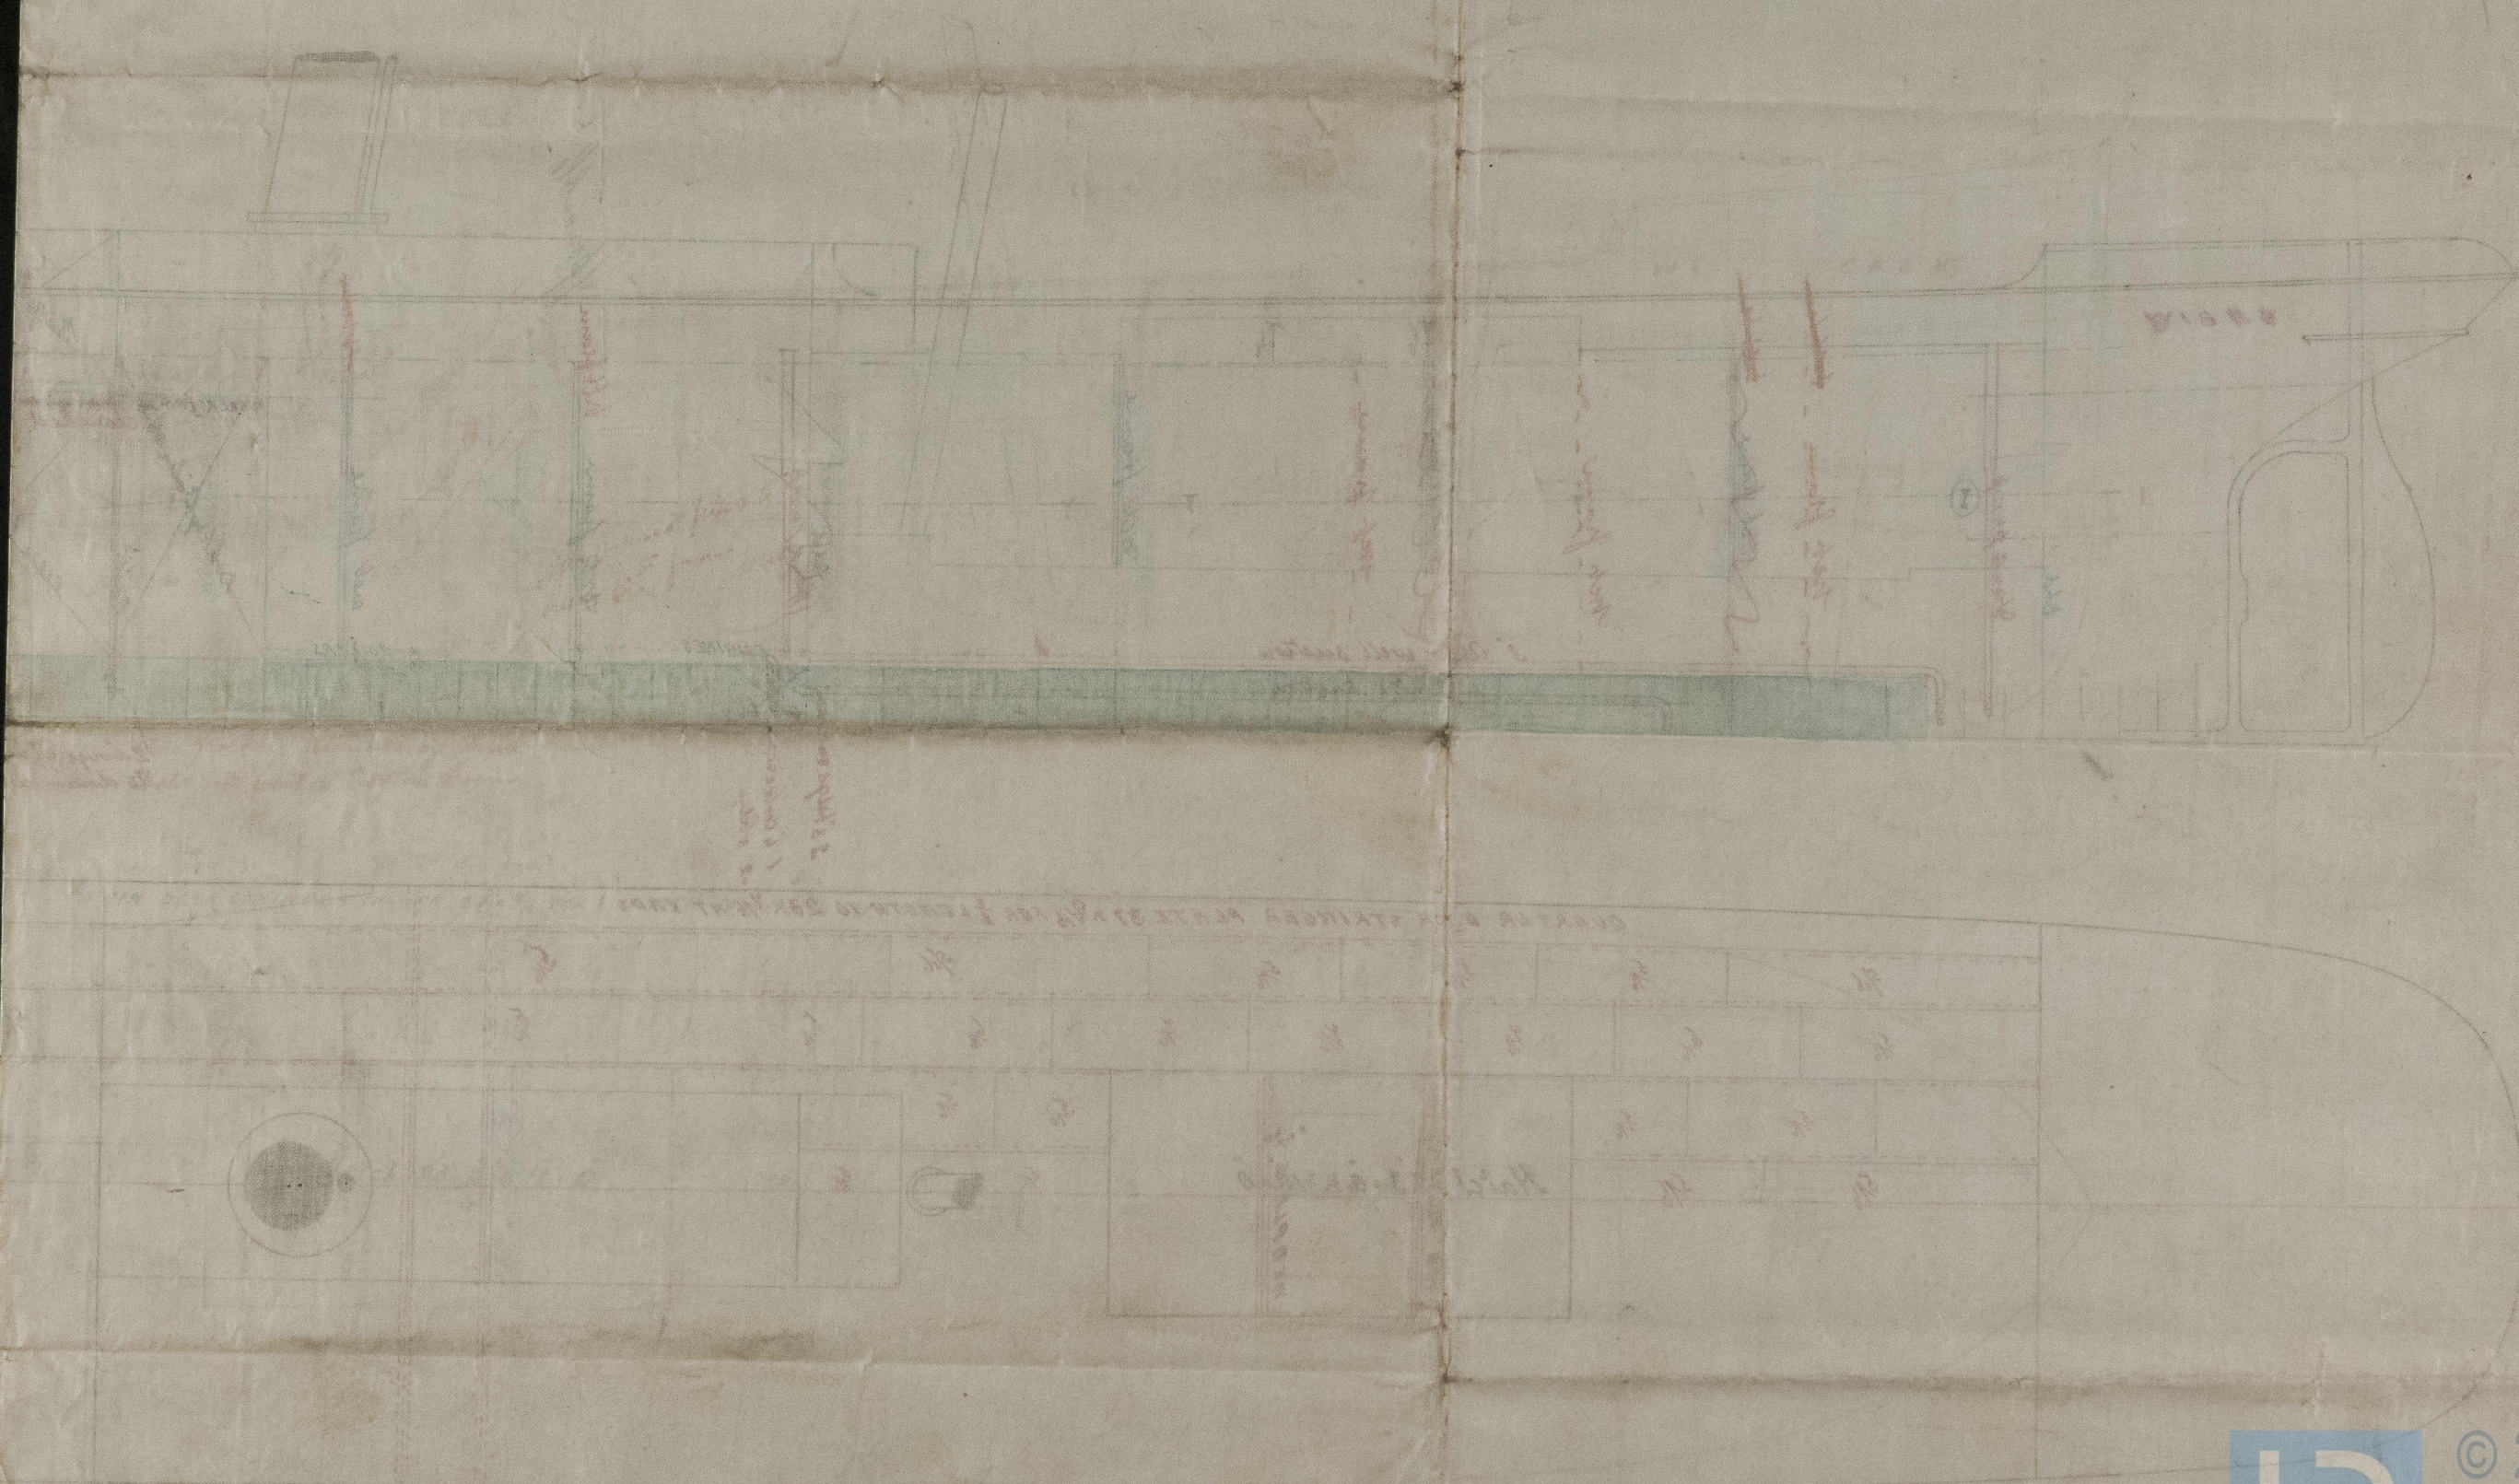

© 2021

Lloyd's Register Foundation

21/11/19