
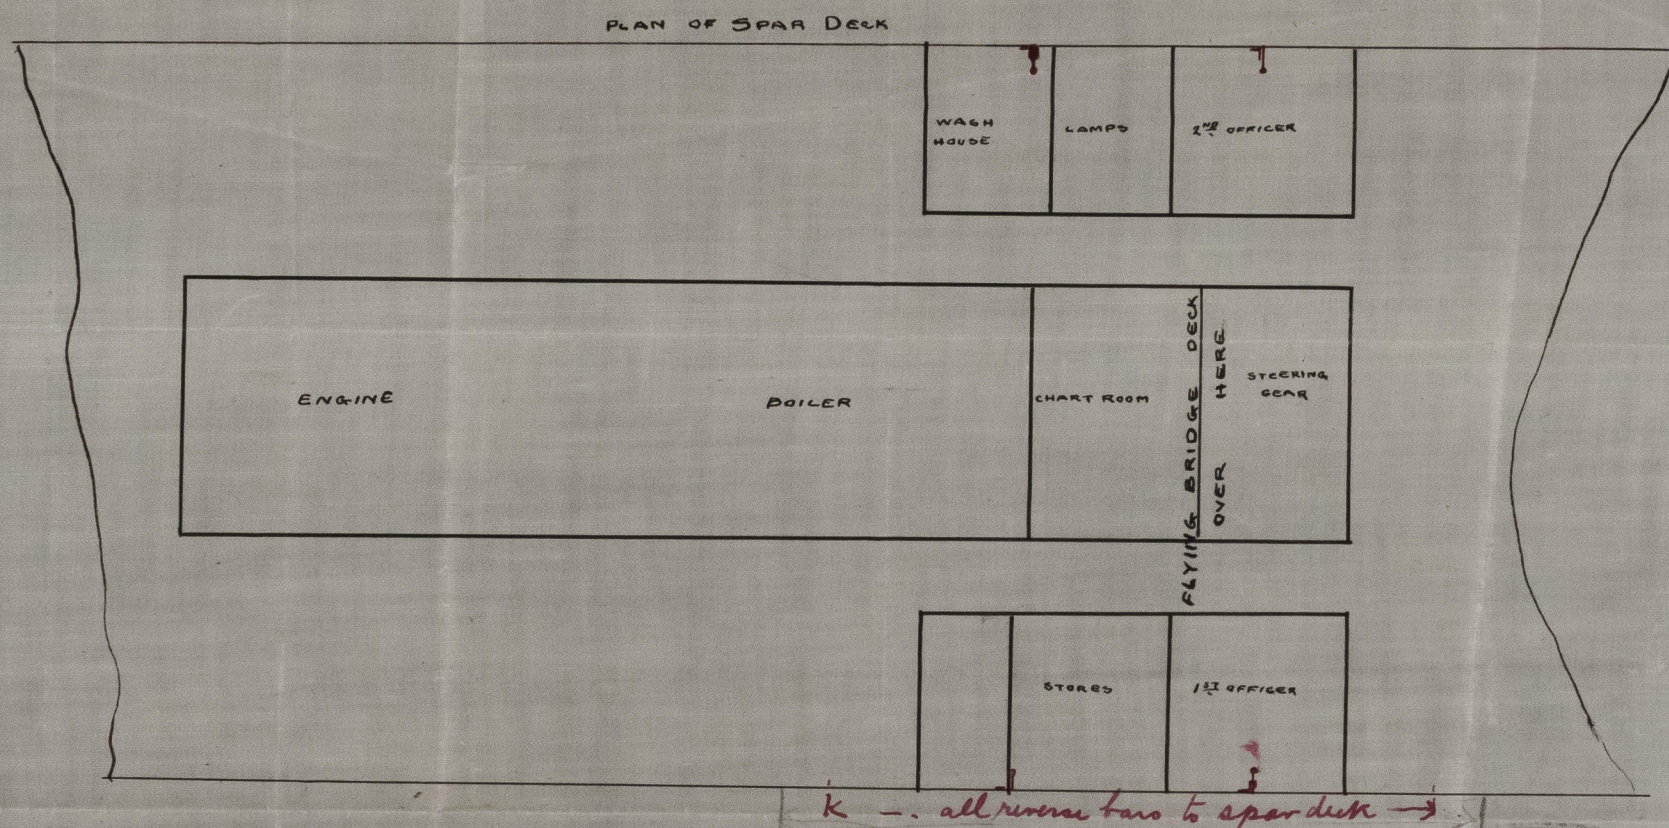


25.11.81


Row's Bongella's Sld. report No 12482

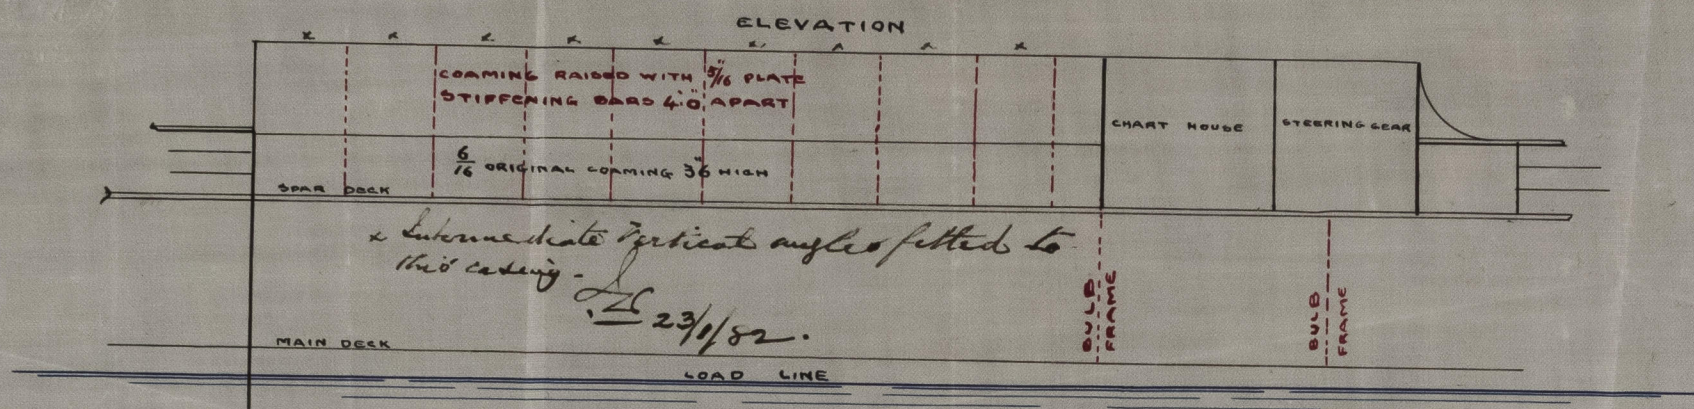

S.S. N^o 131

SKETCH SHEWING SIDE HOUSES & CASINGS
NOW
HEIGHTENED AS REQUIRED BY THE OWNERS

SCALE $\frac{1}{8}$ INCH = 1 FOOT

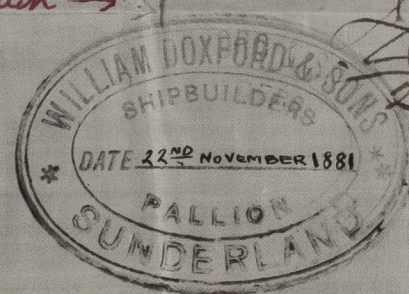

© 2021

Lloyd's Register
Foundation

SLD941-0111

24/11/81