

10.5.81

10.4.12
Stools 18 + 19
27 + 28
36 + 37
40-41-42-43-44
2-10-12 Port
state 1-12-13


SHIP-0115

15/5/81



S.S. No 131
SPAR DECKED
SCALE 1/8 OF AN INCH TO ONE FOOT

Iron 7/8 Bongella's Ltd. report No 12.482

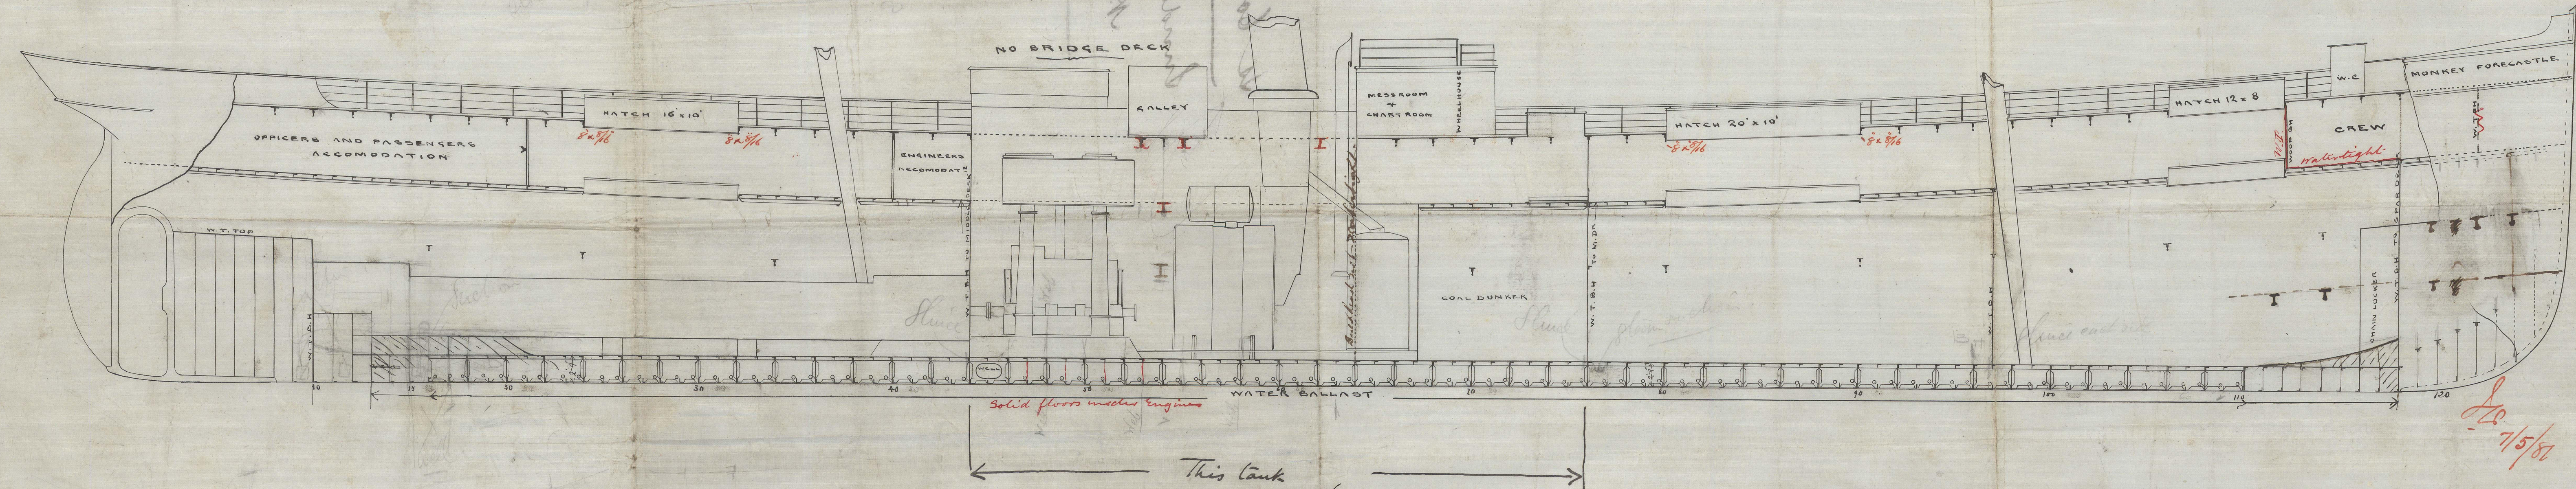

10/5/81



Is Congella

Sunderland

N^o 12782

SLB941-0112



© 2021

Lloyd's Register
Foundation