


Iron f. 'baerlock' Sl. report No. 12.989.

Profile

Showing Arrangement
of
HOLD STRINGERS HATCHES
No. 2. S. S

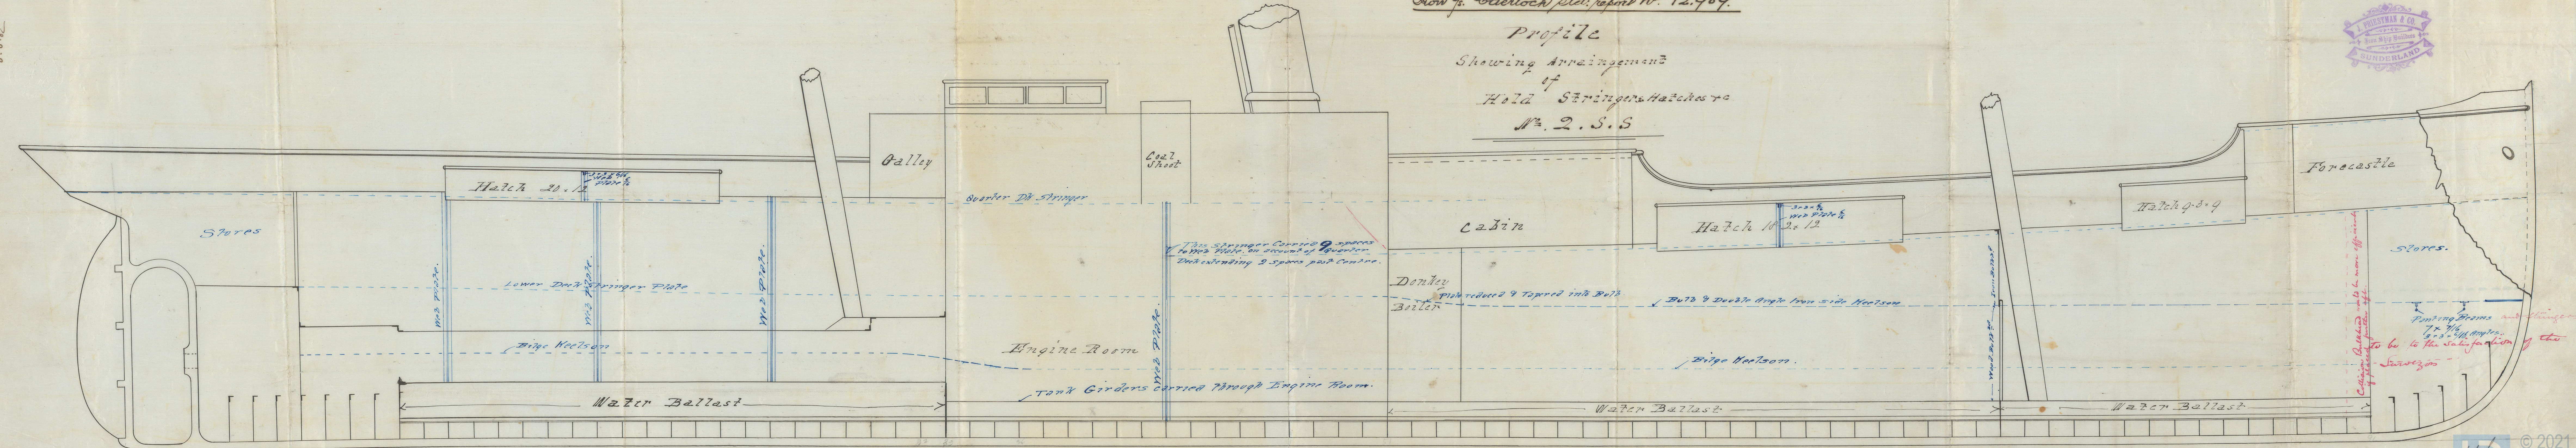

Stores.

Pointing Beams and string

$7 \times \frac{1}{16}$
 $3 \times 3 \times \frac{1}{16}$ Angles.

To be to the satisfaction of the

- Surveyors -

SLD943-0243